


AP 526184

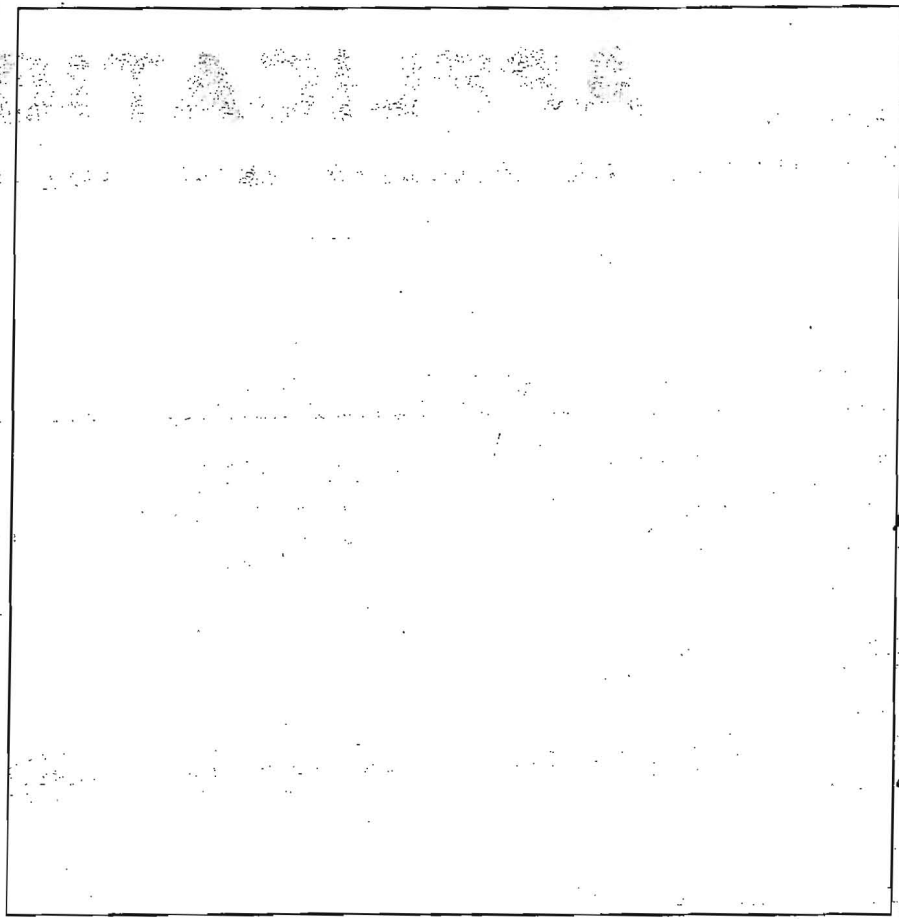

220

8" Bm L
RD Bm
gr CL
3' RD Bm
gr SIL
6.5' Saprolite
Bm FSL
Saprolite
13.5'

222

1' Bm L
RD Bm
gr CL
3' RD Bm
gr SIL
4' Bm
FSL
Saprolite

223

8" Bm L
RD Bm
gr CL
3.5' RD Bm
gr SIL
5.5' Bm
FSL
Saprolite

217
8" Bm L
RD Bm
gr CL
3' Bm gr
SIL
6' RD Bm
FSL
Saprolite
13'

218

9" Bm L
RD Bm
gr CL
3' RD Bm
gr SIL
5' Bm
FSL
Saprolite
13'

221

8" Bm L
RD Bm
gr CL
3' RD Bm
gr SIL
5' Bm
FSL
Saprolite
13'

DATE	TEST #	DEPTH	START	BREAK 1" DROP	STOP 2" DROP	TIME OF 2ND INCH	P/F/H
2/14/07	217	5' 13'	11:08	Pulled slow			
		6' 13'	11:57	11:58	12:12	14	P
	218	5' 13'	11:11	11:19	11:37	18	P
	221	5.5' 13'	12:04	12:22	12:45	23	P
	220	Visual					P
	222	5.5'					

REMARKS _____
 SANITARIAN _____ BACKHOE _____ OTHERS _____
 TEST HOLES USED IN SDA _____ AVG. PERC TIME _____ SQ. FT/BR _____
 TRENCH WIDTH _____ INLET DEPTH _____ MAX. BOT DEPTH _____ EFFECTIVE SW _____

12.5'

① 526184

224

1' BmL
 3' RDBm
 SiCL
 YellBm
 SiL
 5.5' RDBm
 FSL
 saprolite
 13'

225

1' BmL
 3.5' Bm
 SiCL
 RDBm
 SiL
 5.5' RDBm
 FSL
 saprolite
 12'

Holes dug Per plan
 shown on back side

DATE	TEST #	DEPTH	START	BREAK 1" DROP	STOP 2" DROP	TIME OF 2ND INCH	P/F/H
3/14/07	224	5.5' 13'	12:57	1:07	11:19	21	P
	225	5.5' 12'	12:59	1:18	>30	Pulled	
		6.5' 12'	2:10	2:11	2:13	2	P

REMARKS _____

SANITARIAN at

BACKHOE Justin (Level 1 and)

OTHERS Jeremy Putter

TEST HOLES USED IN SDA _____

AVG. PERC TIME _____

SQ. FT/BR _____

TRENCH WIDTH _____

INLET DEPTH _____

MAX. BOT DEPTH _____

EFFECTIVE SW _____

POLE
#551088

N08°34'57"E
351.45'

GUY
WIRE

S80°55'03"E

ChB2

ROAD

DAVIS PROPER PERC PLAN

G1C3 G2B2

CABLE
BOX

N08°52'44"E
295.82'

N08°56'00"E
198.00'
R=1640.36' A=1

AN

ORIGINAL (NW)


NE

R

GRA

200

CUB

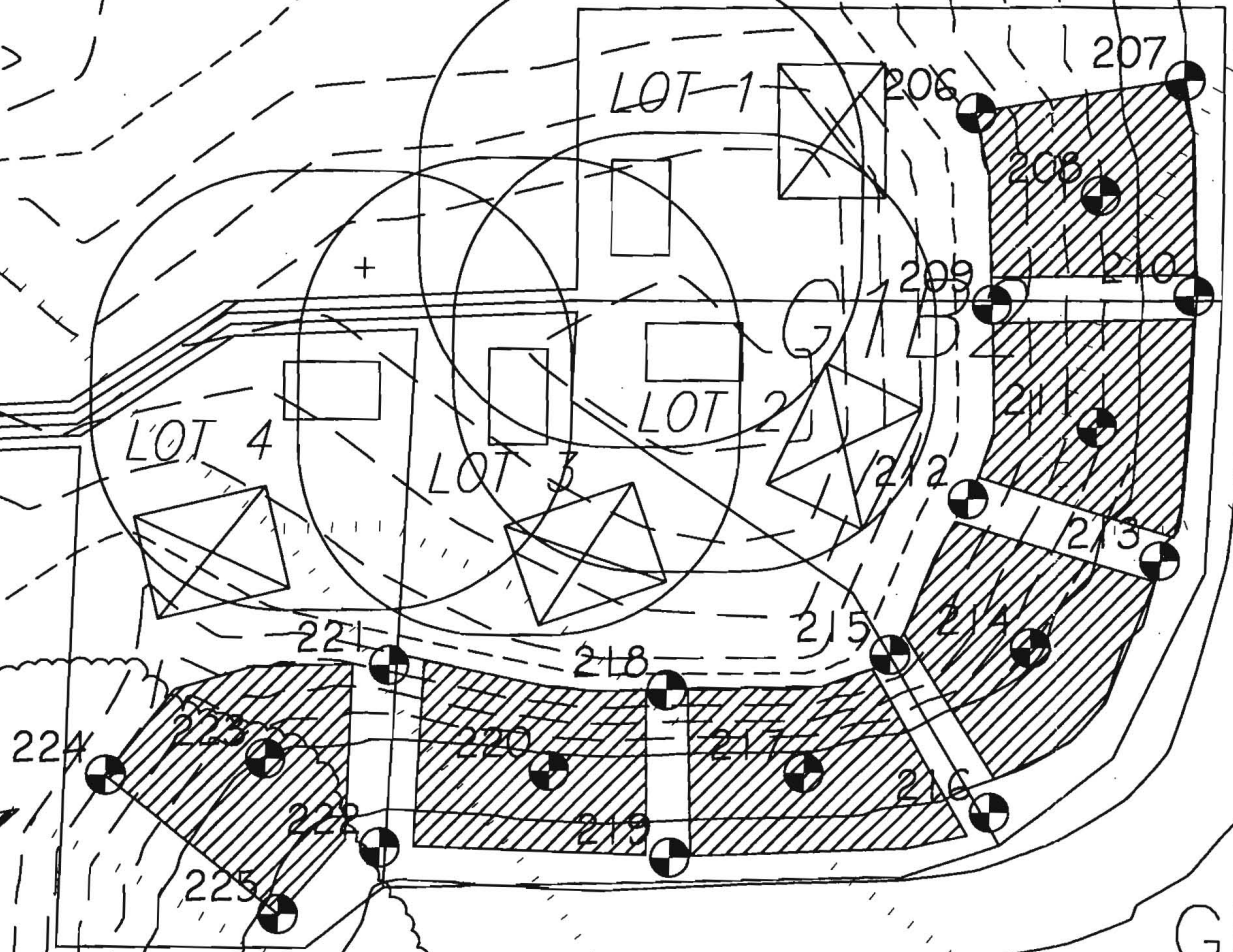


351.45

STATION ROAD

GIB2
GIC3 GIB2

WIRE PER

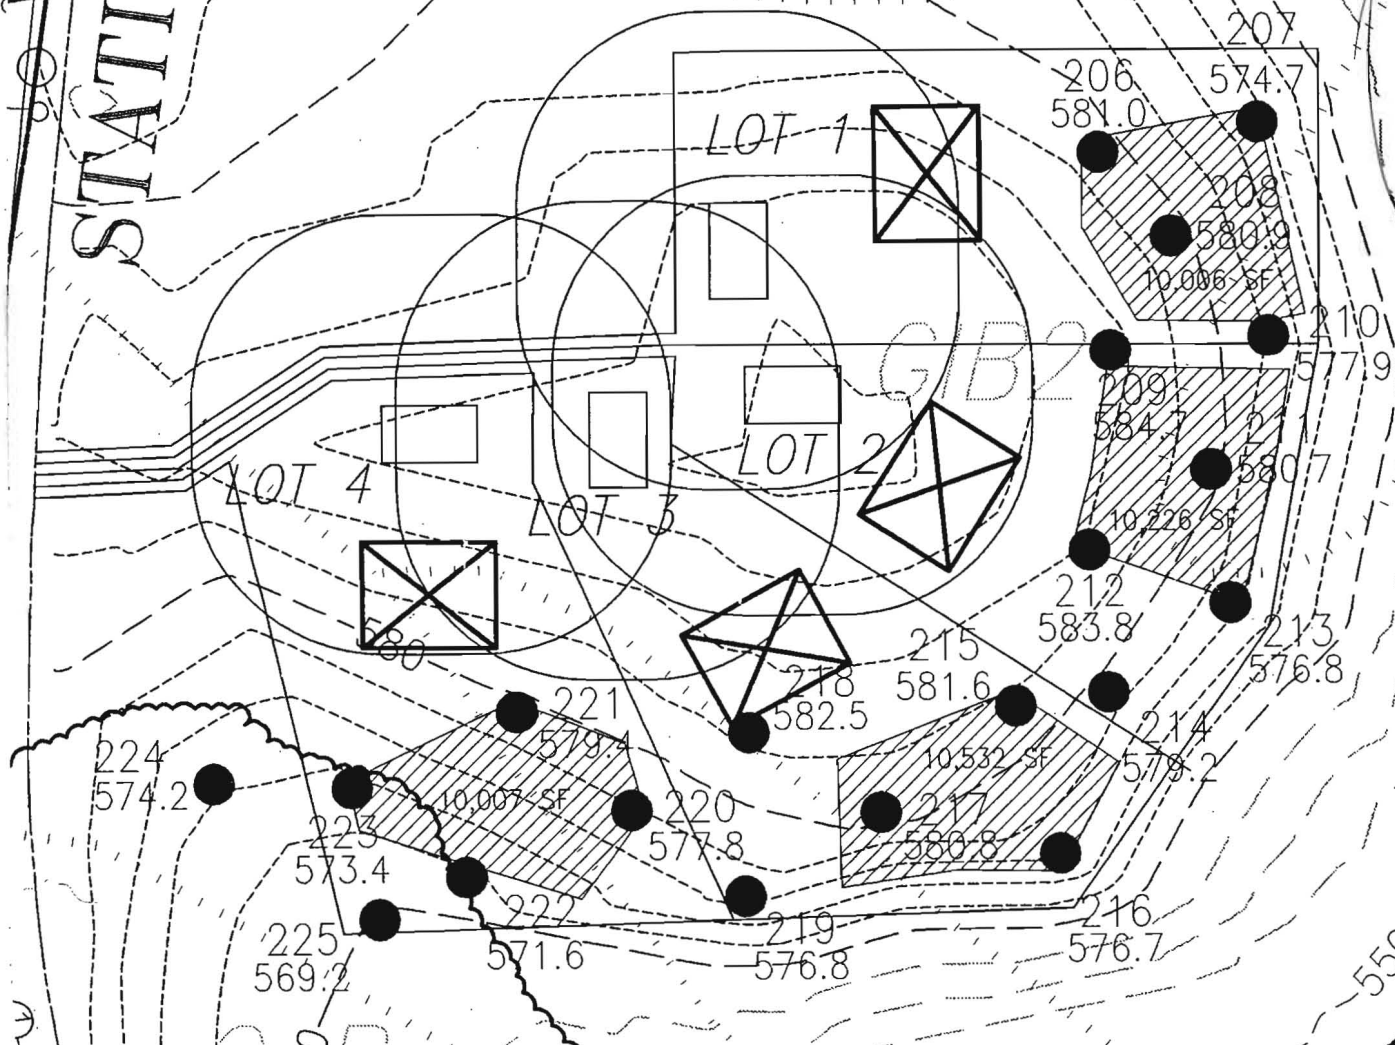

copy of signed
PC 10/5/07

PARCE

TAX MAP 8

MORGAN STATION ROAD

ROBERT H

L.6623 F.300, I

2,575,582 S.F. o

f3