

*4/20/82
as soon as possible
final*

PERMIT

*1st approved
7-20-82
CW*

P 32037

SEWAGE DISPOSAL SYSTEM

A REPAIR

MARYLAND STATE DEPARTMENT OF HEALTH

HOWARD COUNTY

7/19/82

ELLICOTT CITY

DISTRICT _____

INDEX

DATE July 16, 1982

Jack Fyock

IS PERMITTED TO INSTALL

ALTER X

ADDRESS 13775 Triadelphia Road, Glenelg, Md. 21737

PHONE 988-9270

SUBDIVISION _____ ROAD 13631 Nichols Dr.

LOT _____

PROPERTY OWNER Mr. Ed Steel (286-3577)

*off Brighton Dam Rd
& Rt. 216*

ADDRESS 13631 Nichols Dr., Laurel, Md.

SPECIFICATIONS 3 BED ROOMS

SEPTIC TANK CAPACITY _____ GALLONS

DRAIN FIELD _____ DEPTH _____ FEET, BOTTOM AREA _____ SQ. FT.

DEEP TRENCH _____ DEPTH _____ FEET, BOTTOM AREA _____ SQ. FT.

SEEPAGE PITS _____ ABSORBENT SIDE-WALL AREA _____ SQ. FT.

INLET PIPE _____ FT. BELOW ORIGINAL GRADE. MAXIMUM DEPTH _____ FT. BELOW ORIGINAL GRADE

EFFECTIVE DEPTH AT _____ FT. BELOW ORIGINAL GRADE.

LOCATE DISPOSAL AREA _____ FT. FROM _____ LOT LINE AND _____ FT. FROM _____ LOT LINE AS SEEN WHEN FACING LOT FROM

REPAIR - Call for inspection when ground is opened up so sanitarian can recommend repair.

60 FT LONG 7 FT STONE 2 FT WIDE

PLACE OFF OLD TANK RUN AWAY FROM RIGHT SIDE OF HOUSE

PLANS APPROVED BY Palmer F. Wine

DATE July 16, 1982

COVER NO WORK UNTIL INSPECTED AND APPROVED.

NEITHER THE HOWARD COUNTY COUNCIL NOR THE HEALTH DEPARTMENT IS RESPONSIBLE FOR THE SUCCESSFUL OPERATION OF ANY SYSTEM.

NOTE: IF TRENCH IS USED CALL FOR INSPECTION BEFORE PLACING GRAVEL IN TRENCH.

NOTE: NO DRY WELL SHALL EXCEED 15 FOOT IN DIAMETER.

NOTE: ALL PIPE FROM HOUSE TO DISPOSAL AREA MUST BE CAST IRON.


PERMIT VOID AFTER THREE YEARS.

NOTE: INSTALL STAND PIPE ON SEPTIC TANK AND DRY WELL. STAND PIPES MUST BE 6 INCHES IN DIAMETER. CAST IRON, CONCRETE OR TERRA COTTA ACCEPTED.

***INSTALLER IS RESPONSIBLE FOR OBTAINING FINAL APPROVAL ON THIS PERMIT.**

BLDG. PERMITS DIVISION
AND RETURNED 9/28/2000
B00126481 DETACHED GARAGE

X P 32037

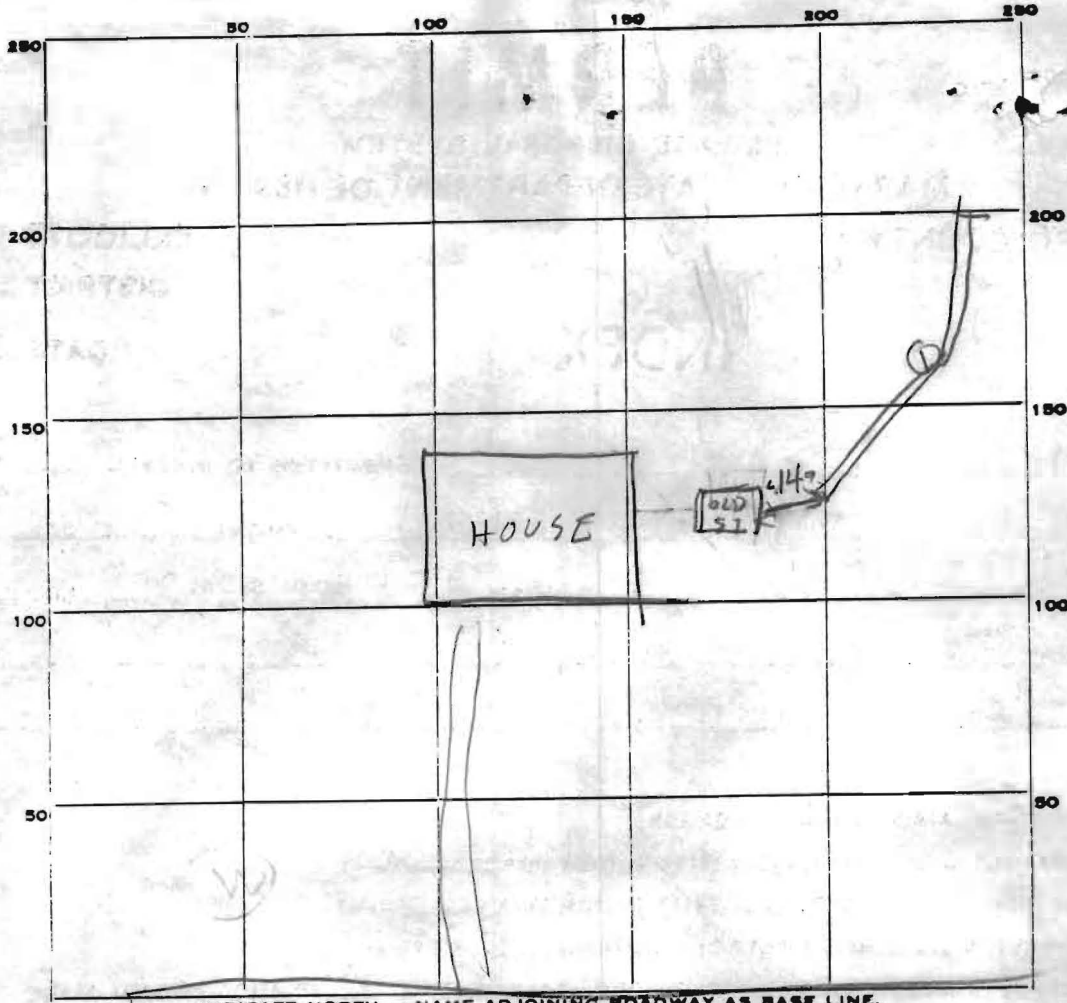

PERMIT CARD _____

SEPTIC TANK, LEVEL _____ CLEANOUTS _____

DISTRIBUTION BOX, LEVEL _____

TILE FIELD, DEPTH 11 FT. TRENCH WIDTH 2 FT.

GRAVEL DEPTH 7ft+ IN. TOTAL LENGTH 30 65 FT.

NUMBER OF TRENCHES 1 TOTAL BOTTOM AREA 450

SEEPAGE PITS, INSIDE DIAMETER _____ FT. DEPTH BELOW INLET _____ FT.

ABSORBENT AREA 450 SQ. FT.

REMARKS 7/19/82^{AM} DEEP DITCH 39 FT LONG & 11 FT DEEP
EXCEPT FOR VISUAL HOLE ①, SEE SPECS
OK TO STONE 155 30 FT OF DITCH
7/19/82^{130 PM} - BEST OF DITCH DUG & SOME STONE ADDED
FINISH ADDING STONE & PIPE TO DITCH & CALL RIT
7/20/82 OK TO COVER ALL WORK

DATE SYSTEM APPROVED 7/20/82 INSPECTOR CW Ellison