

Preliminary
12/28/76
9:30 A.M.
4 holes
10,000

APPLICATION

A 24611

SEWAGE DISPOSAL TESTING

P _____

STATE OF MARYLAND - DEPARTMENT OF HEALTH AND MENTAL HYGIENE

HOWARD COUNTY HEALTH DEPARTMENT
ENVIRONMENTAL HEALTH SERVICES
P. O. BOX 476, ELLICOTT CITY, MARYLAND 21043
TELEPHONE: 465-5000, EXT. 356

DISTRICT 5th

DATE Oct. 27, 1976

TO: THE COUNTY HEALTH OFFICER
ELLICOTT CITY, MARYLAND

I, HEREBY, APPLY FOR THE NECESSARY TEST IN ORDER TO CONSTRUCT (OR RECONSTRUCT) A SEWAGE DISPOSAL SYSTEM.

PROPERTY OWNER Mr. Bokkil & Mrs. Jung Suk Chung

ADDRESS 5600 32th Street, N.W., Washington, D.C. 20015 PHONE 363-8242

PROPERTY LOCATION:

SUBDIVISION Nichols Drive LOT NO. _____

ROAD AND DESCRIPTION tar and chip road, Nichols Drive; 3 acres consisting of parcels no. 114 and 216; Liber 514 Folio 665 and Liber 514 Folio 663

SIZE OF LOT 3 acres TYPE BLDG. Residential
NUMBER OF BEDROOMS _____

IF NOT SINGLE RESIDENCE DESCRIBE _____

THE SYSTEM INSTALLED UNDER THIS APPLICATION IS ACCEPTABLE ONLY UNTIL PUBLIC FACILITIES BECOME AVAILABLE.

SIGNATURE OF APPLICANT Clinton J. Haught CLINTON J. HAUGHT
R. E. STRIMEL REAL ESTATE 596-5535

APPROVED BY _____ FOR _____ DATE _____
(KIND OF SYSTEM)

REJECTED BY J. Stayer FOR _____ DATE 5/1/79
(KIND OF SYSTEM)


HOLD PENDING FURTHER TESTS _____ DATE _____

REASONS FOR REJECTION OR HOLDING Soil would not perc. Water in lower half of property

THIS IS NOT A PERMIT

NICHOLS DR.

Profile
0-12 ft
clay
1100, 1100

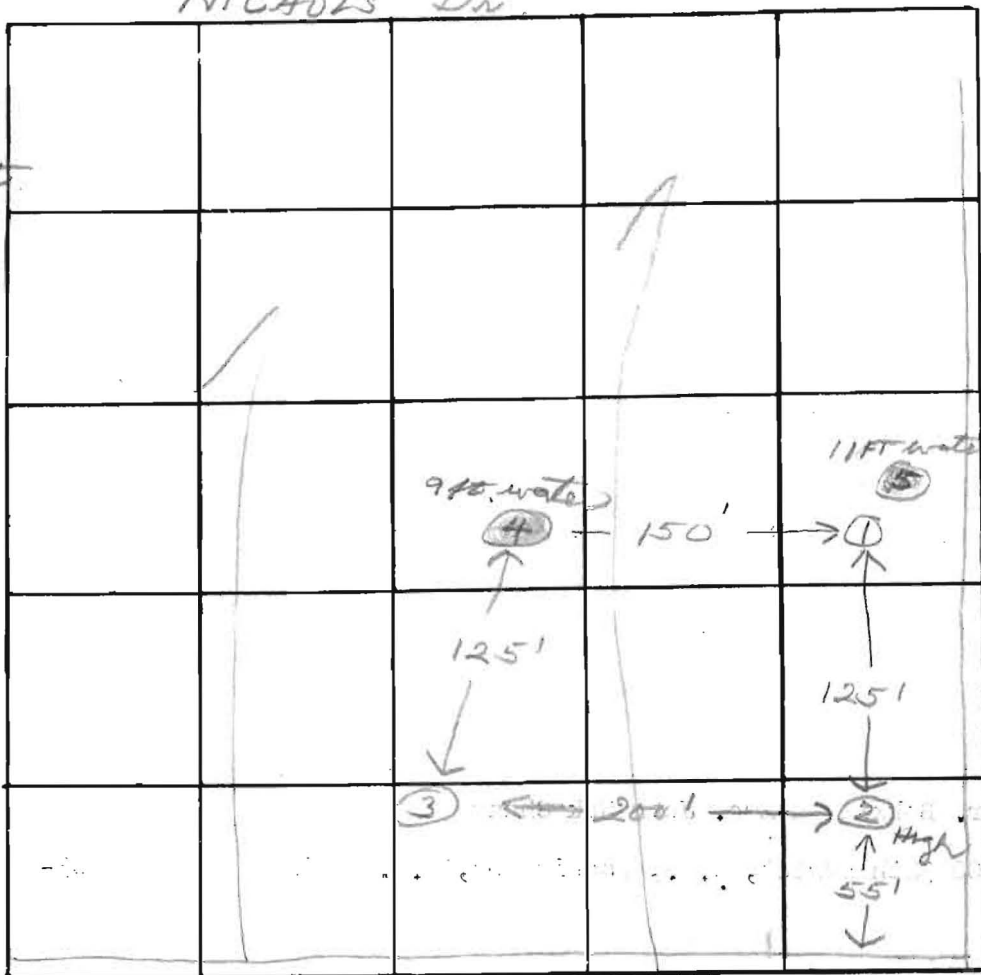

INDICATE NORTH. - NAME ADJOINING ROADWAY AS BASE LINE

DATE	TEST NO.	DEPTH	PRE-WET		TEST - 1" DROP		TIME
			START	STOP	START	STOP	
4/30/79	1 S	3	10:08	10:45	1/2"		Failed
	1 M	7	10:07	10:45	1/2 drop		
	2 D	13	10:50	11:04	11:04	2nd 1"	Failed
	3 S	4	11:03		1/4"		Failed
	3 M	8	11:06			11:45	
	4	9	water				
	5	11	water				

REMARKS _____

TYPE OF SOIL _____

TESTED BY [Signature] ALSO PRESENT: D. Parlette

Mr. Johnson
Mr. Haught