

3/11/92
10:00

APPLICATION

PERCOLATION TESTING

A 47771

P _____

HOWARD COUNTY HEALTH DEPARTMENT
BUREAU OF ENVIRONMENTAL HEALTH
P.O. BOX 476 ELLICOTT CITY MARYLAND 21043
TELEPHONE 461-9933

DISTRICT _____

DATE 1/28/92

1-27-92
Previous ok. Wet season
required. JEN

TO: THE COUNTY HEALTH OFFICER
ELLICOTT CITY, MARYLAND

I, HEREBY, APPLY FOR THE NECESSARY TEST IN ORDER TO CONSTRUCT (OR RECONSTRUCT) A SEWAGE DISPOSAL SYSTEM.

PROPERTY OWNER DONALD AND JUDITH PROIA

ADDRESS 13630 Nichols Dr Clarksville MD 21029 PHONE 301 8540244

PROSPECTIVE BUYER _____

ADDRESS _____ PHONE _____

PROPERTY LOCATION:

SUBDIVISION Clifton Link LOT NO E 1A

ROAD AND DESCRIPTION Nichols Drive off Highland Road - resubdivision of lot 1

TAX MAP 34 PARCEL # 368

SIZE OF LOT 9.435 Acres TYPE BLDG SFD
(SINGLE FAMILY DWELLING OR COMMERCIAL)

THE SYSTEM INSTALLED UNDER THIS APPLICATION IS ACCEPTABLE ONLY UNTIL PUBLIC FACILITIES BECOME AVAILABLE. I FULLY UNDERSTAND THE FEE CONNECTED WITH THE FILING OF THIS PERC TEST APPLICATION IS NON-REFUNDABLE UNDER ANY CIRCUMSTANCES. I ALSO AGREE TO COMPLY WITH ALL M.O.S.H.A. REQUIREMENTS IN TESTING THIS LOT.

(SIGNATURE OF APPLICANT)

APPROVED BY _____ FOR _____ DATE _____

REJECTED BY _____ FOR _____ DATE _____

HOLD PENDING FURTHER TESTS _____ DATE _____



REASONS FOR REJECTION OR HOLDING _____

HD-216

THIS IS NOT A PERMIT


Hole A

S SOIL PROFILE N

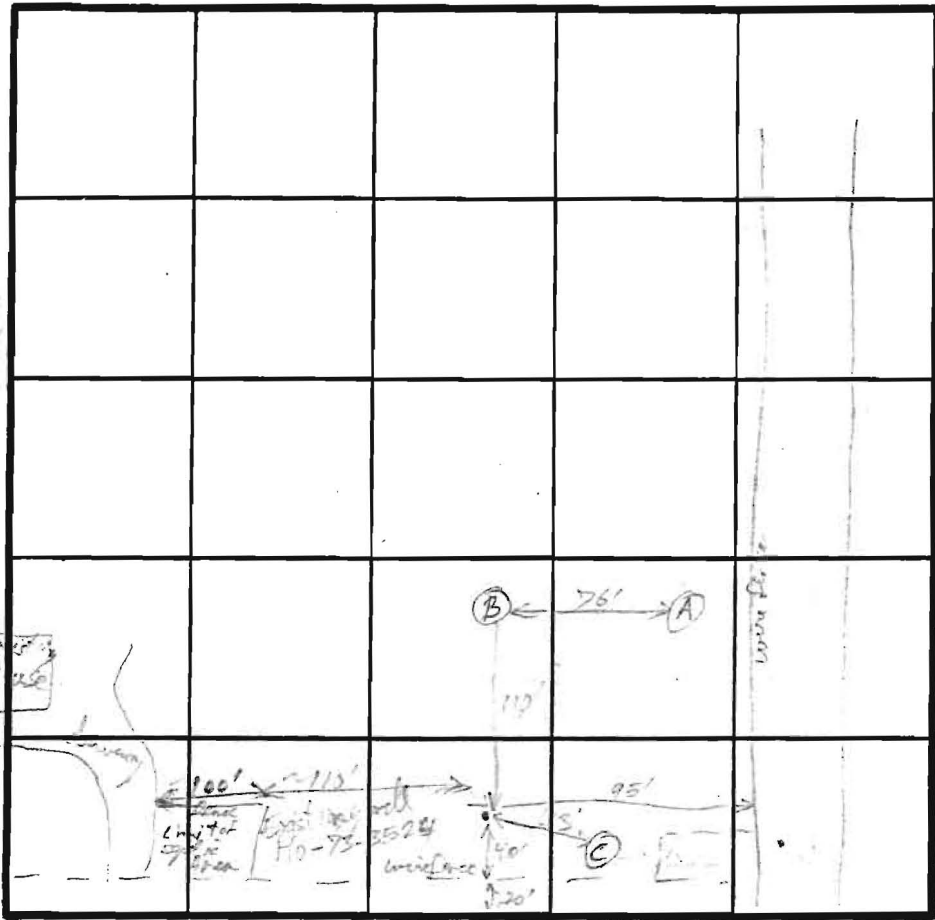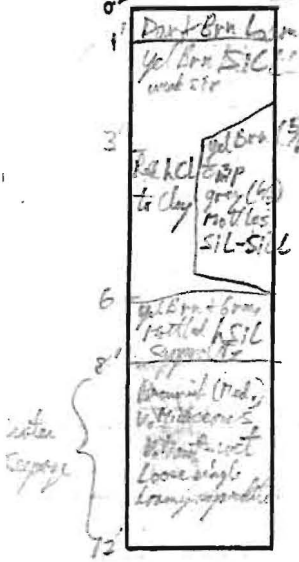

INDICATE NORTH - NAME ADJOINING ROADWAY AS BASE LINE.

Hole C

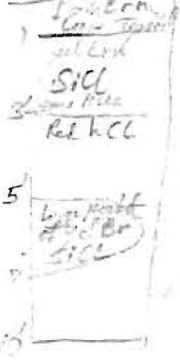

DATE	TEST NO.	DEPTH	PRE-WET		TEST - 1" DROP		TIME
			START	STOP	START	STOP	
3-11-92	A	Not tested	North Side	from main road	7 1/2 ft	12 ft	5 ft
	B	@ 6 1/2 12 1/2	11:30:00	12:01	12:01	12:31	5 min
	C	@ 4 1/2 10 1/2	11:30:00	12:10			5 min


REMARKS: [Handwritten notes]

TYPE OF SOIL: [Handwritten notes]

TESTED BY: [Handwritten name]

ALSO PRESENT: [Handwritten name]

Hole B

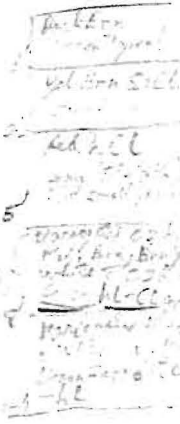

14314 Roxbury Meadow Dr.
Lot 18 Clarks Meadow

remove 15 foot trench
(OK)

ILR and be 1.2
also sidewalk early 25, not 2



HOWARD COUNTY HEALTH DEPARTMENT

Joyce M. Boyd, M.D., County Health Officer

January 28, 1992

Reply to:

✓ Mr. and Mrs. Donald Proia
13630 Nichols Drive
Clarksville, Maryland 21029

RE: Percolation Testing
Clifton Link Property
Resubdivision of Lot 1

Dear Mr. and Mrs. Proia:

A percolation test date has been reserved for 10:00 a.m., Wednesday, March 11, 1992.

You will be responsible for having a contractor on-site to excavate test holes at the corners of proposed percolation area.

Please call this office between 8:30 a.m. and 4:30 p.m. . Monday through Friday, to confirm your acceptance of this percolation test date.


Thank you for your cooperation in this matter.

Very truly yours,


Craig Williams; Program Director
Water and Sewerage Program

CW:jr

PROIX Property
13630 Nichols Dr

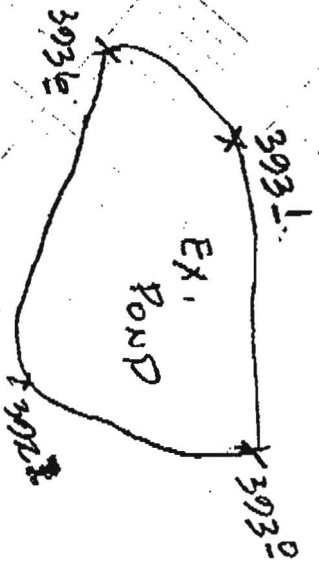


If submission testing is successful existing well will be abandoned and relocated per health dept approval
11-7-11

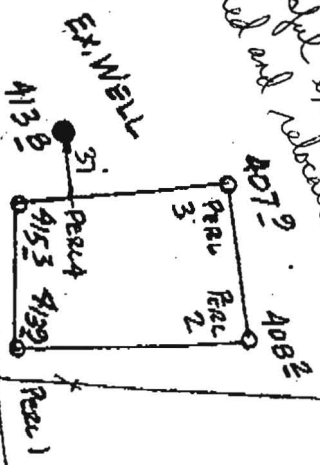

FIELD LOCATION OF
EXISTING WELL, ROAD

NICHOLS

181044

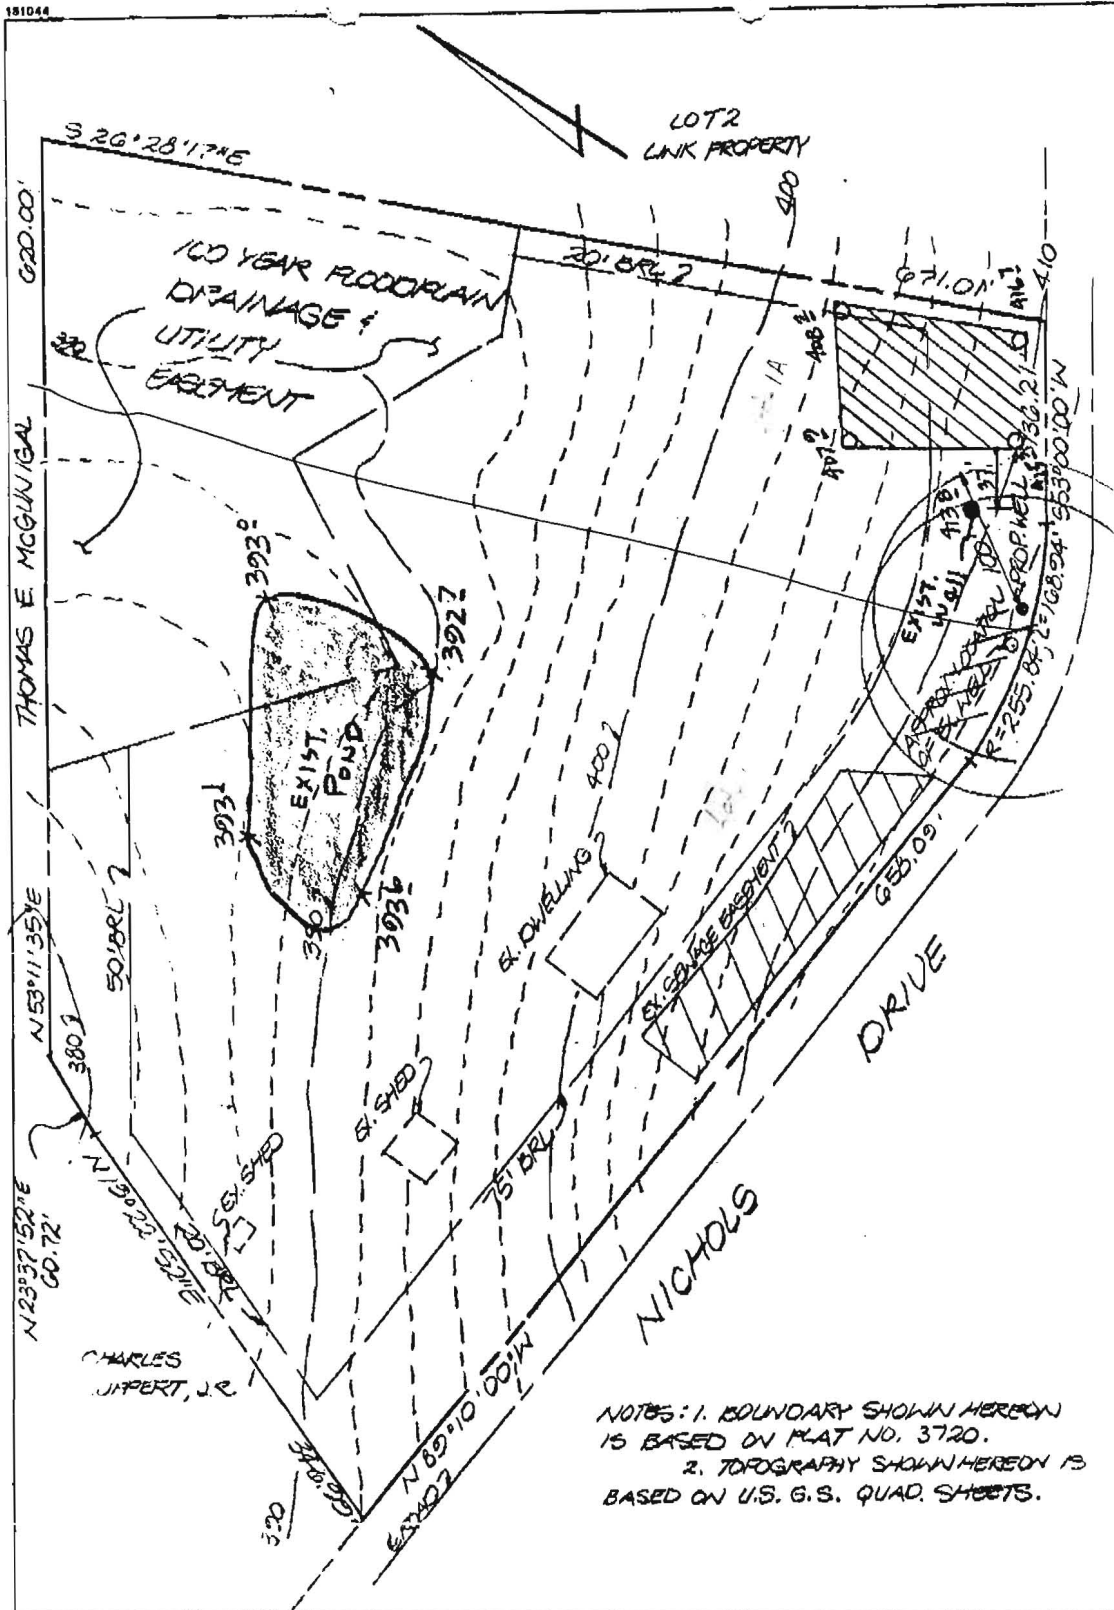

TITLE: PERCOLATION TEST PLAT				
PROJECT: PROIA PROPERTY				
LOCATION: 5 TH. ELECTION DISTRICT HOWARD CO., MD.				
SCALE: 1" = 100'	DESIGNED BY: J.G.O.	DRAWN BY: J.G.O.	CHECKED BY:	DATE: 9-27-91
FIELD BOOK: N/A	PAGE NO.: N/A	JOB NO.: 21092	DRAWING NO.: 1 OF 1	

Boender Associates
INCORPORATED
 ENGINEERS • PLANNERS • SURVEYORS

2330 BETHANY LANE
 ELLICOTT CITY, MD. 21043
 (301) 465-7777 FAX: (301) 465-7966



HOWARD COUNTY HEALTH DEPARTMENT

Joyce M. Boyd, M.D., County Health Officer

February 19, 1992

Reply to:

MEMORANDUM

TO: All Scheduled "Wet Season"
Percolation Test Applicants

FROM: Craig Williams, Program Director CW/JEN
Water and Sewerage Program

RE: Clifton Link Property
Resubdivision of Lot 1
Nichols Drive
Tax Map: 34 Parcel: 368

The water table level has not increased to a level that makes percolation testing for the Spring "Wet Season" evaluation meaningful.

Upon recommendation from the Maryland Department of the Environment, "Wet Season" percolation testing is postponed until further notice. Rainfall and groundwater table response will be monitored until such time as a determination is reached that "Wet Season" testing can be safely rescheduled.


No accurate prediction can be made of when that condition will occur.

Your March 11, 1992 test date has been postponed.

We regret any inconvenience this may cause you. You will be contacted for rescheduling at the earliest opportunity.

If you have not been contacted for rescheduling by April 1, 1992, please contact this office to see that you have not been overlooked.

CW:jr

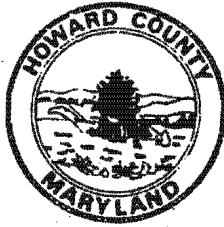

HOWARD COUNTY HEALTH DEPARTMENT

Joyce M. Boyd, M.D., County Health Officer

March 26, 1992

Reply to:

Mr. Donald Proia
13630 Nichols Drive
Clarksville, Maryland 21029

RE: Percolation Test Results
Application Number: A47771
Proposed Use: Re-Subdivision of Lot 1
Property ID: 13630 Nichols Drive
Tax Map: 34 Parcel: 368

Dear Mr. Proia:

Percolation testing conducted March 11, 1992 on the above referenced property indicated unsatisfactory soil conditions. The conditions encountered were high water table, and clayey soils with slow percolation rates. Copies of the test results are enclosed.

If further review is requested, or if you have any questions regarding this matter, please contact me at the above address or by calling 461-9933.

Very truly yours,

Ron Pinkley (CW)

Ronald J. Pinkley, R. S.
Water and Sewerage Program

RJP:jr

Enclosure