

SITE INSPECTION SHEET

Pine Hill Holdings

OWNER: Kenwood Care PHONE #: \_\_\_\_\_

ADDRESS: 8455 Murphy Rd. CONTRACTOR: \_\_\_\_\_


Laurel, MD 20723 WELL TAG #: 94-3167

SUBDIVISION: \_\_\_\_\_ LOT: \_\_\_\_\_ COUNTY #: \_\_\_\_\_

PROPOSAL: Contact: John Sessler, V.P.

N.O.N. for construction of concrete ramp w/o permit

LOCATION DIAGRAM

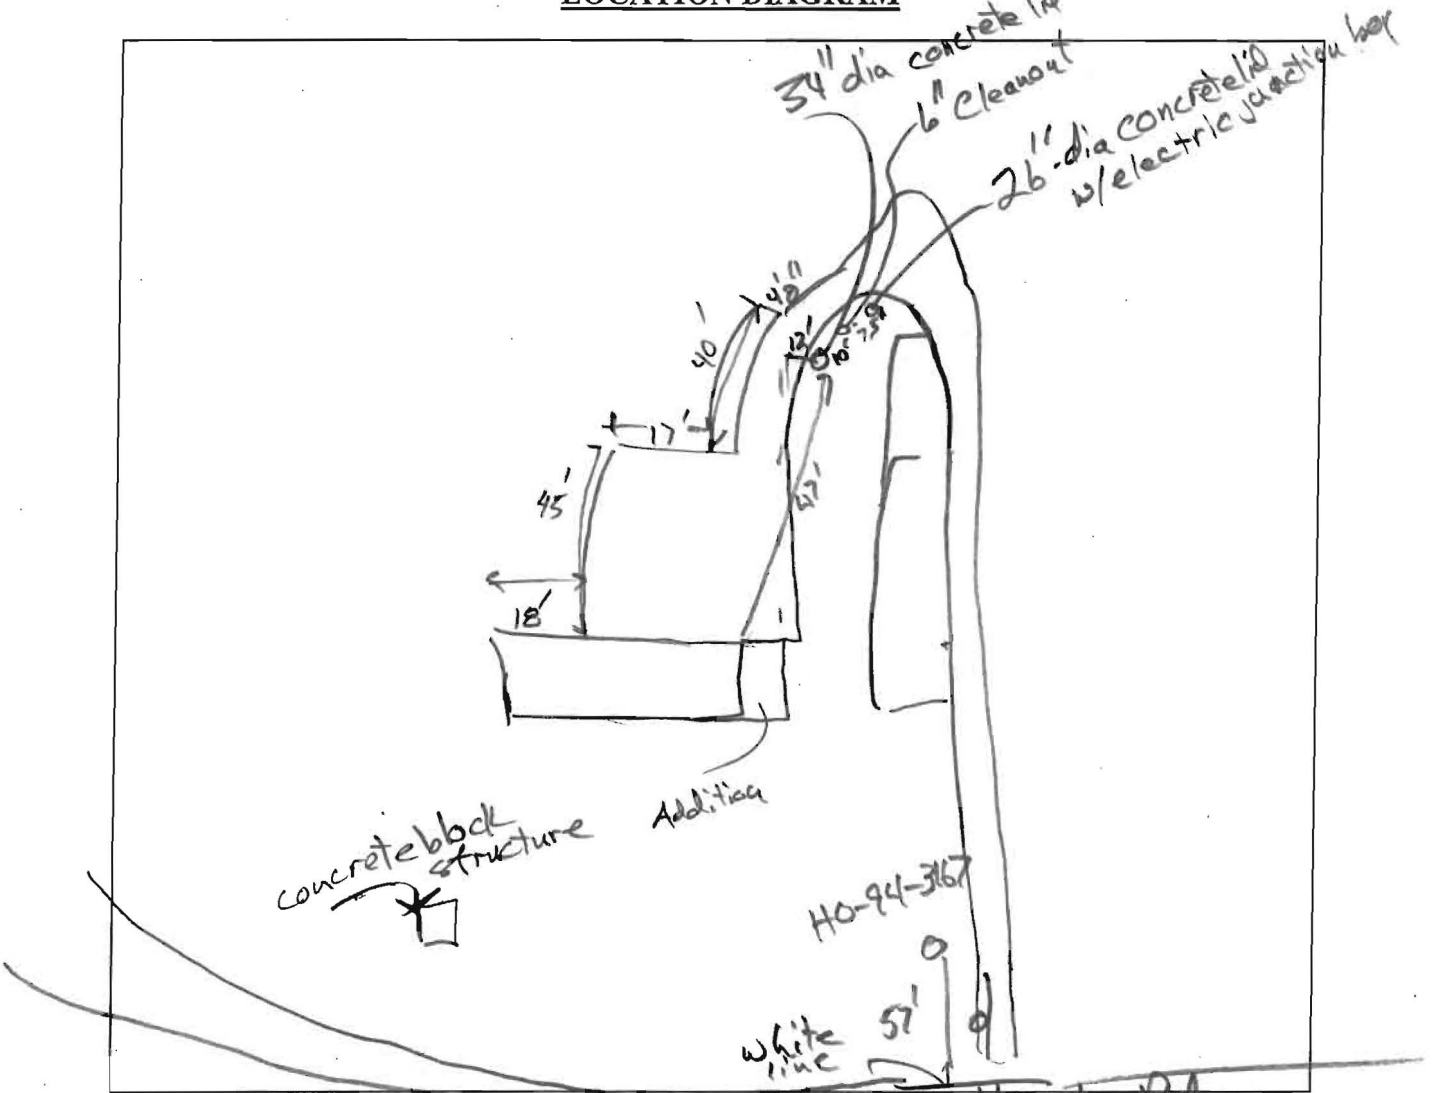

COMMENTS: well has 2pc metal cap; conduit snug in cap port  
Solar-powered light next to well case at ground, well casing  
height = 22", steel, 4'-5' from driveway edge.  
Need to have small concrete structure opened for inspection.

DATE: 10/3/2012 INSPECTOR: R Buckner

\*\*\*\*\*  
 WATER WELL ABANDONMENT-SEALING REPORT FORM  
 \*\*\*\*\*

SUBMIT COPIES OF COMPLETED FORM TO:

- \* COUNTY ENVIRONMENTAL AGENCY (contact MDE, WMA if address needed)
- \* WELL OWNER
- \* MDE, WATER MANAGEMENT ADMINISTRATION, WELL PROGRAM

DATE WELL ABANDONED: 11-21-12 (month/day/year)

\* PERMIT NUMBER OF ABANDONED WELL (if any) \_\_\_\_\_

\* PERMIT NUMBER OF REPLACEMENT WELL: \_\_\_\_\_

\* PERSON ABANDONING WELL: Bruce Thompson WELL DRILLER'S LICENSE NUMBER: JSD 068

CIRCLE: MWD / MSD / MGD

\* OWNER'S NAME: VICTORIA SESSLER

\* WELL LOCATION:

COUNTY: HOWARD

NEAREST TOWN: FULTON

TAX MAP \_\_\_\_\_ BLOCK \_\_\_\_\_ PARCEL \_\_\_\_\_

SUBDIVISION: \_\_\_\_\_


SECTION: \_\_\_\_\_ LOT: \_\_\_\_\_

STREET ADDRESS: 8455 MURPHY RD

LATITUDE 39.139593

LONGITUDE 76.915325

SITE LOCATION MAP

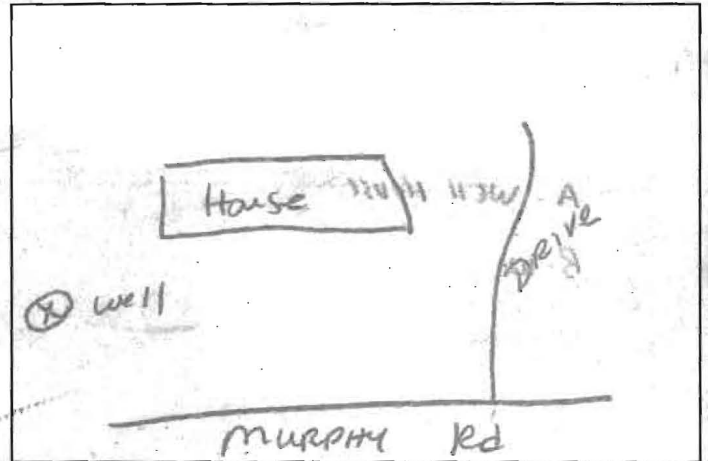

\* TYPE OF WELL BEING ABANDONED:

- DRILLED  JETTED
- BORED  HAND DUG
- OTHER (specify) \_\_\_\_\_

\* USE CODE: DOMESTIC

- IRRIGATION  MUNICIPAL/PUBLIC
- TEST/OBSERVATION  INDUSTRIAL
- \_\_\_\_\_  GEOTHERMAL

\* TYPE OF CASING:

- STEEL  PLASTIC
- CONCRETE  OTHER (specify) \_\_\_\_\_

SIZE OF CASING: 5 1/2 INCHES IN DIAMETER

DEPTH OF WELL: 108 FEET DEEP

WAS ANY CASING REMOVED? YES  NO

If yes, length removed, in feet: \_\_\_\_\_

WAS CASING RIPPED OR PERFORATED? YES  NO

LOG OF SEALING MATERIAL

MATERIAL	FEET	
	FROM	TO
<u>Cement</u>	<u>108</u>	<u>0</u>
VOLUME OF MATERIAL USED		
<u>1300 # Cement</u>		