

B 1 1757

SEQUENCE NO. (MDE USE ONLY)

STATE OF MARYLAND APPLICATION FOR PERMIT TO DRILL WELL

STATE PERMIT NUMBER HO-95-0503


WS25221 please type

fill in this form completely

OWNER INFORMATION
Date Received (APA)
8 MM DD YY 13
Arnold Shawn
8914 Old Frederick Rd.
Ellicott City MD 21042

LOCATION OF WELL
Howard
8 COUNTY 21
23 SUBDIVISION 42
SECTION 44 46 LOT 48 50
Ellicott City
52 NEAREST TOWN 71
MILES FROM TOWN (enter 0 if in town) 1 MI

DRILLER INFORMATION
DAVID KELLY M W D 304
Jonas Well Drilling Inc.
3700 Rush Rd Towson Hk, MD 21284
David Kelly 8-8-06

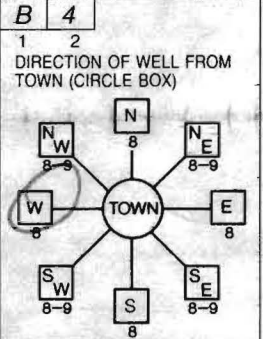

8914 Old Frederick
11 NEAR WHAT ROAD 30
ON WHICH SIDE OF ROAD (CIRCLE APPROPRIATE BOX)
34 75 37 DISTANCE FROM ROAD FT
ENTER FT OR MI 38 39
TAX MAP: 17 BLK: 12 PARCEL 40

WELL INFORMATION
APPROX. PUMPING RATE (GAL. PER MIN.) 0
AVERAGE DAILY QUANTITY NEEDED (GAL. PER DAY) 14 20

USE FOR WATER (CIRCLE APPROPRIATE BOX)
D DOMESTIC POTABLE SUPPLY & RESIDENTIAL IRRIGATION
F FARMING (LIVESTOCK WATERING & AGRICULTURAL IRRIGATION)
I INDUSTRIAL, COMMERCIAL, DEWATERING
P PUBLIC WATER SUPPLY WELL
T TEST, OBSERVATION, MONITORING
G GEO-THERMAL closed loop (3holes)

NOT TO BE FILLED IN BY DRILLER HEALTH DEPARTMENT APPROVAL
Howard 13
COUNTY NAME COUNTY NO.
STATE SIGNATURE INSERT S
DATE ISSUED 6/14/06 CO SIGNATURE EXP. DATE 8/14/07
NORTH GRID 535 000 EAST GRID 851 000


APPROXIMATE DEPTH OF WELL 400 FEET
APPROXIMATE DIAMETER OF WELL 6 INCH NEAREST

METHOD OF DRILLING (circle one)
BORED (or Augered) JETTED Jetted & DRIVEN
AIR-ROTary AIR-PERCussion ROTARY (Hydraulic Rotary)
CABLE REVerse-ROTary DRive-POINT


REPLACEMENT OR DEEPEMED WELLS (CIRCLE APPROPRIATE BOX)
N THIS WELL WILL NOT REPLACE AN EXISTING WELL
Y THIS WELL WILL REPLACE A WELL THAT WILL BE ABANDONED AND SEALED
S THIS WELL WILL REPLACE A WELL THAT WILL BE USED AS A STANDBY-CONTACT LOCAL APPROVING AUTHORITY FOR POLICY ON STANDBY WELLS
D THIS WELL WILL DEEPEN AN EXISTING WELL
PERMIT NUMBER OF WELL TO BE REPLACED OR DEEPEMED (IF AVAILABLE) 41

SHOW MAJOR FEATURES OF BOX & LOCATE WELL WITH AN X
SOURCES OF DRILLING WATER
1.
2.
3.
WRITE THE BOX NUMBER FROM THE MAP HERE
E 850
N 522 35

Not to be filled in by driller (MDE OR COUNTY USE ONLY)
APPROX. PERMIT NUMBER G
PERMIT No. HO-95-0503

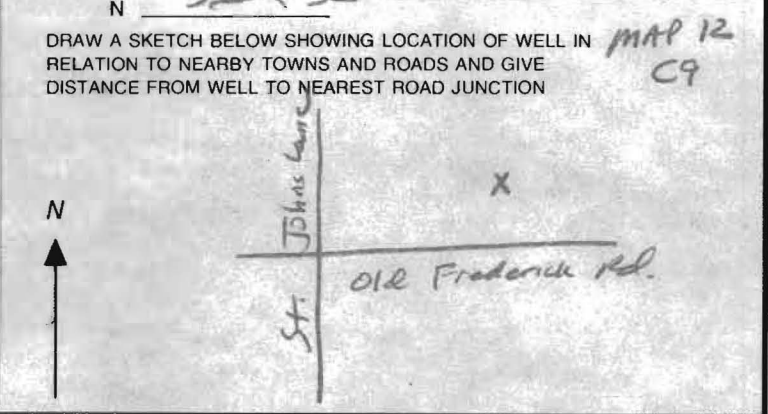

SPECIAL CONDITIONS
NOTE - APPROVING AUTHORITIES SHOULD USE SEPARATE SHEET IF NEEDED
Growt bottom to top

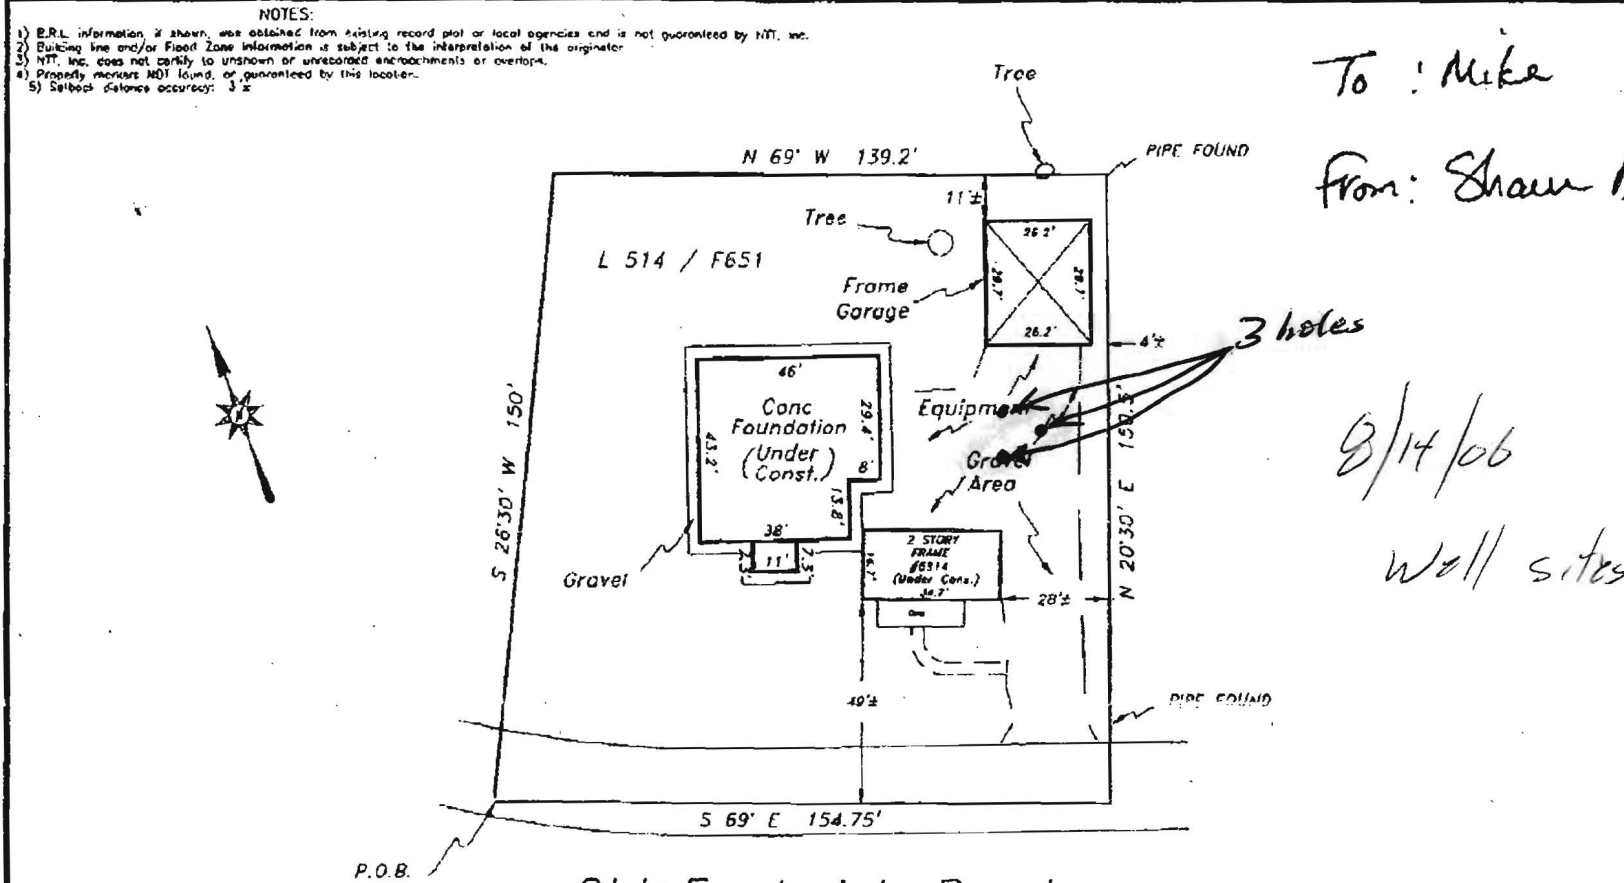

To : Mike  
 From: Shawn Head

8/14/06

Well sites OK  
 (Signature)

Subject property is shown in Zone C on the FIRM Map of Howard County Maryland on Community Panel 240044 0017 B Effective December 4, 1986

Old Frederick Road

This is to certify that I have surveyed the property shown hereon, being known as # 8914 Old Frederick Road and recorded among the land records of Howard County, Maryland in Liber 514 folio 651 for the purpose of locating the improvements thereon.



J. Carl Hudgins PLS #96

LOCATION DRAWING  
 8914 Old Frederick Road  
 2ND ELECTION DISTRICT  
 HOWARD COUNTY, MARYLAND

NTT Associates, Inc.  
 16205 Old Frederick Road  
 Mt. Airy, Maryland 21771  
 Ph (410)442-2031  
 Fax No. (410)442-1315

Scale: 1" = 40'  
 Date: 2-13-06  
 Field By: JCH & Dan  
 Drawn By: JCH & Dan  
 Drawing # MISC8647

\* This plat is of benefit to the consumer only insofar as it is required by a lender or a title insurance company or its agent in connection with contemplated transfer, financing, or refinancing purposes.  
 \* This plat is not to be relied upon for the establishment of location of fences, garages, buildings, or other existing or future structures.  
 \* This plat does not provide for the accurate identification of property boundary lines, but such identification may not be required for the transfer of title or for securing financing or refinancing.