

\*\*\*\*\*  
 WATER WELL ABANDONMENT-SEALING REPORT FORM  
 \*\*\*\*\*

OK SRK  
 8/20/03

SUBMIT COPIES OF COMPLETED FORM TO:

- \* COUNTY ENVIRONMENT AGENCY (contact MDE, WMA if address needed)
- \* WELL OWNER
- \* MDE, WATER MANAGEMENT ADMINISTRATION, WELL PROGRAM

DATE WELL ABANDONED: 8-13-03 (month/day/year)

CHARL-

\* PERMIT NUMBER OF ABANDONED WELL (if any) UN - - Know

\* PERMIT NUMBER OF REPLACEMENT WELL - -


\* PERSON ABANDONING WELL: DANIEL K. RYAN

WELL DRILLERS LICENSE NUMBER: 256

CIRCLE: MWD/MSD/MGD

\* OWNER'S NAME: CHARLES STANCO

SITE LOCATION MAP

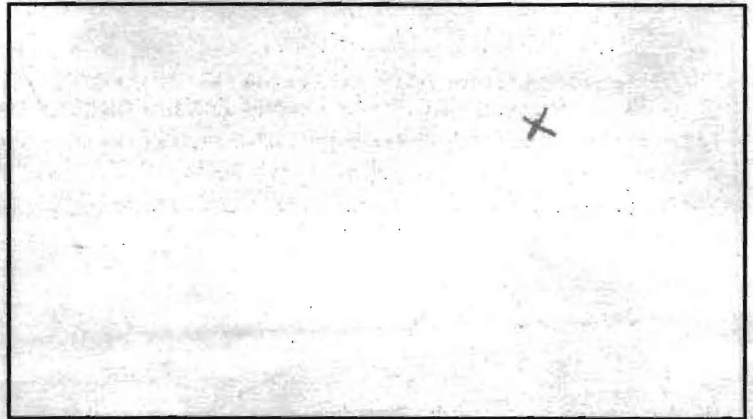

\* WELL LOCATION:  
 COUNTY: HOWARD  
 NEAREST TOWN: ELICOTT CITY  
 TAX MAP \_\_\_\_\_ BLOCK \_\_\_\_\_ PARCEL \_\_\_\_\_  
 SUBDIVISION: \_\_\_\_\_  
 SECTION: \_\_\_\_\_ LOT: \_\_\_\_\_  
 NEAREST ROAD: Old Frederick Rd  
8665 Old Frederick Rd

\* TYPE OF WELL BEING ABANDONED:

- DRILLED  JETTED
- BORED/AUGERED  HAND DUG
- OTHER (specify) \_\_\_\_\_

\* USE CODE:

- DOMESTIC  MUNICIPAL/PUBLIC
- IRRIGATION  INDUSTRIAL
- TEST/OBSERVATION  GEOTHERMAL

\* TYPE OF CASING:

- STEEL  PLASTIC
- CONCRETE  OTHER (specify) \_\_\_\_\_

\* SIZE OF CASING: 6 INCHES IN DIAMETER

\* DEPTH OF WELL: 54 FEET DEEP

\* WAS ANY CASING REMOVED?  YES  NO  
 if yes, length removed, in feet: \_\_\_\_\_

\* WAS CASING RIPPED OR PERFORATED?  YES  NO

LOG OF SEALING MATERIAL

MATERIAL	FEET	
	FROM	TO
Grout	0	20
STONE	20	54
VOLUME OF MATERIAL USED		

SIGNATURE - MASTER WELL DRILLER OR SUPERVISING SANITARIAN

LICENSE # MWD 256

CIRCLE ONE MWD/MSD/MGD

DATE 8-13-03

