

SITE INSPECTION SHEET

OWNER: Hild PHONE #: _____


ADDRESS: 8434 old Frederick Rd. CONTRACTOR: Harr Drilling / Carroll Water

WELL TAG #: _____

SUBDIVISION: _____ LOT: _____ COUNTY #: _____

PROPOSAL: Install constant pressure pump + connect barn to existing well.

LOCATION DIAGRAM

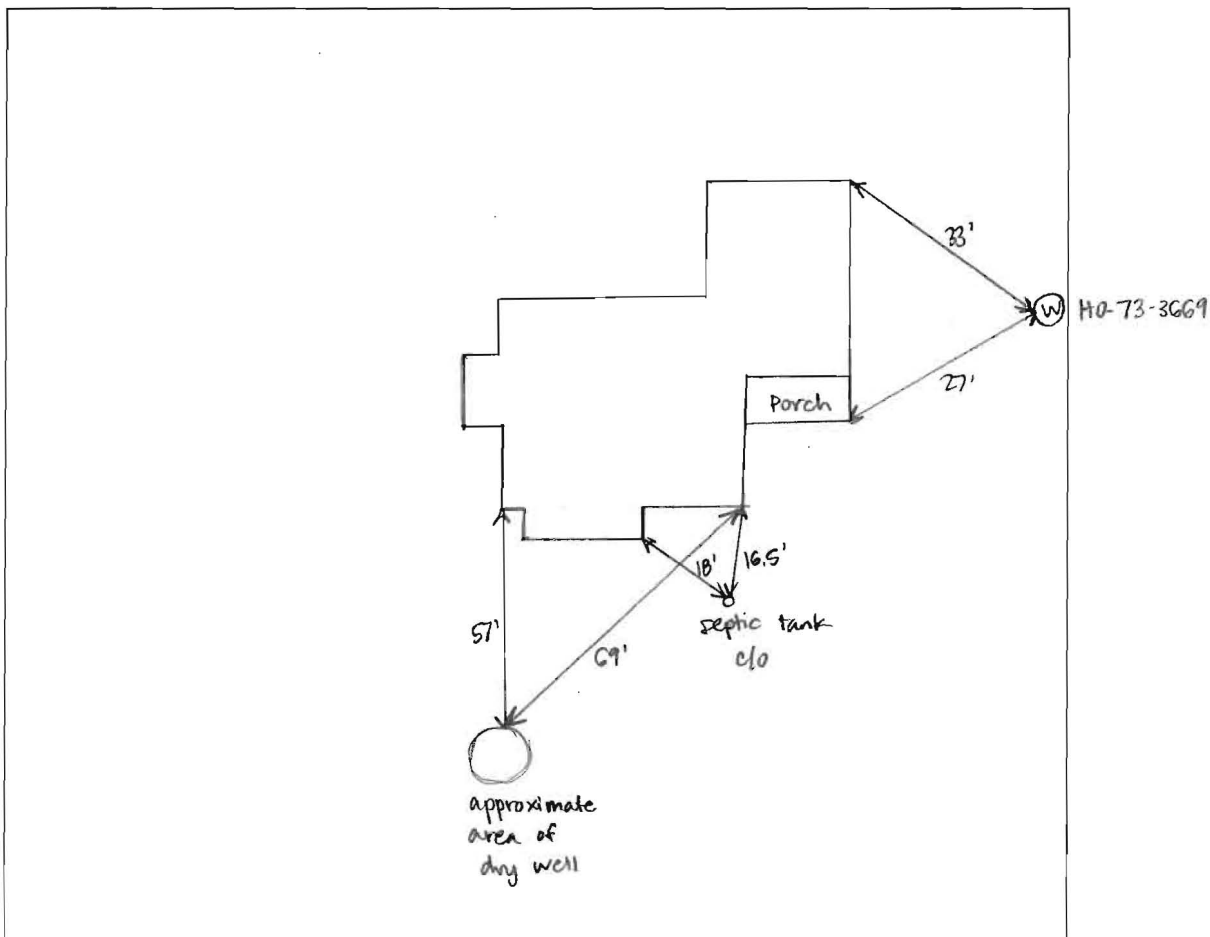

COMMENTS: Harr on site for yield test. Well pumping ~10 gpm.

DATE: 7/26/16 INSPECTOR: Sarah Collins