

APPLICATION

19180

SEWAGE DISPOSAL TESTING

P _____

STATE OF MARYLAND - DEPARTMENT OF HEALTH AND MENTAL HYGIENE

HOWARD COUNTY HEALTH DEPARTMENT
ENVIRONMENTAL HEALTH SERVICES

Sh. Laws 5/5/6

DISTRICT 4th

P. O. BOX 476, ELLICOTT CITY, MARYLAND 21043
TELEPHONE: 463-8000, EXT. 386

DATE 10/30/73

TO: THE COUNTY HEALTH OFFICER
ELLICOTT CITY, MARYLAND

I, HEREBY, APPLY FOR THE NECESSARY TEST IN ORDER TO CONSTRUCT (OR RECONSTRUCT) A SEWAGE DISPOSAL SYSTEM.

PROPERTY OWNER Justice Tract, Joint-Venture Roger Howell 933-3392

ADDRESS 1131 University Blvd. W. #215, Silver Spring, Md. 20902 PHONE 301-649-1500

PROPERTY LOCATION:

SUBDIVISION Glenwood Estates LOT NO. 6 Sec I

ROAD AND DESCRIPTION S.E. Quadrant of intersection of Shady Lane & Burntwoods Rd.
14620 Mustang Path

SIZE OF LOT 1.6 acres 55,000 s.f. TYPE BLDG. 3-4 bedrooms
NUMBER OF BEDROOMS

IF NOT SINGLE RESIDENCE DESCRIBE _____

THE SYSTEM INSTALLED UNDER THIS APPLICATION IS ACCEPTABLE ONLY UNTIL PUBLIC FACILITIES BECOME AVAILABLE.

SIGNATURE OF APPLICANT Justice Tract, Joint Venture: By *William J. Ford* Partner

APPROVED BY *William J. Ford* FOR *DW + ...* DATE 6/1/77
(KIND OF SYSTEM)

REJECTED BY _____ FOR _____ DATE _____
(KIND OF SYSTEM)

HOLD PENDING FURTHER TESTS _____ DATE _____

REASONS FOR REJECTION OR HOLDING _____

RP 66936
10-4-85
12-485

THIS IS NOT A PERMIT

APPLICATION

A 1980

SEWAGE DISPOSAL TESTING

P _____

STATE OF MARYLAND - DEPARTMENT OF HEALTH AND MENTAL HYGIENE

HOWARD COUNTY HEALTH DEPARTMENT
ENVIRONMENTAL HEALTH SERVICES
P. O. BOX 476, ELLICOTT CITY, MARYLAND 21043
TELEPHONE: 465-9000, EXT. 386

DISTRICT 4th

DATE 10/30/73

TO: THE COUNTY HEALTH OFFICER
ELLICOTT CITY, MARYLAND

I, HEREBY, APPLY FOR THE NECESSARY TEST IN ORDER TO CONSTRUCT (OR RECONSTRUCT) A SEWAGE DISPOSAL SYSTEM.

PROPERTY OWNER Justice Tract, Joint Venture

ADDRESS 1131 University Blvd. W. #215, Silver Spring, Md. 20902 PHONE 301-649-1500

PROPERTY LOCATION:

SUBDIVISION Glenwood Estates LOT NO. 7 See I

ROAD AND DESCRIPTION S.E. Quadrant of intersection of Shady Lane & Burntwoods Rd.

SIZE OF LOT ~~1.6 acres~~ 55,000 sf TYPE BLDG. 3-4 bedrooms
NUMBER OF BEDROOMS _____

IF NOT SINGLE RESIDENCE DESCRIBE _____

THE SYSTEM INSTALLED UNDER THIS APPLICATION IS ACCEPTABLE ONLY UNTIL PUBLIC FACILITIES BECOME AVAILABLE.

SIGNATURE OF APPLICANT Justice Tract, Joint Venture: By *Walter J. Joral* Partner


APPROVED BY _____ FOR _____ DATE _____
(KIND OF SYSTEM)

REJECTED BY _____ FOR _____ DATE _____
(KIND OF SYSTEM)

HOLD PENDING FURTHER TESTS _____ DATE _____

REASONS FOR REJECTION OR HOLDING _____

THIS IS NOT A PERMIT

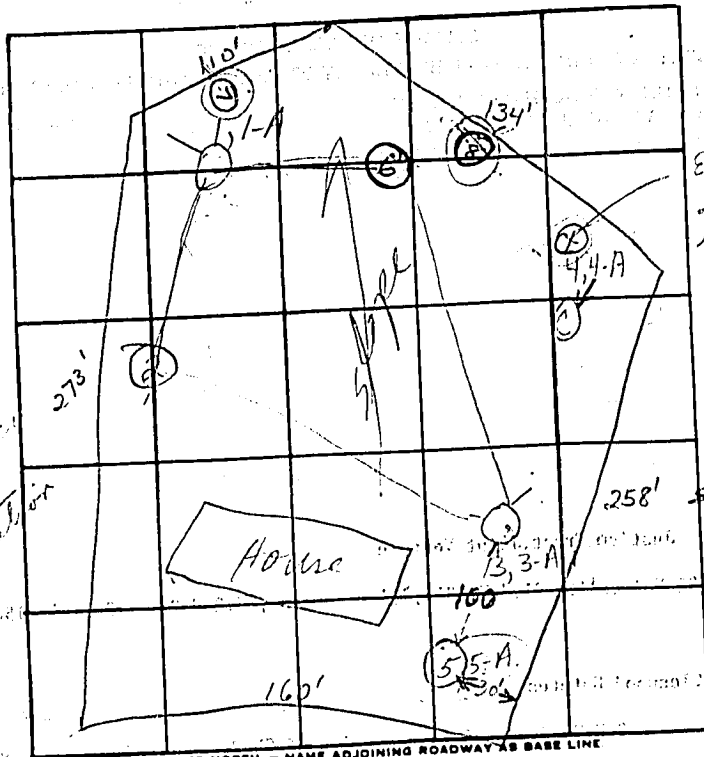

Extra hole
20' fr 1, 4-A
rock @ 9'

Lot 7

Use 3, 3-A

$\bar{c} = 11 \text{ min}$

Big 1 deep
under 4, 4-A
smaller location

INDICATE NORTH - NAME ADJOINING ROADWAY AS BASE LINE
UNNAMED RD

DATE	TEST NO.	DEPTH	PRE-WET		TEST - 1" DROP		TIME
			START	STOP	START	STOP	
7/17/74	1	5	9:41	9:49	9:49	10:01	11
7/18/74	1-A	11 1/2	9:42	9:53	9:53	10:02	9
	2	12	Visual; same to		3, 3-A; dry		
	3	6	9:56	9:56	10:05	10:05	5
	3-A	12	9:53	9:59	9:59	10:07	8
	4	Rock @ 9'	wood - 1 1/2'				
	4-A						
	5	4	3:26	3:29	3:29	3:38	9
	5-A	12	3:38	5 gal dumped in bottom	3:57		19
8/28	6	13	vis	dry	- no rock		

REMARKS 1-A - damp in bottom; 3 - good soil @ 5'
3-A; damp in bottom

TYPE OF SOIL Sandy-loam