

APPLICATION

A 19183

P _____

SEWAGE DISPOSAL TESTING

MARYLAND STATE DEPARTMENT OF HEALTH

HOWARD COUNTY

ELLICOTT CITY

DISTRICT 4th

DATE 10/30/73

TO: THE COUNTY HEALTH OFFICER
ELLICOTT CITY, MARYLAND

I, HEREBY, APPLY FOR THE NECESSARY TESTS IN ORDER TO CONSTRUCT (OR RECONSTRUCT) A SEWAGE DISPOSAL SYSTEM.

PROPERTY OWNER JUSTICE TRACT, JOINT VENTURE

ADDRESS 1131 University Blvd. W. #215, Silver Spring, Md. 20908 PHONE 301-649-1500

PROPERTY LOCATION:

SUBDIVISION Glenwood Estates

LOT NO. 10 Sec I

ROAD AND DESCRIPTION S.E. Quadrant of intersection of Shady Lane & Burntwoods Rd.

OCCUPANT _____

PHONE _____

PERSON TO CONSTRUCT SYSTEM _____

ADDRESS _____

PHONE _____

SIZE OF LOT ~~2.3~~ acres 99,000 S.F.

TYPE BLDG. 3-4 Bedrooms

NUMBER OF BEDROOMS

IF NOT SINGLE RESIDENCE DESCRIBE _____

SIGNATURE OF APPLICANT Justice Tract, Joint Venture: By Martin Kovach

Partner

APPROVED BY _____

FOR _____

(KIND OF SYSTEM)

DATE _____

REJECTED BY _____

FOR _____

(KIND OF SYSTEM)

DATE _____

HOLD PENDING FURTHER TESTS _____


DATE _____

REASONS FOR REJECTION OR HOLDING _____

THIS IS NOT A PERMIT

✓
 1:07 1:08 2:00
 1:14 1:17
 2:14 2:18
 2:10 2:14 2:22

Use 1-1-A
 for system

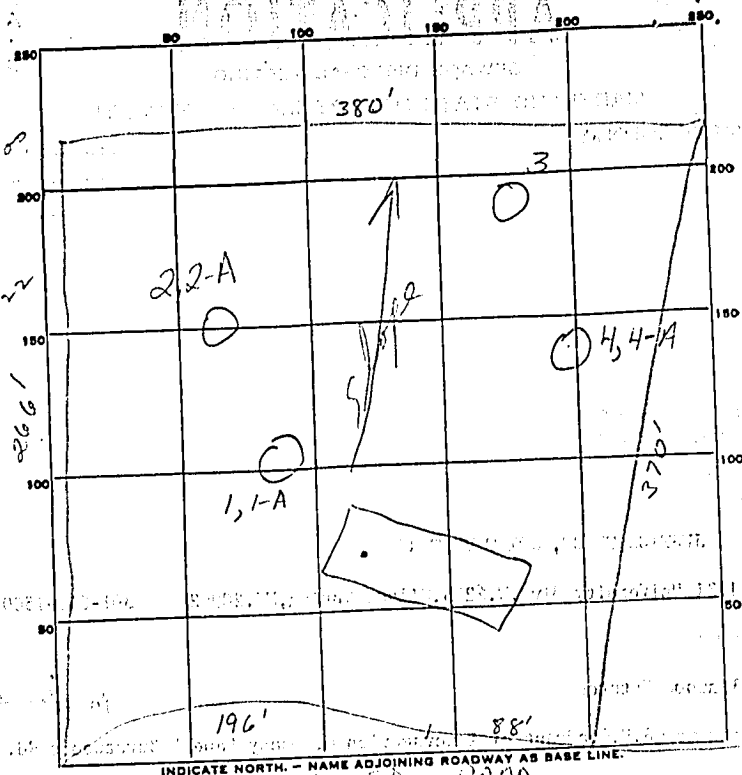

Lot 10

$\bar{t} = 9 \text{ min}$

{ 8/1/74

DATE	TEST NO.	DEPTH	PRE-WET		TEST - 1" DROP		TIME	
			START	STOP	START	STOP		
	1	4 1/2	1:06	1:09	1:09	1:18	9	
	1-A	12	1:10	1:16	1:16	1:27	11	
	2	5	1:03	1:06	1:06	1:15	9	
	2-A	12	1:00	1:04	1:04	1:11	7	
	3	12 1/2	Visual, similar to 1-1-A; dry					
	4	4 1/2	1:33	1:40	1:40	1:47	7	
	4-A	11 1/2	1:30	1:38	1:38	1:47	9	

$\bar{t} = 10 \text{ min}$

SOIL AUGER FINDING Hardy loam
 TESTED BY WWZ
 REMARKS _____