






Prop Well Zone  
Lot 2  
Scagg's  
442 Phase 2

1:50

100'

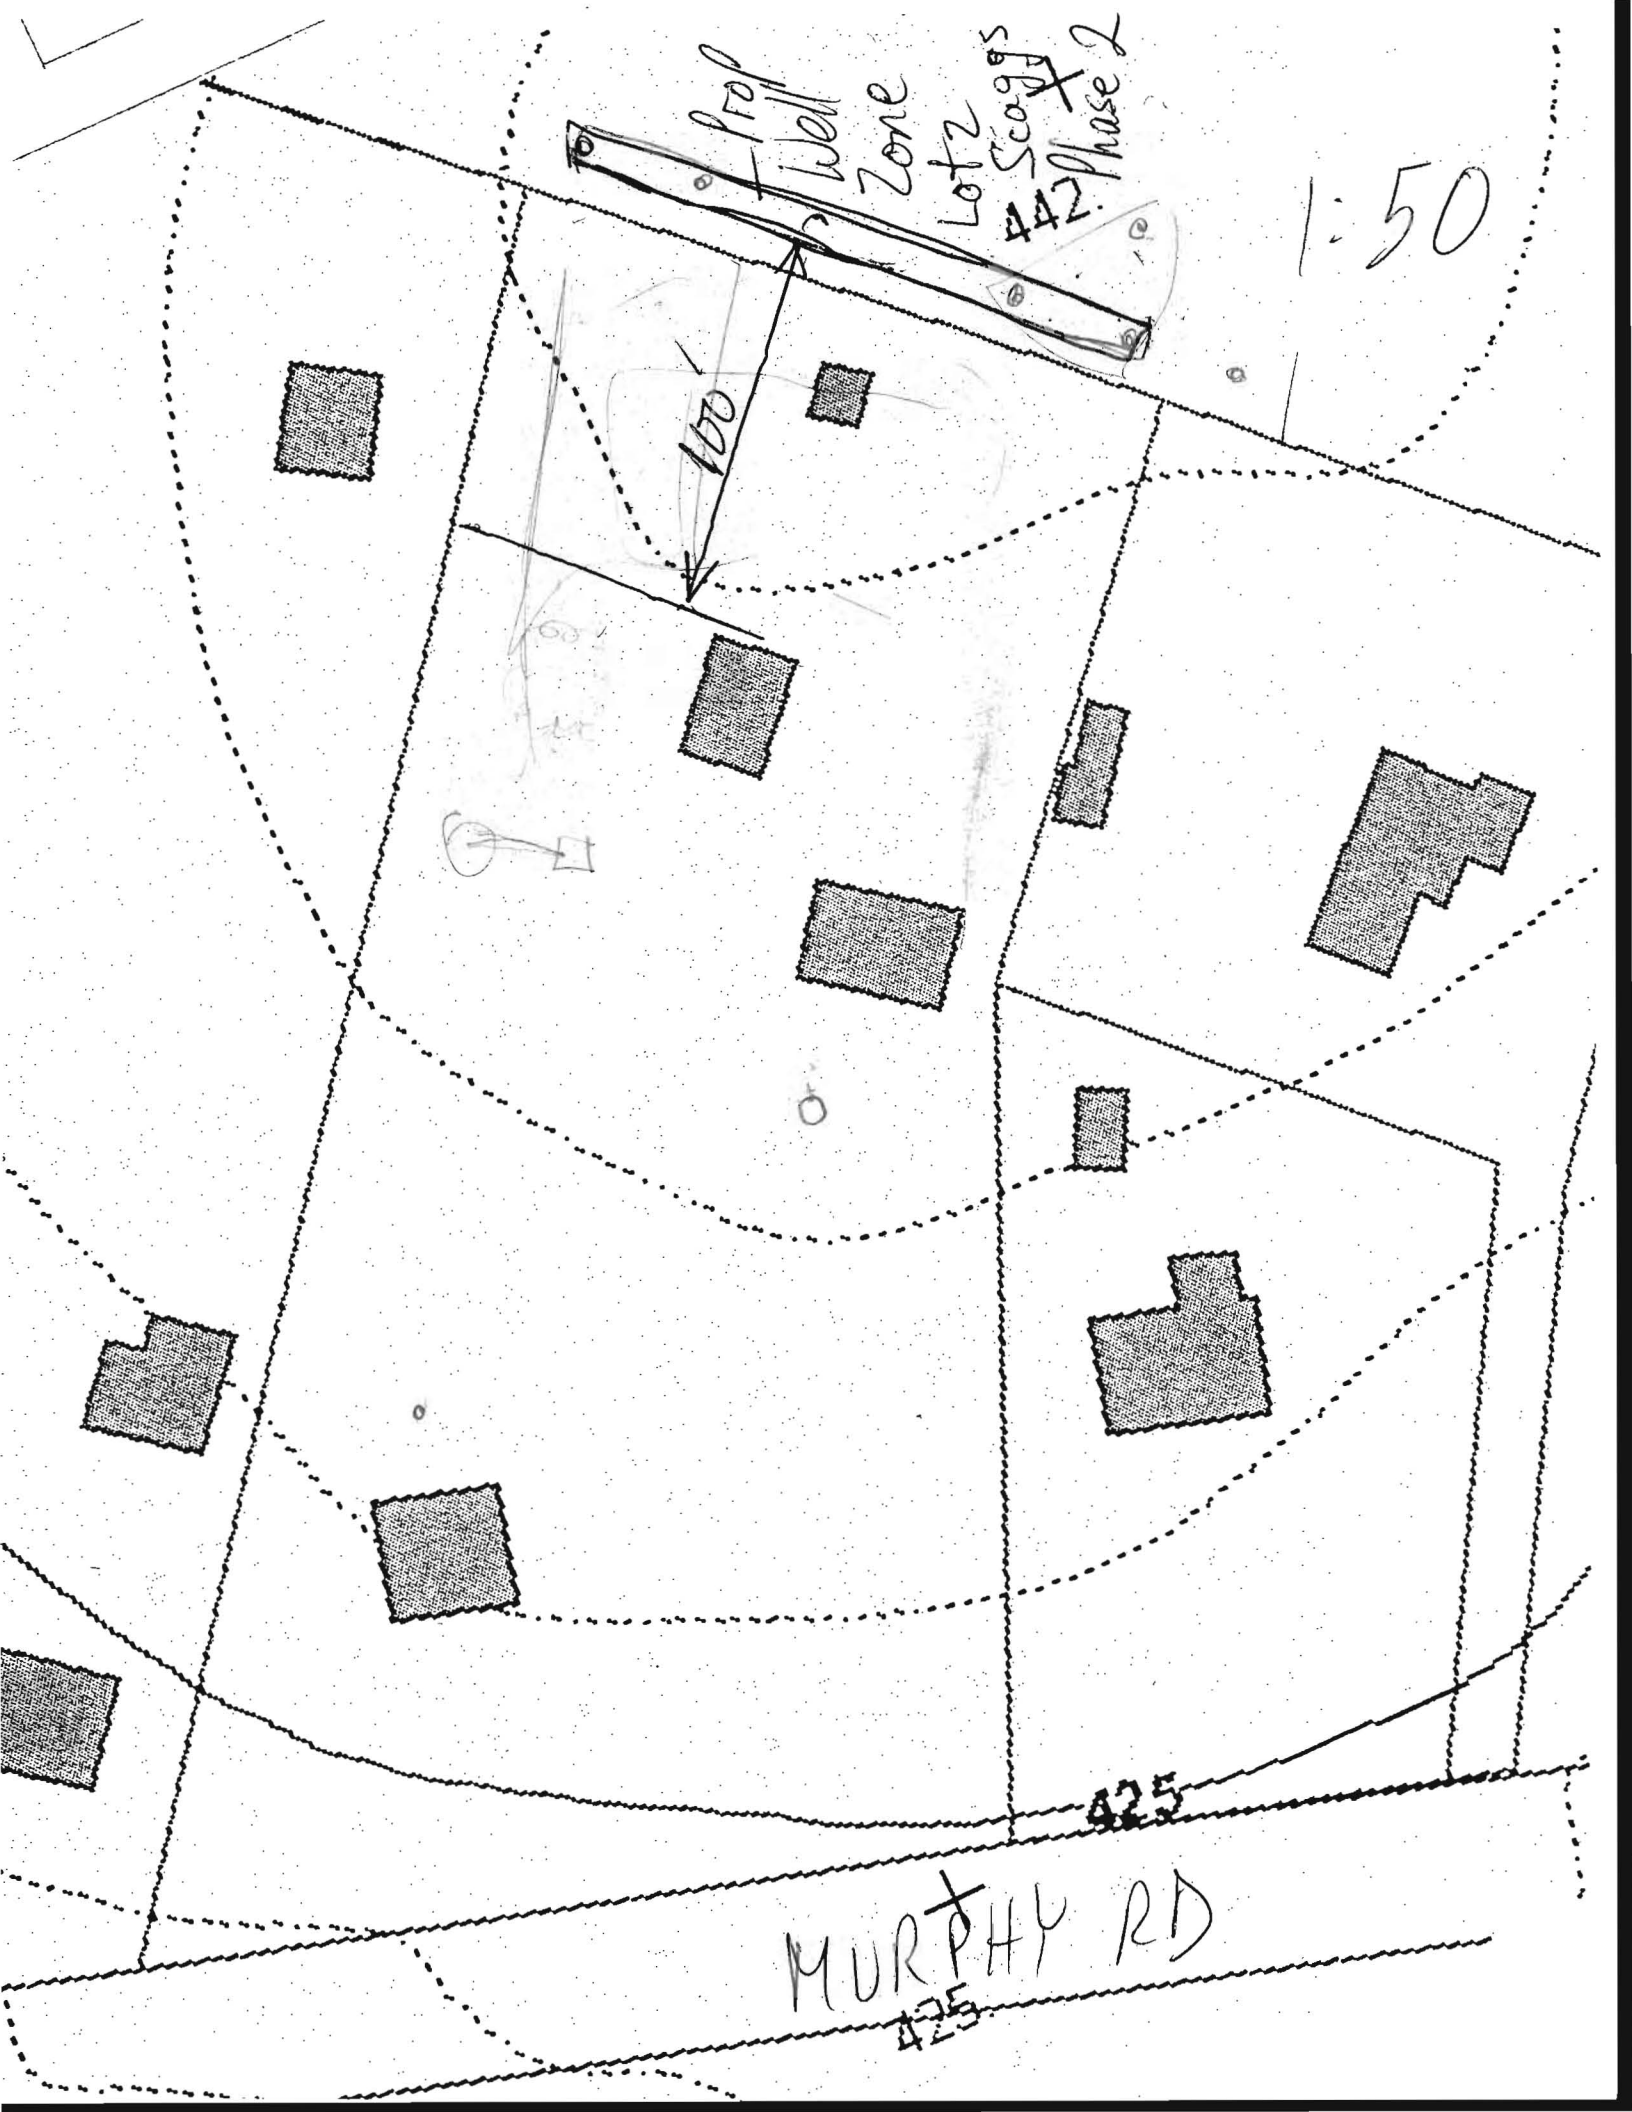

MURPHY RD  
425