

10/31/77  
as soon as possible

001 002 003 004 005

# PERMIT

SEWAGE DISPOSAL SYSTEM

O.P.C.O. C.B.A.  
P-27036  
A 19183 O.P.C.O. C.F.D.

MARYLAND STATE DEPARTMENT OF HEALTH

HOWARD COUNTY

ELLICOTT CITY  
DISTRICT 4th

## INDEXED

DATE 10/11/77

Jack Fyock IS PERMITTED TO INSTALL  ALTER  
ADDRESS 13775 Triadelphia Road, Glenelg, Md. PHONE

A SEWAGE DISPOSAL SYSTEM LOCATED AT

SUBDIVISION Glenwood Estates ROAD 14664 Mustang Path LOT 9, Sec. 1

PROPERTY OWNER Ronald Cleaver

ADDRESS 1721 Dedar Park Road, Annapolis, Md. 21401

SPECIFICATIONS 3 bedrooms

DRAIN FIELD DEPTH FEET, BOTTOM AREA SQ. FT.

SEEPAGE PITS ABSORBENT SIDE-WALL AREA SQ. FT.

SEPTIC TANK CAPACITY 1000 GALLONS

FOR GARBAGE GRINDER, INCREASE DISPOSAL AREA 22% & TANK CAPACITY 50%.


OTHER DRY WELL AND TRENCH - Dry well to have 300 sq. ft. sidewall area. Inlet at 4 ft. below original grade and maximum depth 10 ft. below original grade. Effective depth starts at 4 1/2 ft. Locate dry well 105 ft. from the front lot line and 60 ft. from the left lot line as seen when facing lot from the road. Trench to be 18 ft. long for a sidewall area of 100 sq. ft. Inlet to trench at 4 1/2 ft. (effective depth 4 1/2 ft.) and maximum depth 10 ft. Come off right side of dry well, run trench towards right rear side of the lot. Follow contour to keep trench level. NOTE: CALL FOR INSPECTION OF TRENCH BEFORE PLACING STONE IN TRENCH. NOTE: ALL PIPE FROM HOUSE TO DISPOSAL AREA MUST BE CAST IRON. PERMIT VOID AFTER THREE YEARS. NOTE: INSTALL STAND PIPE ON SEPTIC TANK AND DRY WELL. STAND PIPES MUST BE 6 INCHES IN DIAMETER. CAST IRON, CONCRETE OR

PLANS APPROVED BY William W. Zepp DATE 5/26/77

TERRA COTTA ACCEPTED.  
FILL SEPTIC TANK AND DISTRIBUTION BOX WITH WATER BEFORE CALLING FOR AN INSPECTION. COVER NO WORK UNTIL INSPECTED AND APPROVED.

NEITHER THE HOWARD COUNTY COMMISSIONERS NOR THE HEALTH DEPARTMENT IS RESPONSIBLE FOR THE SUCCESSFUL OPERATION OF ANY SYSTEM.

19183

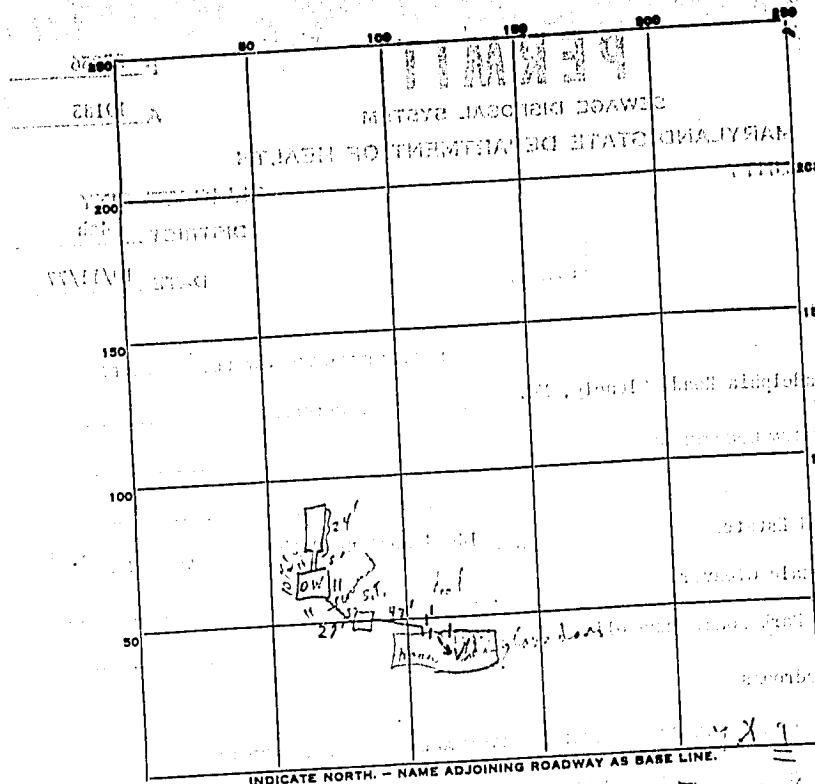

PERMIT CARD \_\_\_\_\_

SEPTIC TANK, LEVEL \_\_\_\_\_

CLEANOUTS \_\_\_\_\_

DISTRIBUTION BOX, LEVEL \_\_\_\_\_

TILE FIELD, DEPTH 10 FT.

TRENCH WIDTH \_\_\_\_\_ FT.

GRAVEL DEPTH 6 IN.

TOTAL LENGTH 24 FT.

NUMBER OF TRENCHES 1

TOTAL BOTTOM AREA \_\_\_\_\_

SEEPAGE PITS, INSIDE DIAMETER 47 1/2 FT.

DEPTH BELOW INLET 6 FT.

ABSORBENT AREA 4.05 SQ. FT.

REMARKS \_\_\_\_\_

DATE SYSTEM APPROVED \_\_\_\_\_

INSPECTOR \_\_\_\_\_

HOUSE:  
 FF. ELEV.: 574.5 (ENTR.)  
 BSM'T ELEV.: 565.1 INV. OUT.: 562.5  
 SEPTIC TANK:  
 EX. GRD.: 565.5  
 FIN. GRD.: 565.0  
 INV. INTO TANK: 561.9  
 INV. OUT OF TANK: 561.5  
 DRYWELL:  
 EX. GRD.: 565.0  
 FIN. GRD.: 565.0  
 INVERT INTO DRYWELL: 560.5  
 WELL:  
 EX. GRD.: 569.0  
 FIN. GRD.: 569.2

*5/26/77*  
*Elevation & locations*  
*app'd. w.w.2*

