

Chart 8/14/61

PERMIT

SEWAGE DISPOSAL SYSTEM

MARYLAND STATE DEPARTMENT OF HEALTH

HOWARD COUNTY

ELLCOTT CITY

DISTRICT 5

DATE 7-19-61

INDEXED

V. C. Cissell IS PERMITTED TO INSTALL ALTER
ADDRESS Highland, Maryland PHONE _____

A SEWAGE DISPOSAL SYSTEM LOCATED AT _____

SUBDIVISION Kopkins Neade ROAD 1 Blk. in subdiv. lot 14, 30 sq. ft. 2
in Sork of Road REV.

PROPERTY OWNER W. E. Robbins
ADDRESS Clarksville, Md.

SPECIFICATIONS

DRAIN FIELD _____ DEPTH _____ FEET, BOTTOM AREA _____ SQ. FT.

SEEPAGE PITS 2 ABSORBENT SIDE-WALL AREA _____ SQ. FT.

SEPTIC TANK CAPACITY 750 GALLONS

FOR GARBAGE GRINDER, INCREASE DISPOSAL AREA AND TANK CAPACITY 50%.


INSTALL any wells each 10 ft. in dia. by 10 ft. deep below the intake locate
one dry well 100 ft. from rear property line and 50 ft. off the left side property
line. locate other dry well 50 ft. off the left side property line and 50 ft. from
the other dry well as measured from edge to edge. left side property line obtained
when facing lot from Oak Crest Lane.

PLANS APPROVED BY James W. Heninger DATE 4-14-61

FILL SEPTIC TANK AND DISTRIBUTION BOX WITH WATER BEFORE CALLING FOR AN INSPECTION. COVER SO WORK UNTIL INSPECTED AND APPROVED.

NEITHER THE HOWARD COUNTY COMMISSIONERS NOR THE HEALTH DEPARTMENT IS RESPONSIBLE FOR THE SUCCESSFUL OPERATION OF ANY SYSTEM.

AC 5000

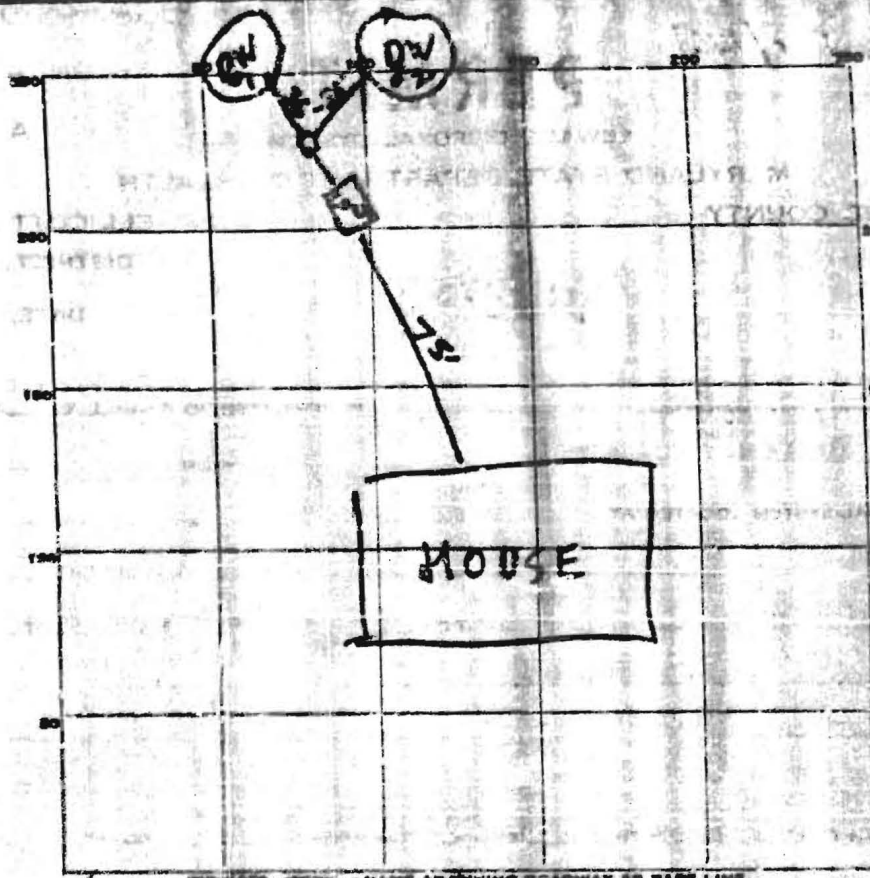

INDICATE NORTH - NAME ADJOINING ROADWAY AS BASE LINE

ONE CREST LAKE

PERMIT CARD

SEPTIC TANK, LEVEL 750 concrete

CLEANOUT

DISTRIBUTION BOX, LEVEL

TILE FIELD, DEPTH _____ FT. THICKNESS _____ FT.

GRAVEL DEPTH _____ IN. TOTAL LENGTH _____ FT.

NUMBER OF TILES _____ TOTAL BOTTOM AREA _____

SEEPAGE PITS, INSIDE DIAMETER _____ FT. DEPTH BELOW INLET _____ FT.

ABSORBENT AREA _____ SQ. FT.

REMARKS

DW # 1 - 10' dia, 10' deep, 314 S.F.

DW # 2 - 10' dia, 10' deep, 314 S.F.

628 S.F.

DATE SYSTEM APPROVED

8/16/61

INSPECTOR

Jerry