

10-5-62

PERMIT

P 05508
A 05495

SEWAGE DISPOSAL SYSTEM

MARYLAND STATE DEPARTMENT OF HEALTH

HOWARD COUNTY

ELLICOTT CITY

DISTRICT 3

Edward Dorsey

DATE 7/23/62

INDEXED

~~WALTER S. Wimmer~~

IS PERMITTED TO INSTALL ALTER

ADDRESS

PHONE

A SEWAGE DISPOSAL SYSTEM LOCATED AT

*Rt 99 - 2/10 of a mile west of
Marriottsville #16 house*

SUBDIVISION

ROAD

LOT

PROPERTY OWNER

Dorsey, Edward

ADDRESS

SPECIFICATIONS

DRAIN FIELD DEPTH _____ FEET, BOTTOM AREA 300 SQ. FT.

SEEPAGE PITS _____ ABSORBENT SIDE-WALL AREA _____ SQ. FT.

SEPTIC TANK CAPACITY 750 GALLONS

FOR GARBAGE GRINDER, INCREASE DISPOSAL AREA 22% & TANK CAPACITY 50%.

OTHER

Place the tile field 125 to 160 ft.

from the back of the house

PLANS APPROVED BY

Raymond Hodges


DATE

7/19/62

FILL SEPTIC TANK AND DISTRIBUTION BOX WITH WATER BEFORE CALLING FOR AN INSPECTION. COVER NO WORK UNTIL INSPECTED AND APPROVED.

NEITHER THE HOWARD COUNTY COMMISSIONERS NOR THE HEALTH DEPARTMENT IS RESPONSIBLE FOR THE SUCCESSFUL OPERATION OF ANY SYSTEM.

A 05495

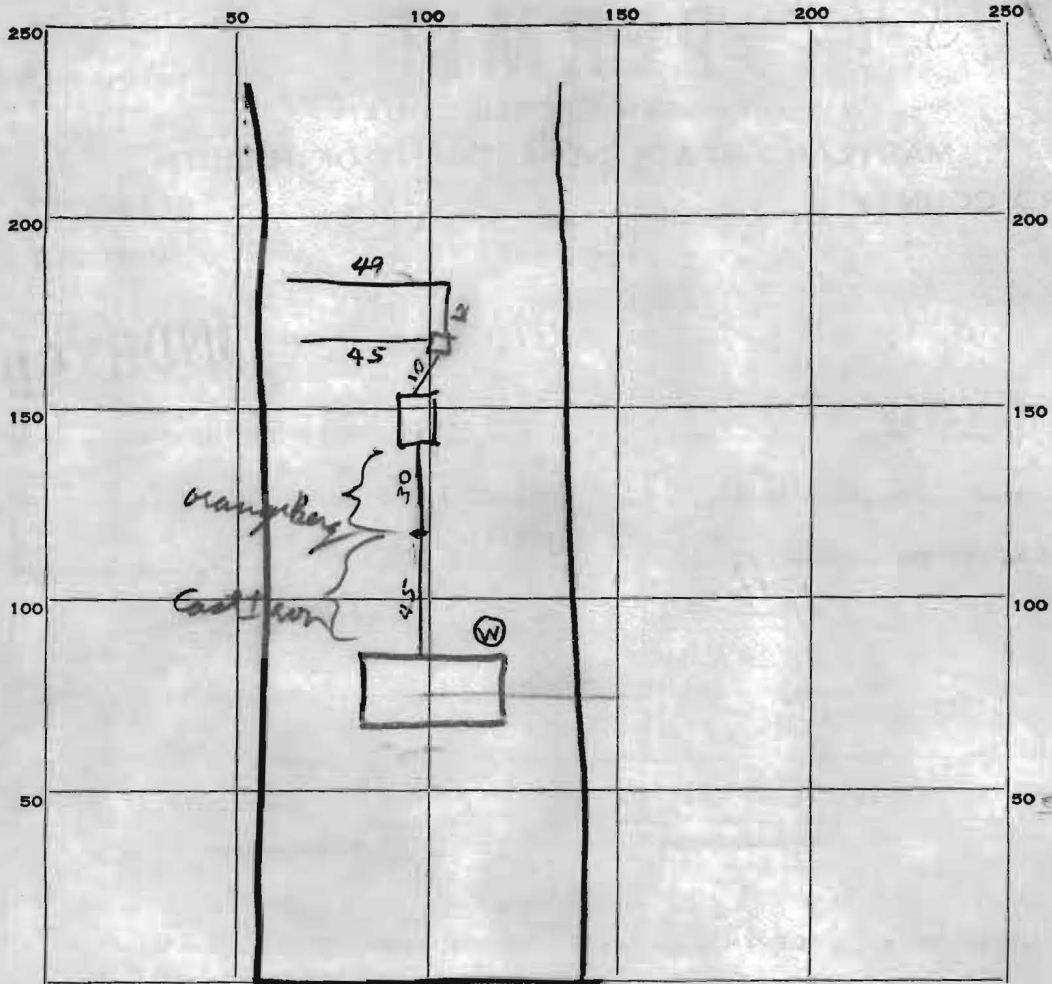

INDICATE NORTH. — NAME ADJOINING ROADWAY AS BASE LINE.

PERMIT CARD yes

SEPTIC TANK, LEVEL OK concrete 740 CLEANOUTS OK
top 1 ft below grade

DISTRIBUTION BOX, LEVEL OK

TILE FIELD, DEPTH 3 FT. TRENCH WIDTH 3 FT.

GRAVEL DEPTH _____ IN. TOTAL LENGTH 94 FT.

NUMBER OF TRENCHES 2 TOTAL BOTTOM AREA 28 2

SEEPAGE PITS, INSIDE DIAMETER _____ FT. DEPTH BELOW INLET _____ FT.

ABSORBENT AREA _____ SQ. FT.

REMARKS Should have cleanout between House
& tank

DATE SYSTEM APPROVED 13 NOV 62 INSPECTOR Raymond Hodges