

2/17/77
1:00 P.M.
at
Preliminary Visual hole needed
(See over)

APPLICATION

SEWAGE DISPOSAL TESTING

A 16696

P _____

MARYLAND STATE DEPARTMENT OF HEALTH

HOWARD COUNTY

Septic Tank

1-3 Bedrooms 1000 - allows
4 Bedrooms 1250 - allows

ELLICOTT CITY

DISTRICT 4

Prop well to have 220 sq. ft. effective absorbent area per bedroom

DATE 1/26/72

sidewall area per bedroom below first 6 1/2' of original ground; and maximum depth 1 1/2' - 1.5' depth started 6 ft.

(3,4#) 205' from front property line & 85' from right property line when facing lot from road.

TO: THE COUNTY HEALTH OFFICER
ELLICOTT CITY, MARYLAND

if trench 2-100' length, 5' wide, 10 ft. apart

I, HEREBY, APPLY FOR THE NECESSARY TESTS IN ORDER TO CONSTRUCT (OR RECONSTRUCT) A SEWAGE DISPOSAL SYSTEM.

PROPERTY OWNER Daisy Hill, Joint Venture

ADDRESS 1131 Univ. Blvd. W., Silver Spring, Md. PHONE 649-1500

PROPERTY LOCATION:

SUBDIVISION Daisy Hill Estates LOT NO. Lot 13, Block A, Sec. 7

ROAD AND DESCRIPTION South side of Union Chapel Road, 350' east of Daisy Road

OCCUPANT none PHONE _____

PERSON TO CONSTRUCT SYSTEM _____

ADDRESS _____ PHONE _____

SIZE OF LOT 63,213 sq. ft. TYPE BLDG. three NUMBER OF BEDROOMS _____

IF NOT SINGLE RESIDENCE DESCRIBE _____

SIGNATURE OF APPLICANT Daisy Hill, Joint Venture, By *Ann Rosenberg* Partner

APPROVED BY *C. Steaks* FOR *Prop Well* DATE 4/11/75

(KIND OF SYSTEM)


REJECTED BY _____ FOR _____ DATE _____

(KIND OF SYSTEM)

HOLD PENDING FURTHER TESTS _____ DATE _____

REASONS FOR REJECTION OR HOLDING _____

THIS IS NOT A PERMIT

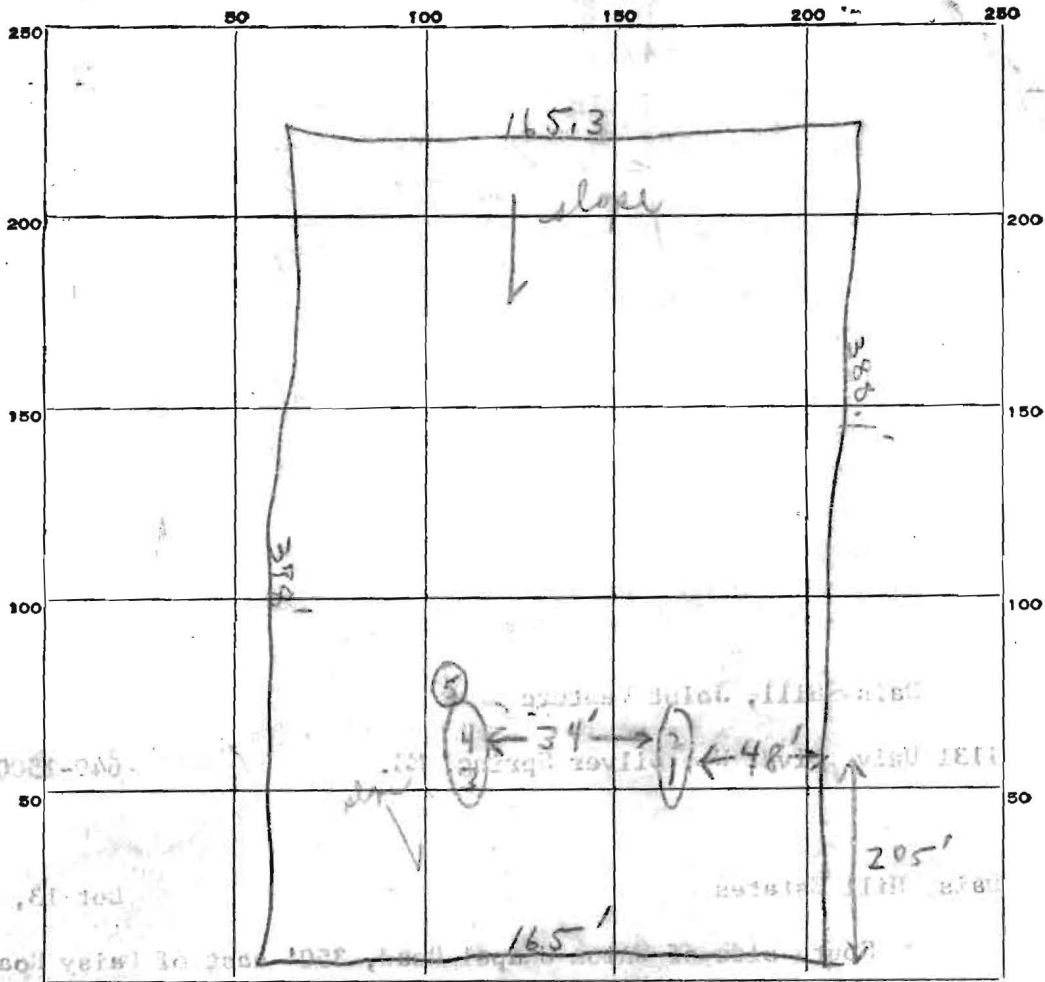

Street Lot 13 Block A

DATE	TEST NO.	DEPTH	PRE-WET		TEST - 1" DROP		TIME	
			START	STOP	START	STOP		
2/10/72	1	6 1/2'	11:46	12:04	12:04	12:33	29 min	
	2	11'	11:46	12:00	12:00	12:25	25 min	
	3	6'	12:31	Top little piece				
	4	11 1/2'	11:50	12:08	12:08	12:30	22 min	
	5	6 1/2'	13:35	13:41	13:41	13:55	14 min	

SOIL AUGER FINDING _____

TESTED BY B.S.

REMARKS _____

APPLICATION

A 16696

P _____

SEWAGE DISPOSAL TESTING

MARYLAND STATE DEPARTMENT OF HEALTH

HOWARD COUNTY

ELLICOTT CITY

DISTRICT 4

DATE 1/26/72

TO: THE COUNTY HEALTH OFFICER
ELLICOTT CITY, MARYLAND

I, HEREBY, APPLY FOR THE NECESSARY TESTS IN ORDER TO CONSTRUCT (OR RECONSTRUCT) A SEWAGE DISPOSAL SYSTEM.

PROPERTY OWNER Daisy Hill, Joint Venture

ADDRESS 1131 Univ. Blvd. W., Silver Spring, Md. PHONE 649-1500

PROPERTY LOCATION:

SUBDIVISION Daisy Hill Estates LOT NO. Lot 13, Block A, Sec. 1

ROAD AND DESCRIPTION South side of Union Chapel Road, 350' east of Daisy Road

OCCUPANT none PHONE _____

PERSON TO CONSTRUCT SYSTEM _____

ADDRESS _____ PHONE _____

SIZE OF LOT 63,213 sq. ft. TYPE BLDG. three
NUMBER OF BEDROOMS _____

IF NOT SINGLE RESIDENCE DESCRIBE _____

SIGNATURE OF APPLICANT Daisy Hill, Joint Venture, By *Simon Rosinsky* Partner


APPROVED BY _____ FOR _____ DATE _____
(KIND OF SYSTEM)

REJECTED BY _____ FOR _____ DATE _____
(KIND OF SYSTEM)

HOLD PENDING FURTHER TESTS _____ DATE _____

REASONS FOR REJECTION OR HOLDING _____

THIS IS NOT A PERMIT

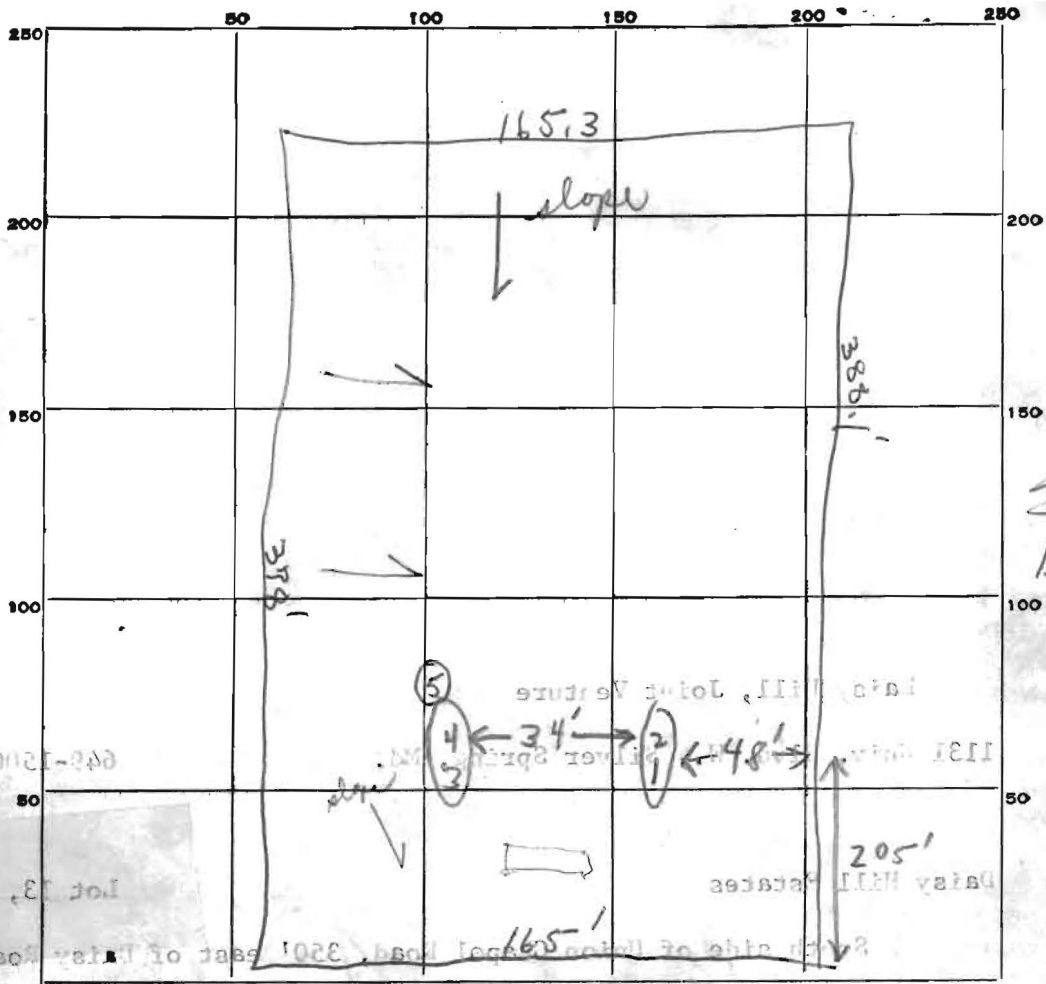

300 A BR
In 5 1/2
Bot 9 1/2

INDICATE NORTH. - NAME ADJOINING ROADWAY AS BASE LINE.

Street Lot 13 Block A

DATE	TEST NO.	DEPTH	PRE-WET		TEST - 1" DROP		TIME
			START	STOP	START	STOP	
2/10/72	1	6 1/2'	11:46	12:04	12:04	12:33	29 min
	2	11'	11:46	12:00	12:00	12:25	25 min
	3	6'	12:31	Top little perc.			
	4	11 1/2'	11:50	12:08	12:08	12:30	22 min
	5	6 1/2'	13:35	13:41	13:41	13:55	14 min
						4/90	22 min
						2/1070	unlet 4'
(4/12/77		Visual 12 1/2' - dry					good 6 1/2'
							220 yds

Hold
see above
unlet 4'
good 6 1/2'
220 yds

SOIL AUGER FINDING

TESTED BY

B.S.

REMARKS

Use holes 3+45