


SADDLER CREEK

4045

AP
4041
brn
Salm
4'
White
Salm
w/
pockets
tan
Salm
13'

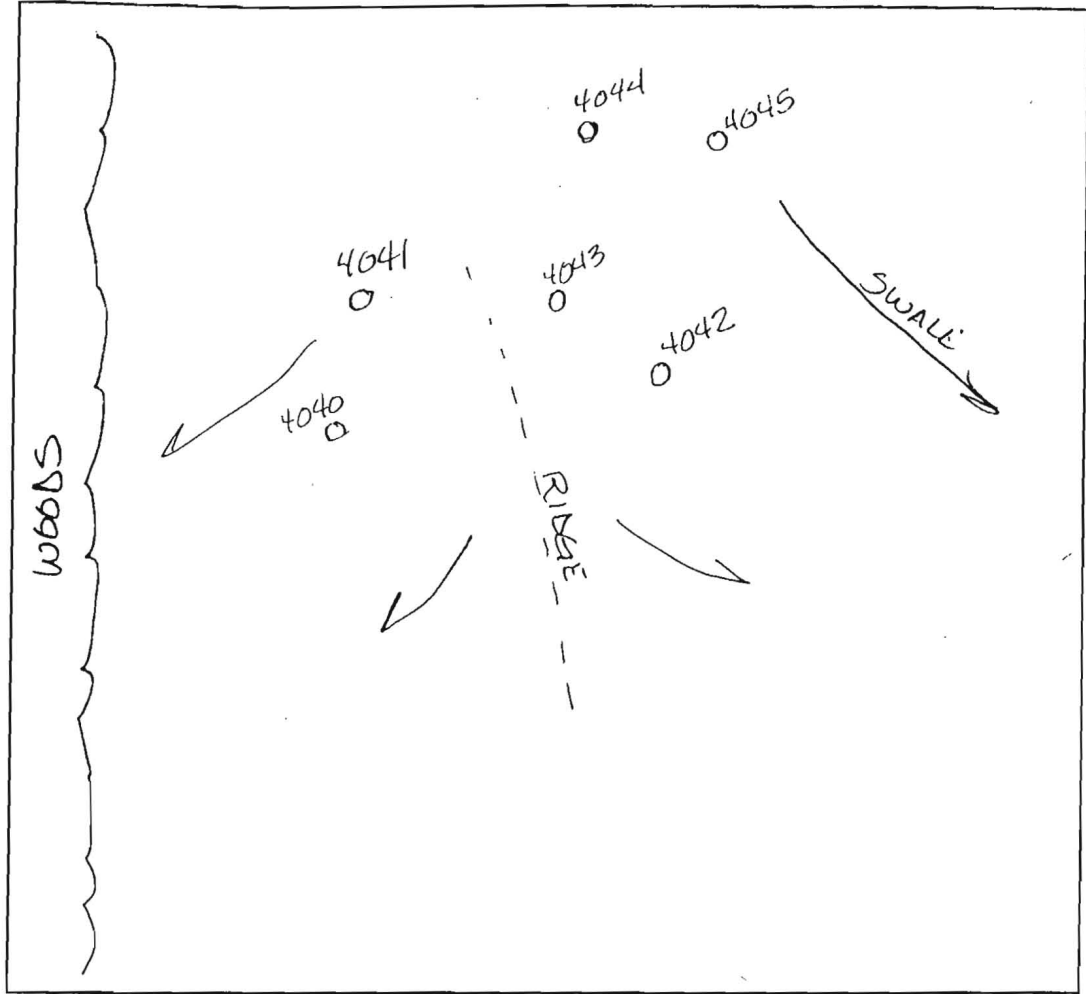

4 1/2'
or brn
CLM
10%
rock
or brn
Salm
B'

4043
or brn
Salm
3 1/2'
lgt
tan
Salm
< 5%
decayed
feldspar

DATE	TEST #	DEPTH	START	BREAK 1" DROP	STOP 2" DROP	TIME OF 2nd INCH	P/F/H
8-22-04	4041	4 1/2' / 13'	8:33	8:35	8:41	6 min	P
	4043	Visual to 13'					P
	4042	4 1/2' / 13'	8:40	8:52	8:20	28 min	P
	4045	5' / 113'	9:04	9:10	9:23	13 min	P
	4044	5' / 113'	8:58	9:00	9:03	3 min	P

4042
or
brn
Salm
3'
or tan
Salm
w/
many
pockets
white
decayed
feldspar
gravel
13'
5%

Empty box

Empty box

REMARKS _____


SANITARIAN Amy Hart BACKHOE Zepp OTHERS _____

TEST HOLES USED IN SDA _____ AVG. PERC TIME _____ SQ. FT/BR _____

TRENCH WIDTH _____ INLET DEPTH _____ MAX. BOT DEPTH _____ EFFECTIVE S/W _____

BASSLER PROP

AP 4046
 or
 brn
 CILM
 1590
 rock
 5'
 or tan
 salm
 ↓
 13'
 4049
 4047
 red
 brn
 CILM
 4'
 brn
 salm
 4048
 red
 brn
 salm
 4
 brn
 salm
 water @
 13 1/2'
 4'

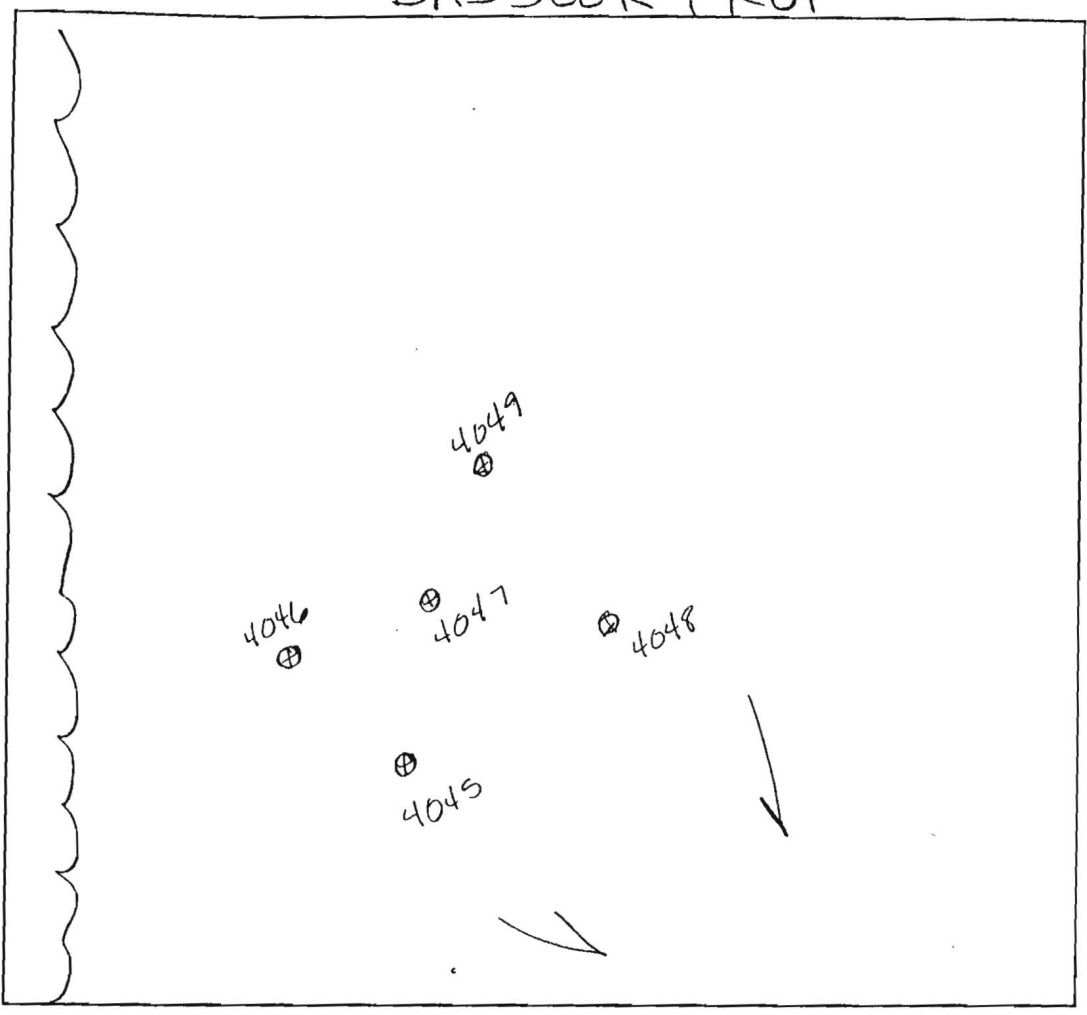


DATE	TEST #	DEPTH	START	BREAK 1" DROP	STOP 2" DROP	TIME OF 2nd INCH	P/F/H
8-22-04	4046	5 1/2 V13'	9:09	9:15	9:25	10min	P
	4047	Visual	40	14'			P
	4049	4 1/2 V13'	9:18	9:30	9:55	25min	P
	4048	4 1/2 V14'	9:25	9:28	9:45	17min	P

REMARKS Holes opened @ 8:00 checked H₂O @ 11:00 am
 SANITARIAN Amy Hart BACKHOE _____ OTHERS _____
 TEST HOLES USED IN SDA _____ AVG. PERC TIME _____ SQ. FT/BR _____
 TRENCH WIDTH _____ INLET DEPTH _____ MAX. BOT DEPTH _____ EFFECTIVE S/W _____

BADDER TRUCK

4039

A/P
4037
no distinct clay layer
lgt tan Salm
<5% decayed saprolite

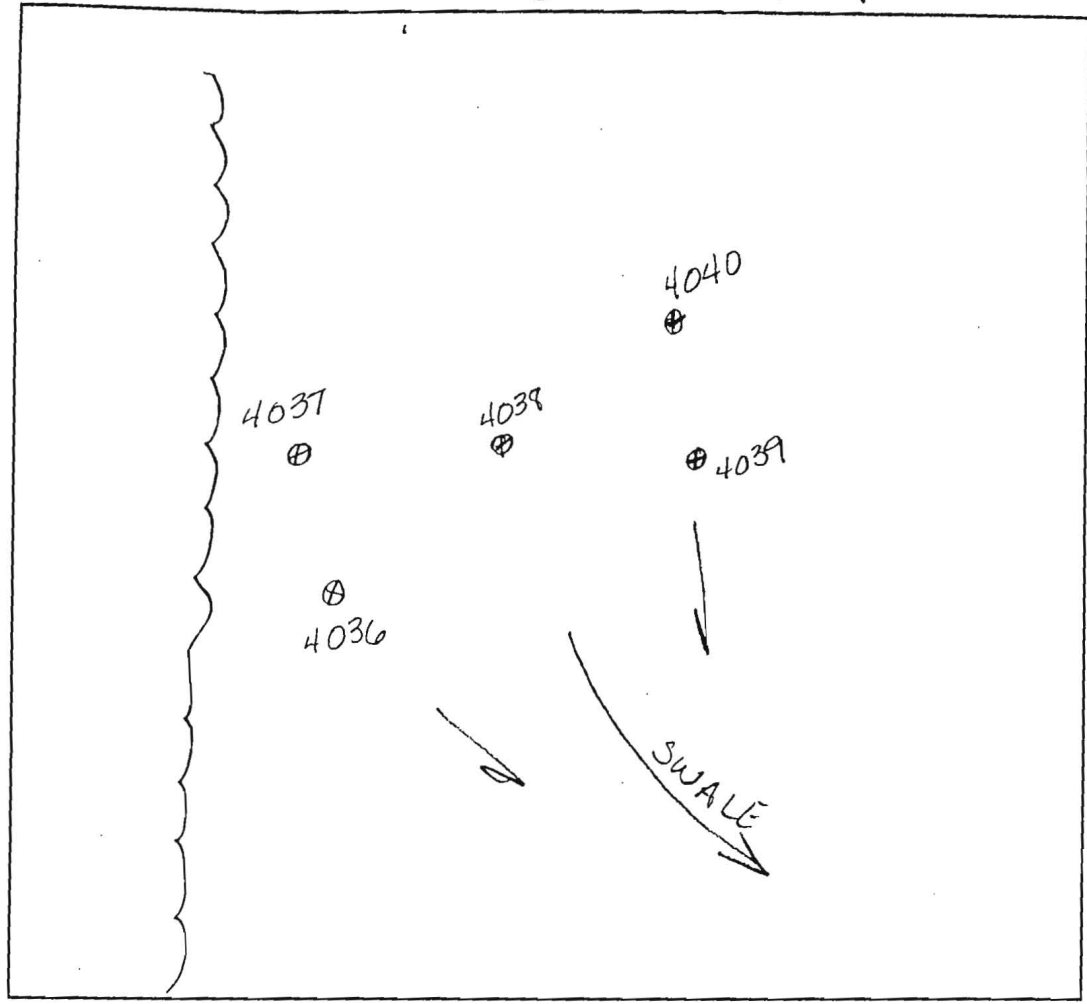

5'
red brn Salm
12'
red brn Salm w/ pockets white Salm

12 1/2'
4036
red brn Salm
5'
red brn Salm

12'
4040
brown cilm
3 1/2'
tan Salm
13'

13'
4038
red brn Salm
3 1/2'
lgt brn Salm
H₂O @ 13 1/2'

DATE	TEST #	DEPTH	START	BREAK 1" DROP	STOP 2" DROP	TIME OF 2nd INCH	P/F/H
8-22-04	4037	3 1/2' / 12 1/2'	8:15	8:17	8:19	2min	P
	4036	5' / 13'	8:19	8:21	8:25	4min	P
	4038	Visual	to 13'	2 H ₂ O @ 13 1/2'			P
	4039	5 1/2' / 12'	8:24	8:51	8:19	28min	P
	4040	5' / 13'	8:28	8:30	8:33	3min	P

REMARKS Holes opened @ 6:30 - H₂O level checked @ 11:00am

SANITARIAN Amy Hart BACKHOE Zepp OTHERS _____

TEST HOLES USED IN SDA _____ AVG. PERC TIME _____ SQ. FT/BR _____

TRENCH WIDTH _____ INLET DEPTH _____ MAX. BOT DEPTH _____ EFFECTIVE S/W _____

N 574250.00
E 1325250.00

Revised PC + Signal #/14/07

LIMIT OF
PROPOSED BOUNDARY FENCE
(OPEN OR CLOSED)
APPROX. 300' N.W. OF LOT 100

ZONED RC-DEO

ZONED RC-DEO

S 64°53'46" E 3943.50'

50' AGRICULTURAL BUFFER

PRIVATE 24' WIDE USE-IN-COMMON
ACCESS EASEMENT FOR LOTS 98-100 & PARCEL 'A'

PRIVATELY OWNED & MAINTAINED
BUILDABLE
PRESERVATION
PARCEL 'A'
63.24 ac.
EASEMENT HOLDERS: H.O.A. & HO. CO., MD.

4038
10,095 Sq.Ft.


LOT 82
50,540 Sq.Ft.

12,130 Sq.Ft.


10,080 Sq.Ft.

LOT 83
44,206 Sq.Ft.

SEE SHEET 5

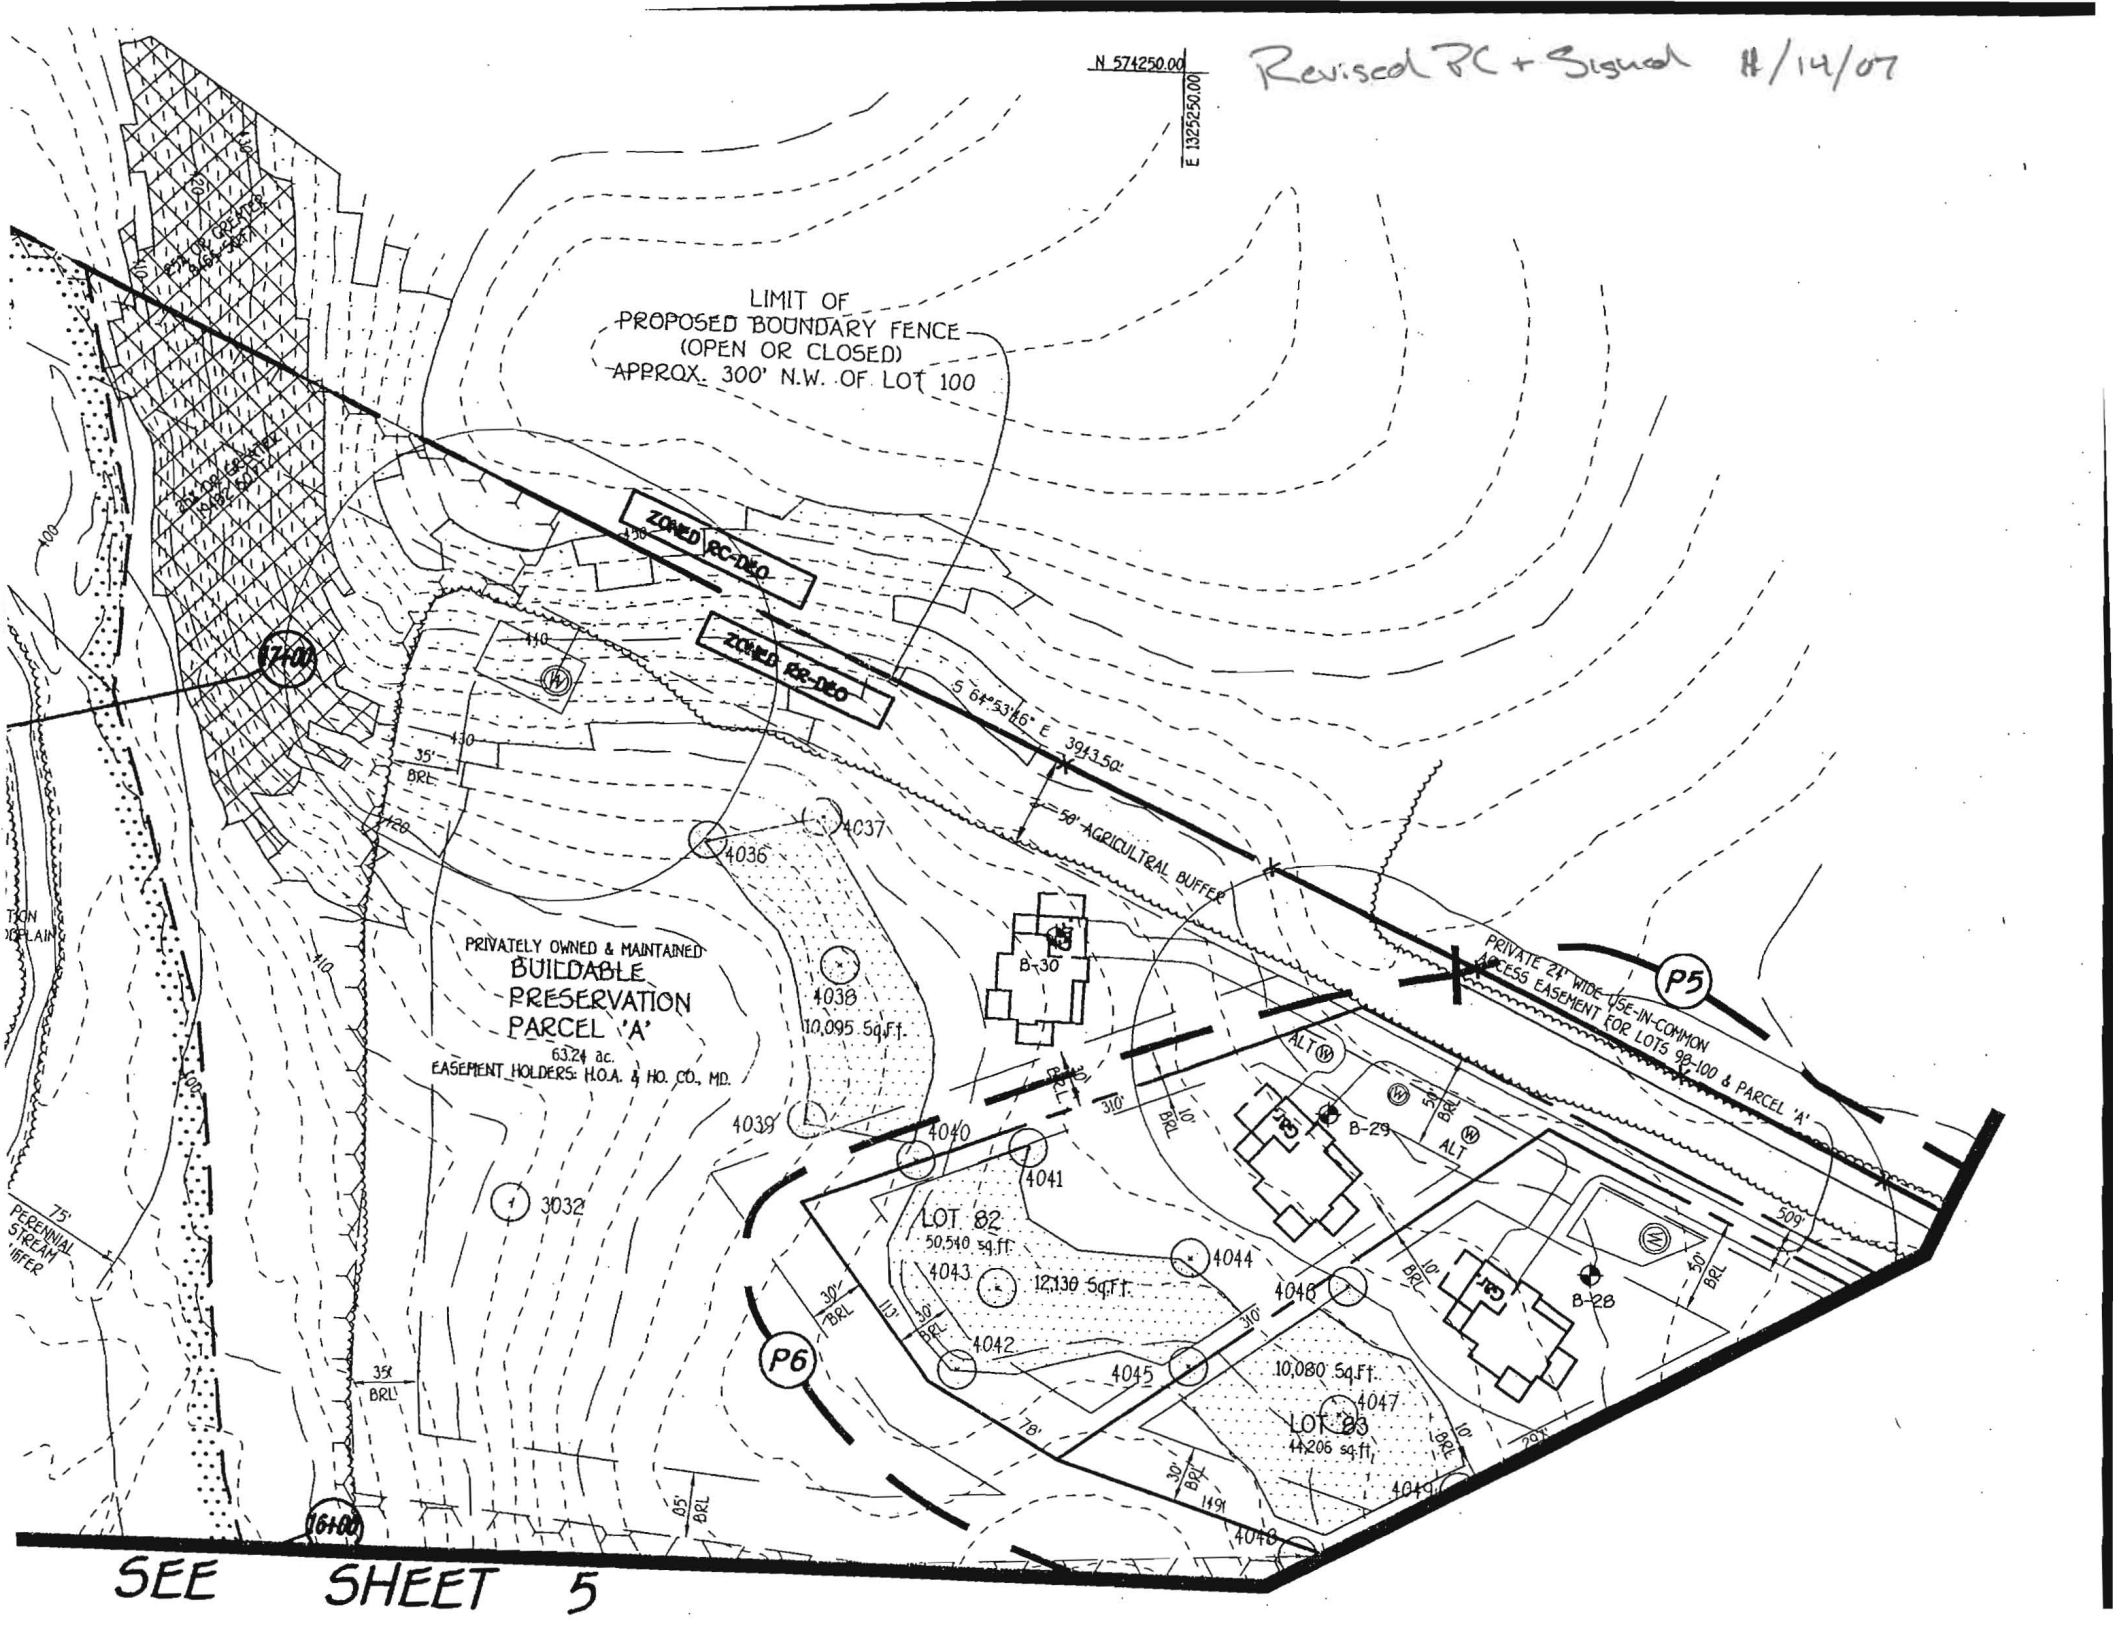

Revised PC + Signed 11/14/07

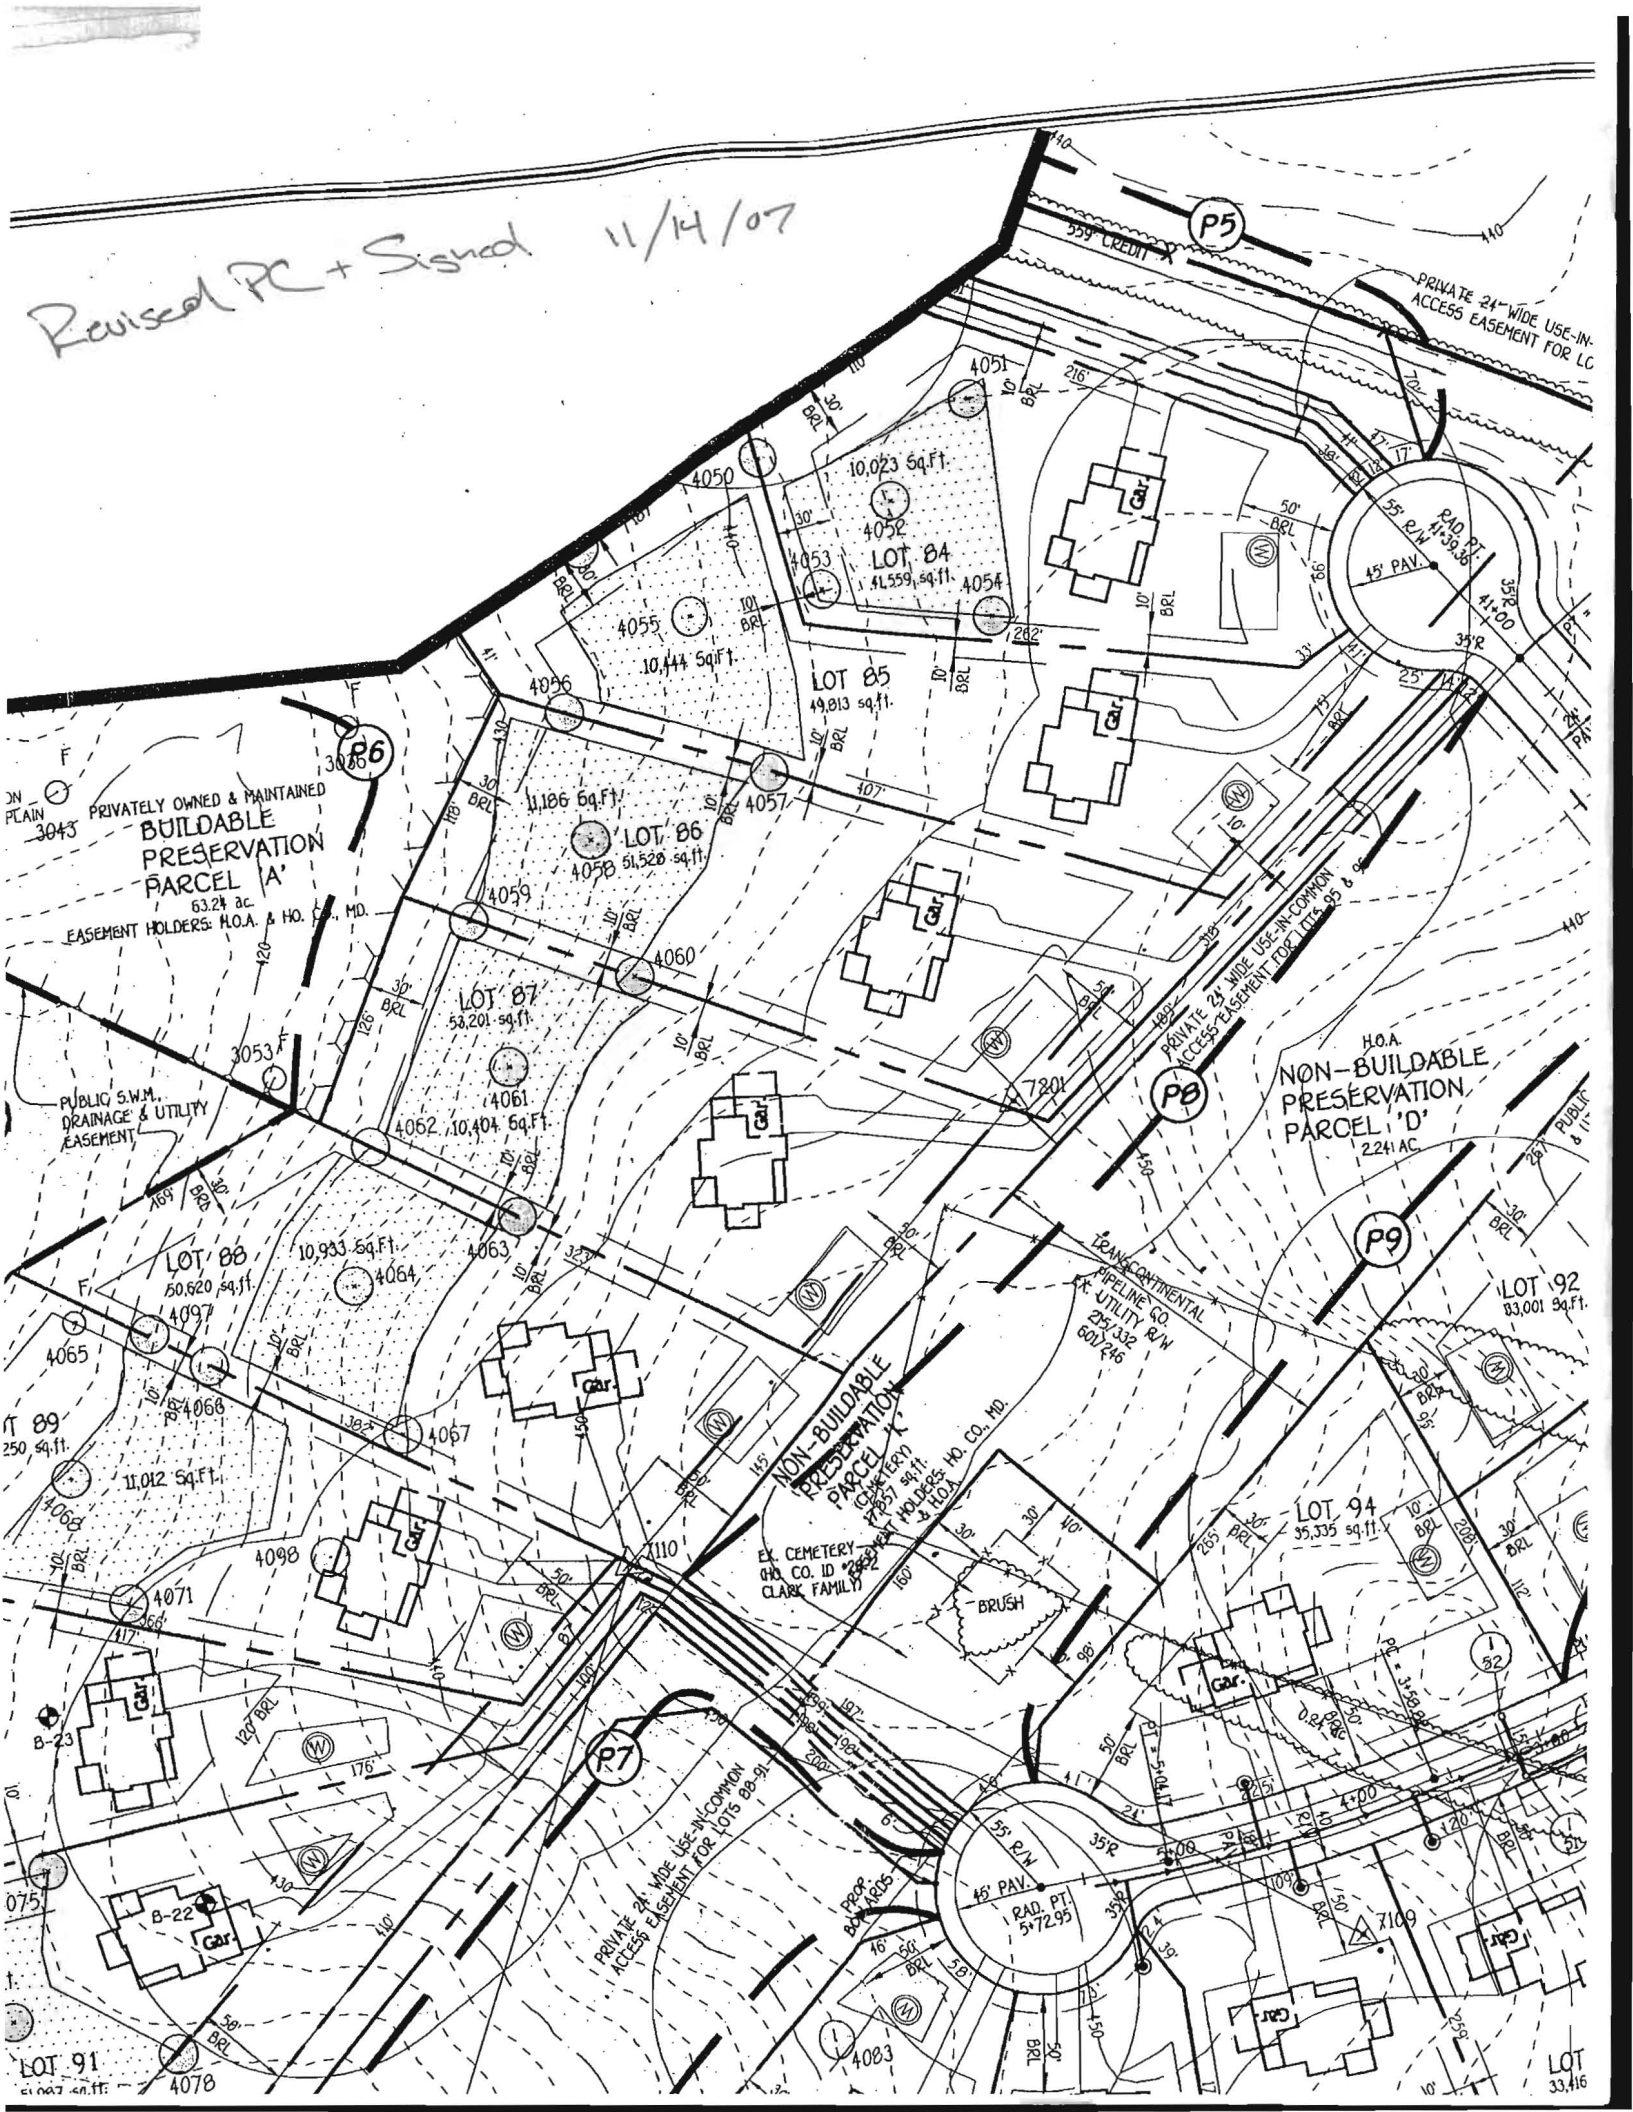

ON FLAIN 3043
PRIVATELY OWNED & MAINTAINED
BUILDABLE PRESERVATION PARCEL 'A'
63.24 ac.
EASEMENT HOLDERS: H.O.A. & HO. CO., MD.

H.O.A.
NON-BUILDABLE PRESERVATION PARCEL 'D'
224 AC

NON-BUILDABLE PRESERVATION PARCEL 'C'
EX. CEMETERY (HO. CO. ID # 283) CLARK FAMILY

PRIVATE 24" WIDE USE-IN-COMMON ACCESS EASEMENT FOR LOTS 88-91

TRANSCONTINENTAL PIPELINE CO. UTILITY R/W 25' 332 60' 246

45' PAV. RAD. PT. 572.95

LOT 91 51,027 sq.ft.

LOT 94 33,416