

4/12/61 - 9:30

# APPLICATION

A 2361

P 04017

SEWAGE DISPOSAL TESTING

MARYLAND STATE DEPARTMENT OF HEALTH

HOWARD COUNTY

ELLICOTT CITY

DISTRICT 5

DATE 2-27-61

750 Tank  
2 - 9" x 12' dry-well.  
30' from left 22' line to 100' from rear lot line.

TO: THE COUNTY HEALTH OFFICER  
ELLICOTT CITY, MARYLAND

I HEREBY, APPLY FOR THE NECESSARY TESTS IN ORDER TO CONSTRUCT OR RECONSTRUCT A SEWAGE DISPOSAL SYSTEM.

PROPERTY OWNER Robbins, W. W.

ADDRESS Clarksville PHONE Atlee 6-2433

PROPERTY LOCATION:

SUBDIVISION Hopkins Meade LOT NO. 30 - Sec. 2 Res.

ROAD AND DESCRIPTION the 1 blk in subdv. lot is in front of road.

OCCUPANT \_\_\_\_\_ PHONE \_\_\_\_\_

PERSON TO CONSTRUCT SYSTEM \_\_\_\_\_

ADDRESS \_\_\_\_\_ PHONE \_\_\_\_\_

SIZE OF LOT 1 acre TYPE BLDG 3  
NUMBER OF BEDROOMS

IF NOT SINGLE RESIDENCE DESCRIBE \_\_\_\_\_

SIGNATURE OF APPLICANT W.W. Robbins

APPROVED BY [Signature] FOR [Signature] DATE 4/12/61  
(NAME OF SYSTEM)


REJECTED BY \_\_\_\_\_ FOR \_\_\_\_\_ DATE \_\_\_\_\_  
(NAME OF SYSTEM)

HOLD PENDING FURTHER TESTS \_\_\_\_\_ DATE \_\_\_\_\_

REASONS FOR REJECTION OR HOLDING \_\_\_\_\_

## THIS IS NOT A PERMIT

NK

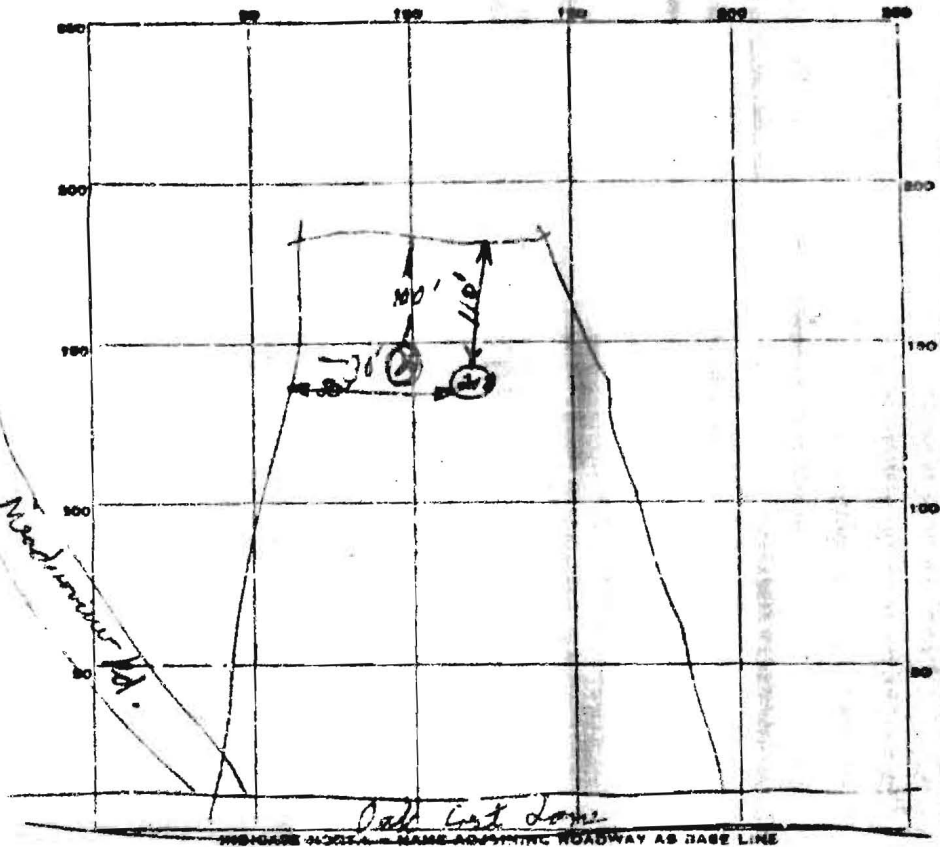

INDICATE NORTH - NAME ADJOINING ROADWAY AS BASE LINE

A 0336 - 3/13/61  
 03570 4-14-61  
 outst

DATE	TEST NO.	DEPTH	PRE-WET		TEST - 1" DROP		TIME
			START	STOP	START	STOP	
3/13/61	1 <sup>A</sup>	10'	1:16	2:35	2:35	3:00	25
4-14-61	2	10'	10:05	11:05	1/2 inch		
	3	6'	10:31	11:01	1/2 inch		

4-14-61 SOIL AUGER FINDING clay  
 REQUESTED BY W. M. Robbins  
 REMARKS Holes 2 + 3 Rock + clay  
 ALSO PRESENT W. M. Robbins LOT NO. 31 \* Sect. 2