

APPLICATION

PERCOLATION TESTING

A 37076

P _____

HOWARD COUNTY HEALTH DEPARTMENT
BUREAU OF ENVIRONMENTAL HEALTH
P.O. BOX 476 ELLICOTT CITY, MARYLAND 21043
TELEPHONE: 461-9933

DISTRICT _____

DATE _____

TO: THE COUNTY HEALTH OFFICER
ELLICOTT CITY, MARYLAND

I, HEREBY, APPLY FOR THE NECESSARY TEST IN ORDER TO CONSTRUCT (OR RECONSTRUCT) A SEWAGE DISPOSAL SYSTEM.

PROPERTY OWNER DAVID E. BAXTER Brighton Dam Limited Partnership Highland Meadows Estates Ltd. Part.
6228 Clearwood Road
ADDRESS Bethesda, MD 20817 PHONE 301-229-8838

PROSPECTIVE BUYER Celta Corp.
101 Chestnut Street, Suite 125
ADDRESS Gaithersburg, MD 20877 PHONE 301-948-2918

PROPERTY LOCATION: LOT 12 PRELIM
SUBDIVISION Highland Meadows LOT NO. X
ROAD AND DESCRIPTION Highland Road at Brighton Dam Road 13500 NARROW LEAF CT

TAX MAP 34 PARCEL # 169 BLDG. PERMIT SIGNED AND RETURNED 8/25/84 Sewal # 55933 - SFD - 4 Bedroom
SIZE OF LOT 3 AC + TYPE BLDG. SFD BLDG. PERMIT SIGNED AND RETURNED 10/21/89 Sewal # 6006 SFD - 4 Bedroom
(SINGLE FAMILY DWELLING OR COMMERCIAL)

THE SYSTEM INSTALLED UNDER THIS APPLICATION IS ACCEPTABLE ONLY UNTIL PUBLIC FACILITIES BECOME AVAILABLE. I FULLY UNDERSTAND THE FEE CONNECTED WITH THE FILING OF THIS PERC TEST APPLICATION IS NON-REFUNDABLE UNDER ANY CIRCUMSTANCES. I ALSO AGREE TO COMPLY WITH ALL M.O.S.H.A. REQUIREMENTS IN TESTING THIS LOT.

(SIGNATURE OF APPLICANT)

APPROVED BY _____ FOR _____ DATE _____

REJECTED BY _____ FOR _____ DATE _____

HOLD PENDING FURTHER TESTS _____ DATE _____

REASONS FOR REJECTION OR HOLDING 6/5/86 Perc OK Hold for Plat A77

3/4/88 Final approved Prelim also includes Parcel F (orig 16) as part of lot

THIS IS NOT A PERMIT

APPLICATION

PERCOLATION TESTING

A _____

P _____

HOWARD COUNTY HEALTH DEPARTMENT
BUREAU OF ENVIRONMENTAL HEALTH
P.O. BOX 476 ELLICOTT CITY, MARYLAND 21043
TELEPHONE: 461-9933

DISTRICT _____

DATE _____

TO: THE COUNTY HEALTH OFFICER
ELLICOTT CITY, MARYLAND

I, HEREBY, APPLY FOR THE NECESSARY TEST IN ORDER TO CONSTRUCT (OR RECONSTRUCT) A SEWAGE DISPOSAL SYSTEM.

PROPERTY OWNER Brighton Dam Limited Partnership
6228 Clearwood Road
ADDRESS Bethesda, MD 20817 PHONE 301-229-8838

PROSPECTIVE BUYER Celta Corp.
101 Chestnut Street, Suite 125
ADDRESS Gaithersburg, Md 20877 PHONE 301-948-2918

PROPERTY LOCATION:

SUBDIVISION Highland Meadows LOT NO. 17

ROAD AND DESCRIPTION ~~Highland Road at Brighton Dam Road~~ NARROW LEAF CT

TAX MAP 34 PARCEL # 169

SIZE OF LOT 3 AC + TYPE BLDG. SFD
(SINGLE FAMILY DWELLING OR COMMERCIAL)

THE SYSTEM INSTALLED UNDER THIS APPLICATION IS ACCEPTABLE ONLY UNTIL PUBLIC FACILITIES BECOME AVAILABLE. I FULLY UNDERSTAND THE FEE CONNECTED WITH THE FILING OF THIS PERC TEST APPLICATION IS NON-REFUNDABLE UNDER ANY CIRCUMSTANCES. I ALSO AGREE TO COMPLY WITH ALL M.O.S.H.A. REQUIREMENTS IN TESTING THIS LOT.

(SIGNATURE OF APPLICANT)

APPROVED BY _____ FOR _____ DATE _____

REJECTED BY _____ FOR _____ DATE _____

HOLD PENDING FURTHER TESTS _____ DATE _____

REASONS FOR REJECTION OR HOLDING _____


THIS IS NOT A PERMIT

2.0
19


Lot 17

CT


5

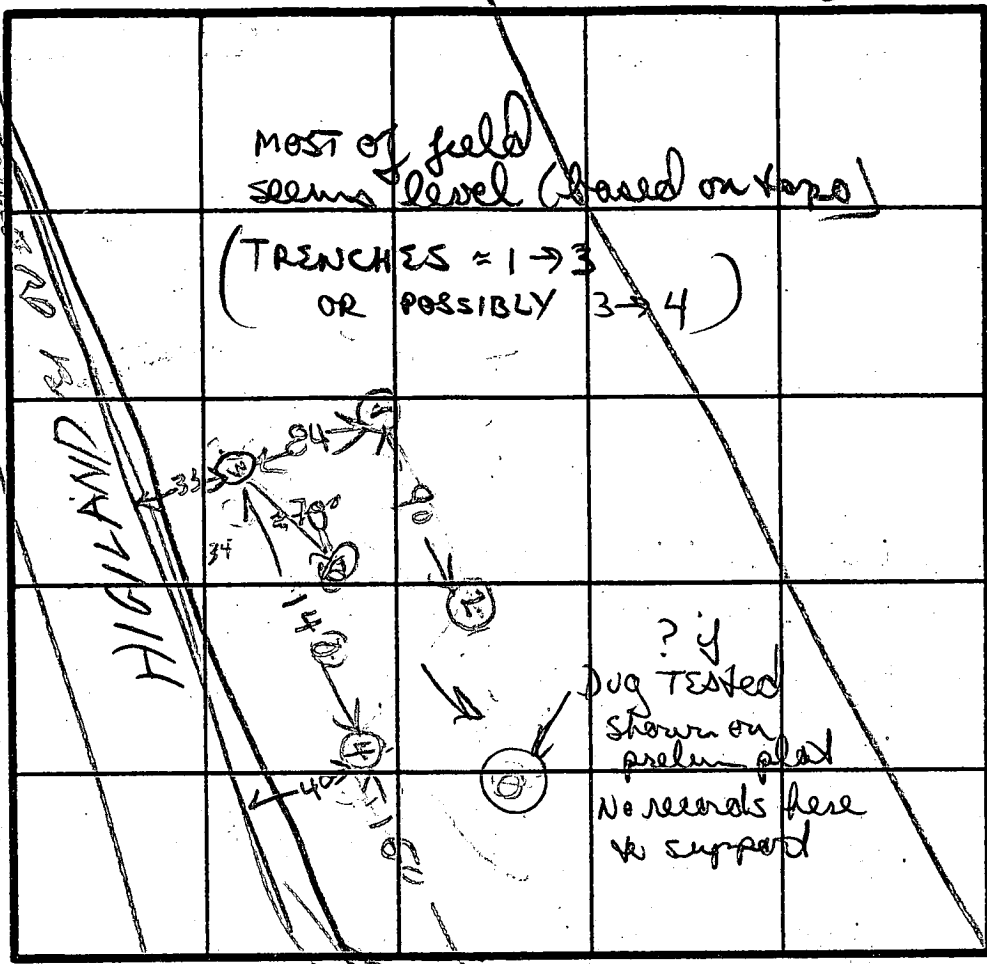

SOIL PROFILE

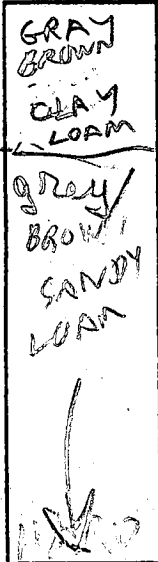

12' Deep

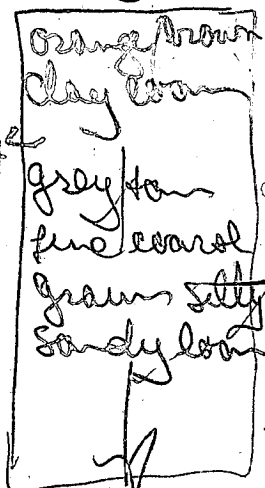

13 1/2' Deep

E.P. REC
3 min
TWT 4-3
BOTTOM 6-3


INDICATE NORTH NAME ADJOINING ROADWAY AS BASE LINE.

DATE	TEST NO.	DEPTH	PRE-WET		TEST 1' DROP		TIME
			START	STOP	START	STOP	
6/4/86	15	3 1/2	1112	1154	1113	1115	
	17	6	1112	1113	1113	1115	
6/4/86	18	9	UN4A T.C	ROCK	BOOF	850W	
	25	3 1/2	1118	1123	1123	1129	6
	27	10 1/2	1119	1121	1121	1123	?
	28	14					
	35	14.5	1131	1132	1132	1134	2
	33V	14	20026	31K			
6/4/86	45	3.5	1142	1145	1145	1147	2 MIN
	4V	14	20026	21K			
	1M	5's	340	342	342	345	3 MIN
	1V deeper	12' deep (see profile)					
	5V	13 1/2' 0					

REMARKS Annual Late Well Grout 1st Hole Dreg per Survey Plan

TYPE OF SOIL _____
TESTED BY R. HODGES B.M.H. CO. ALSO PRESENT BOO KNOX CO.

84
90
117
39

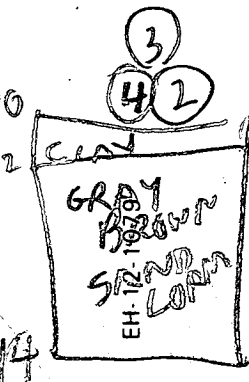

14

APPLICATION

PERCOLATION TESTING

A 37075

P _____

HOWARD COUNTY HEALTH DEPARTMENT
BUREAU OF ENVIRONMENTAL HEALTH
P.O. BOX 476 ELLICOTT CITY, MARYLAND 21043
TELEPHONE: 461-9933

DISTRICT _____

DATE _____

TO: THE COUNTY HEALTH OFFICER
ELLICOTT CITY, MARYLAND

I, HEREBY, APPLY FOR THE NECESSARY TEST IN ORDER TO CONSTRUCT (OR RECONSTRUCT) A SEWAGE DISPOSAL SYSTEM.

PROPERTY OWNER Brighton Dam Limited Partnership
6228 Clearwood Road
ADDRESS Bethesda, MD 20817 PHONE 301-229-8838

PROSPECTIVE BUYER Celta Corp.
101 Chestnut Street, Suite 125
ADDRESS Gaithersburg, MD 20877 PHONE 301-948-2918

PROPERTY LOCATION:
SUBDIVISION Highland Meadows LOT NO. 16

*PARCEL E ON PRELIM
INCORPORATE INTO ADJACENT
LOT*

ROAD AND DESCRIPTION Highland Road at Brighton Dam Road

TAX MAP 34 PARCEL # 169

SIZE OF LOT 3 AC + TYPE BLDG. SFD
(SINGLE FAMILY DWELLING OR COMMERCIAL)

THE SYSTEM INSTALLED UNDER THIS APPLICATION IS ACCEPTABLE ONLY UNTIL PUBLIC FACILITIES BECOME AVAILABLE. I FULLY UNDERSTAND THE FEE CONNECTED WITH THE FILING OF THIS PERC TEST APPLICATION IS NON-REFUNDABLE UNDER ANY CIRCUMSTANCES. I ALSO AGREE TO COMPLY WITH ALL M.O.S.H.A. REQUIREMENTS IN TESTING THIS LOT.

(SIGNATURE OF APPLICANT)

APPROVED BY _____ FOR _____ DATE _____

REJECTED BY _____ FOR _____ DATE _____

HOLD PENDING FURTHER TESTS _____ DATE _____

REASONS FOR REJECTION OR HOLDING 6/5/86 DIG MORE IN WET SEASON R/H
LOT FAILED

3/4/88 Incorporated into lot 12 on approved Prelim

THIS IS NOT A PERMIT

APPLICATION

PERCOLATION TESTING

A _____

P _____

HOWARD COUNTY HEALTH DEPARTMENT
BUREAU OF ENVIRONMENTAL HEALTH
P.O. BOX 476 ELLICOTT CITY, MARYLAND 21043
TELEPHONE: 461-9933

DISTRICT _____

DATE _____

TO: THE COUNTY HEALTH OFFICER
ELLICOTT CITY, MARYLAND

I, HEREBY, APPLY FOR THE NECESSARY TEST IN ORDER TO CONSTRUCT (OR RECONSTRUCT) A SEWAGE DISPOSAL SYSTEM.

PROPERTY OWNER Brighton Dam Limited Property
6228 Clearwood Road
ADDRESS Bethesda, MD 20817 PHONE 301-229-8838

PROSPECTIVE BUYER Celta Corp.
101 Chestnut Street, Suite 125
ADDRESS Gaithersburg, MD 20877 PHONE 301-948-2918

PROPERTY LOCATION:

SUBDIVISION Highland Meadows LOT NO. 16

ROAD AND DESCRIPTION Highland Road at Brighton Dam Road

TAX MAP 34 PARCEL # 169

SIZE OF LOT 3 AC + TYPE BLDG. SFD
(SINGLE FAMILY DWELLING OR COMMERCIAL)

THE SYSTEM INSTALLED UNDER THIS APPLICATION IS ACCEPTABLE ONLY UNTIL PUBLIC FACILITIES BECOME AVAILABLE. I FULLY UNDERSTAND THE FEE CONNECTED WITH THE FILING OF THIS PERC TEST APPLICATION IS NON-REFUNDABLE UNDER ANY CIRCUMSTANCES. I ALSO AGREE TO COMPLY WITH ALL M.O.S.H.A. REQUIREMENTS IN TESTING THIS LOT.

(SIGNATURE OF APPLICANT)

APPROVED BY _____ FOR _____ DATE _____


REJECTED BY _____ FOR _____ DATE _____

HOLD PENDING FURTHER TESTS _____ DATE _____




REASONS FOR REJECTION OR HOLDING _____

THIS IS NOT A PERMIT

Lot 16

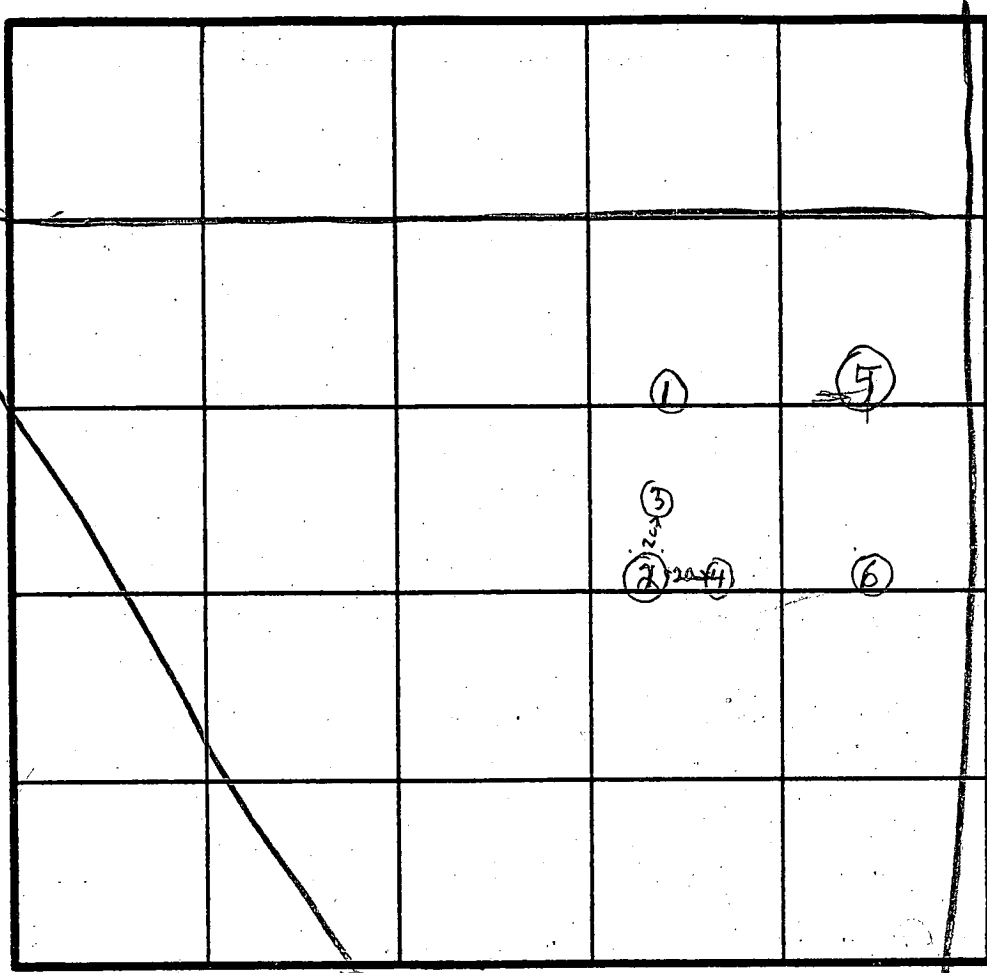

SOIL PROFILE

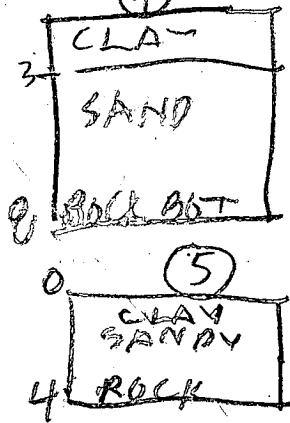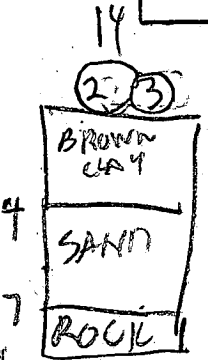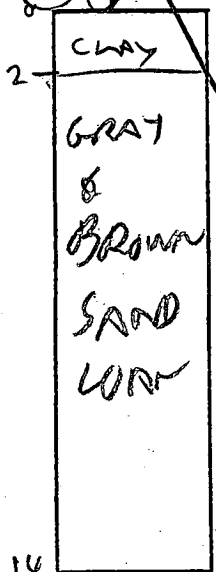

INDICATE NORTH - NAME ADJOINING ROADWAY AS BASE LINE.

~~BRIGHTON PARK~~ A1

DATE	TEST NO.	DEPTH	PRE-WET		TEST - 1" DROP		TIME
			START	STOP	START	STOP	
6/5/86	1V	14	LOOKS O.K.				
	2V	7	ROCK BOTTOM				
	3V	7	ROCK BOTTOM				
	4V	8	ROCK BOTTOM				
	5V	4	ROCK BOTTOM				
6/5/86	6X	14	LOOKS O.K.				

REMARKS: Dig More in Wet Season Must dig extra holes low elevations
 TYPE OF SOIL: Holes ① ④ ⑤ ⑥ Dug Per Surveyor Slope Topography of low area not supportive of testing
 TESTED BY: _____ ALSO PRESENT: _____

EH-12-1079