

THIS REPORT MUST BE SUBMITTED WITHIN 30 DAYS AFTER WELL COMPLETION

FILL IN THIS FORM COMPLETELY

COUNTY NUMBER **A 21502**

STATE OF MARYLAND  
 WATER RESOURCES ADMINISTRATION  
 TAWES STATE OFFICE BLDG., ANNAPOLIS, MD. 21401  
**WELL COMPLETION REPORT**

DATE RECEIVED (WRA USE ONLY) **OCT 31 1975** DEPTH OF WELL **100** PERMIT NO. FROM "PERMIT TO DRILL WELL" **17-0-173-17110**

DATE WELL COMPLETED **10/31/75** DRILLERS IDENTIFICATION NO. **134**

OWNER **DOWN** STREET OR RD. **COOKSVILLE MD** POST OFFICE **COOKSVILLE MD**

**WELL LOG**

STATE THE KIND OF FORMATIONS PENETRATED, THEIR COLOR, DEPTH, THICKNESS AND IF WATER BEARING

DESCRIPTION USE ADDITIONAL SHEETS IF NECESSARY	FEET		CHECK WATER BEARING
	FROM	TO	
<b>DRY SHALE</b>	0	30	
<b>BLUE GRANITE</b>	30	100	✓

**ROUTING RECORD**

WELL HAS BEEN GROUTED (CIRCLE APPROPRIATE BOX)

TYPE OF GROUTING MATERIAL (CIRCLE BOX)

CEMENT  A BENTONITE CLAY  B

NO. OF BAGS **15** NO. OF POUNDS **1410**

GALLONS OF WATER **90**

DEPTH OF GROUT SEAL (TO NEAREST FOOT)

FROM **0** FT. TO **37** FT.

**CASING RECORD**

CASING TYPE (CIRCLE APPROPRIATE BOX)

STEEL  CONCRETE  PLASTIC  OTHER

MAIN CASING TYPE **S T** NOMINAL DIAMETER (TOP INCH) **6** TOTAL DEPTH OF MAIN CASING (NEAREST FOOT) **38**

**OTHER CASING (IF USED)**

DIAMETER (INCH) \_\_\_\_\_ DEPTH (FEET) FROM \_\_\_\_\_ TO \_\_\_\_\_

**SCREEN RECORD**

SCREEN TYPE (CIRCLE APPROPRIATE BOX)

STEEL  BRASS  OPEN MESH  PLASTIC  OTHER

**SCREEN SIZE**

DEPTH (NEAREST WHOLE FOOT)

FROM **110** TO **100**

DIAMETER OF SCREEN \_\_\_\_\_ INCHES

GRAVEL PACK \_\_\_\_\_

IF WELL DRILLED WITH A FLORISSIE WELL (CIRCLE BOX)  P

TELESCOPE CASING \_\_\_\_\_ LOG INDICATOR \_\_\_\_\_ OTHER DATA AVAILABLE \_\_\_\_\_

**PUMPING TEST**

PERMIT NO. FROM "PERMIT TO DRILL WELL" **17-0-173-17110**

HOURS PUMPED (TO NEAREST HOUR) **1**

PUMPING RATE (GALLONS PER MINUTE TO NEAREST GALLON) **10**

METHOD USED TO MEASURE PUMPING RATE **TIME**

WATER LEVEL (DISTANCE FROM LAND SURFACE) BEFORE PUMPING **27** FEET

WHEN PUMPING **100** FEET

TYPE OF PUMP USED (CIRCLE APPROPRIATE BOX)

CENTRIFUGAL  ROTARY  SUBMERSIBLE  TURBINE  OTHER (DESCRIBE BELOW)

**PUMP INSTALLED**

TYPE OF PUMP (WRITE APPROPRIATE LETTER IN BOX - SEE ABOVE)

DRILLER WILL INSTALL PUMP (CIRCLE APPROPRIATE BOX)


CAPACITY: GALLONS PER MINUTE (TO NEAREST GALLON) \_\_\_\_\_

PUMP HORSE POWER \_\_\_\_\_

PUMP COLUMN LENGTH (NEAREST FOOT) \_\_\_\_\_

CASING HEIGHT (CIRCLE APPROPRIATE BOX AND ENTER CASING HEIGHT)

ABOVE  BELOW  LAND SURFACE (NEAREST FOOT)

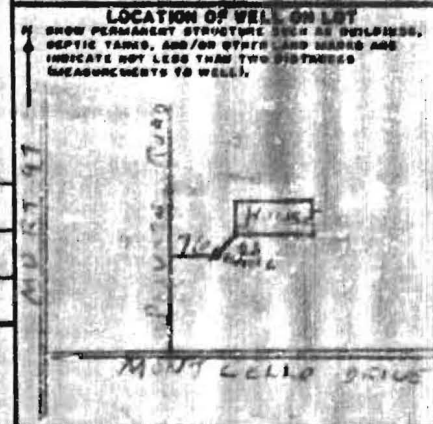

**CIRCLE APPROPRIATE BOXES**

A WELL WAS ABANDONED AND SEALED WHEN THIS WELL WAS COMPLETED

E ELECTRIC LOG OBTAINED

P TEST WELL CONVERTED TO PRODUCTION WELL

I HEREBY CERTIFY THAT I HAVE COMPLIED WITH ALL CONDITIONS STATED ON THE ABOVE-CAPTIONED "PERMIT TO DRILL WELL", AND THAT INFORMATION CONTAINED IN THIS REPORT IS TRUE, ACCURATE, AND COMPLETE TO THE BEST OF MY KNOWLEDGE, INFORMATION AND BELIEF.

DRILLERS NAME **ROBERT CLINE**


TELEPHONE **1-410-326-1111**

SIGNATURE **Robert Cline**

10 T 109

Lot 90

A 21502

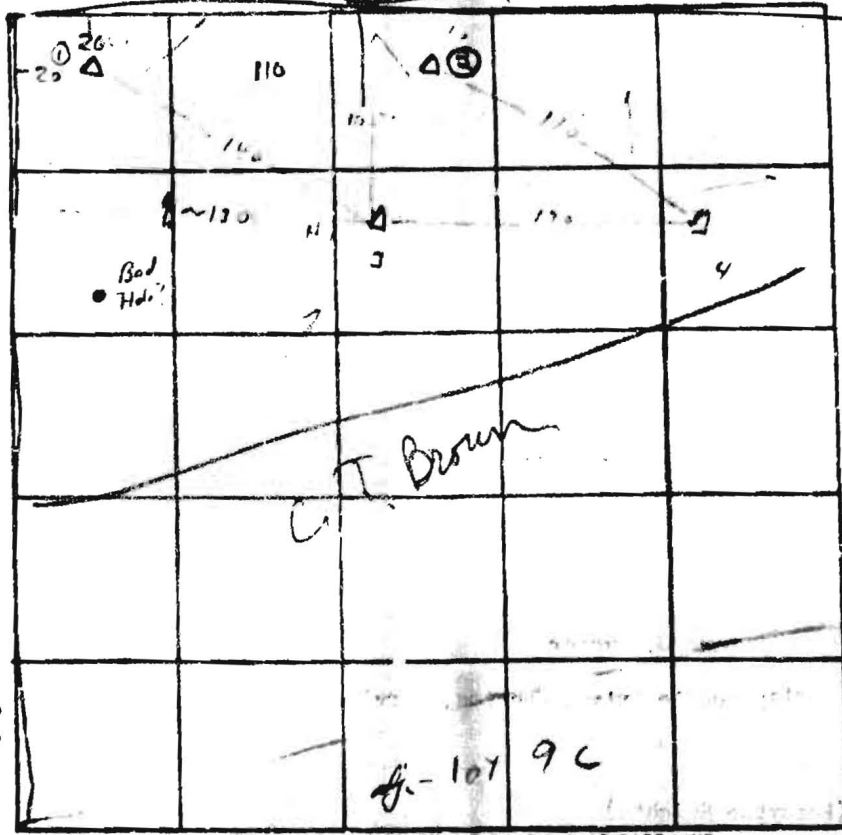

ROW 107 10

1.3737 acres

H-107 9C

INDICATE NORTH - NAME ADJOINING ROADWAY AS BASE LINE

DATE	TEST NO.	DEPTH	PRE-WET		TEST - 1" DRG		TIME
			START	STOP	START	STOP	
Start	1a	4'	11 45	11 55	11 45	11 50	
	19	12'	11 45	11 49	11 47	11 50	3 min
	2s	4'	11 58	12 08	12 04	12 15	12
	2d	12'	11 58	12 06	12 06	12 20	19
	1c	6'	1 37	1 34	1 37	1 38	4
	3s	4'	1 44	1 47	1 47	1 52	5
	3d	12'	1 46	1 53	1 53	2 00	13
	4	12'	1 54	1 58	1 58	2 00	

~  
10 min  
Avg

REMARKS \_\_\_\_\_  
 TYPE OF SOIL \_\_\_\_\_  
 TESTED BY          ALSO PRESENT: