

Bureau of Environmental Health

8930 Stanford Boulevard, Columbia, MD 21045

Main: 410-313-2640 | Fax: 410-313-2648

TDD 410-313-2323 | Toll Free 1-866-313-6300

www.hchealth.org

Facebook: www.facebook.com/hocohealth

Maura J. Rossman, M.D., Health Officer

RECEIPT DATE: 3/1/17 ONSITE SEWAGE DISPOSAL SYSTEM P 560562

APPROVAL DATE: 3/13/17 PERMIT: REPAIR A

PROPERTY ADDRESS: 2877 Evergreen Way

SUBDIVISION: Green Henge LOT: 28 TAX ID: 03-295737

CONTRACTOR: Fogle's Septic Clean Inc. EMAIL: zack@foglesinc.com

CONTRACTOR ADDRESS: 580 Obrecht Road, Sykesville, MD 21784 PHONE: 410-795-5670

PROPERTY OWNER: Frank Iampieri EMAIL:

OWNER ADDRESS: 2877 Evergreen Way, Ellicott City, MD 21042 PHONE: 410-493-0548

SEPTIC TANK SIZE (GALLONS): Existing PUMP CHAMBER CAPACITY (GALLONS): N/A PUMP SIZE: -

NUMBER OF BEDROOMS: 3 HOUSE SQ. FT. APPLICATION RATE: 1.2

DISTRIBUTION SYSTEM: GRAVITY FED [X] LOW PRESSURE DOSED [] App 41 for stone

Table with 2 columns: TRENCHES and dimensions. Includes rows for LINEAR FEET REQUIRED (70'), INLET DEPTH (3'), TRENCH WIDTH (2'), MAXIMUM BOTTOM DEPTH (8'), MINIMUM SPACE BETWEEN TRENCHES (-), and EFFECTIVE AREA BEGINNING DEPTH (4').

LOCATION: TO BE STAKED BY SANITARIAN DURING PRE-CONSTRUCTION INSPECTION.


NOTES: Install 1270' trench below ex. D.W., above perc test A. Dist. Box not required. Ex. D.W. to be pumped & collapsed.

ISSUED BY: K. Wolf ISSUE DATE: 3/10/17 EXPIRATION DATE: 3/10/18

- NOTE: CONTRACTOR MUST SCHEDULE A PRE-CONSTRUCTION INSPECTION PRIOR TO BEGINNING ANY INSTALLATION
NOTE: CONTRACTOR MUST SCHEDULE AN INSPECTION AND GAIN APPROVAL OF ALL COMPONENTS PRIOR TO COVERING
NOTE: STONE MUST BE APPROVED BY HEALTH DEPARTMENT AND GRAVEL TICKET MUST BE AVAILABLE FOR REVIEW.
NOTE: WATERTIGHT SEPTIC TANKS REQUIRED
NOTE: ALL PARTS OF SEPTIC SYSTEM SHALL BE AT LEAST 100 FEET DOWNGRADIENT FROM ANY WATER WELL
NOTE: MANHOLE RISERS REQUIRED ON ALL SEPTIC TANKS AND PUMP CHAMBERS
NOTE: AN ELECTRICAL PERMIT IS REQUIRED FOR INSTALLATION OF ANY ELECTRICAL COMPONENTS OF THE SYSTEM
ELECTRICAL PERMIT ISSUED E N/A
NOTE: THE HCHD DOES NOT WARRANTY ANY SYSTEM AND CANNOT GUARANTEE THE PERFORMANCE OF THIS SYSTEM AS DESIGNED.
NOTE: MDE RECOMMENDS SEPTIC TANKS, BAT, AND OTHER PRETREATMENT UNITS BE PUMPED AT A FREQUENCY ADEQUATE TO ENSURE THAT SOLIDS ARE NOT DISCHARGED TO THE DISPOSAL AREA

NEITHER THE HOWARD COUNTY COUNCIL NOR THE HEALTH DEPARTMENT IS RESPONSIBLE FOR THE SUCCESSFUL OPERATION OF ANY SYSTEM. PERMITTEE RESPONSIBLE FOR OBTAINING FINAL APPROVAL ON THIS PERMIT. CALL 410-313-1771 TO SCHEDULE INSPECTIONS.

NOT TO SCALE

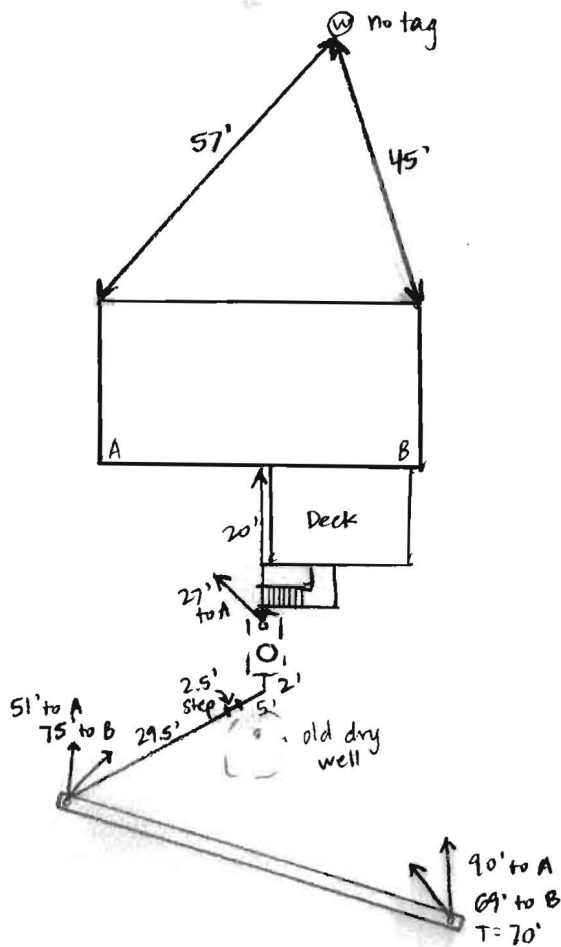

ROAD NAME

TRENCH/DRAINFIELD DATA

WIDTH	INLET	BOTTOM
2'	3'	8'

NUMBER OF TRENCHES 1
 TOTAL LENGTH 70'
 ABSORPTION AREA 70' + SIDEWALL
 DISTRIBUTION BOX LEVEL ---
 DISTRIBUTION BOX BAFFLE ---
 DISTRIBUTION BOX PORT ---

SEPTIC TANK DATA

SEPTIC TANK I LEVEL ?
 MANUFACTURER ?
 CAPACITY ? GAL
 SEAM LOC MID?
 TANK LID DEPTH 6"
 BAFFLES YES
 BAFFLE FILTER NO
 MANHOLE LOC REAR
 6" PORT LOC FRONT
 WATERTIGHT TEST ---
 SLOTTED NO
 DATE ON LID ---

PUMP/SEPTIC TANK LEVEL

~~MANUFACTURER _____
 CAPACITY _____ GAL
 SEAM LOC _____
 TANK LID DEPTH _____
 BAFFLES _____
 BAFFLE FILTER _____
 MANHOLE LOC _____
 6" PORT LOC _____
 WATERTIGHT TEST _____
 SLOTTED _____
 DATE ON LID _____~~

PRE-CONSTRUCTION:

3/10/17 Install 1x70' trench just above perc test (A).
 Ex. D.W. to be pumped and collapsed. No Dist. Box
 required. (Ka)

INSTALLATION: 3/13/17 Trench installed + connected to tank, 2.5' to stone. Observation
 pipe at start + end of trench. Fogle's installed new 6" port and manhole riser in
 tank, also new outlet baffle. Existing 6" terra cotta inlet baffle good. Drywell
 pumped, Fogle's will backfill with dirt. (Sc)

FINAL INSPECTOR Sarah Collins DATE OF APPROVAL 3/13/17



Bureau of Environmental Health

8930 Stanford Boulevard, Columbia, MD 21045

Main: 410-313-2640 | Fax: 410-313-2648

TDD 410-313-2323 | Toll Free 1-866-313-6300

www.hchealth.org

Facebook: www.facebook.com/hocohealth

Twitter: HowardCoHealthDep

Dr. Maura J. Rossman, M.D., Health Officer

INFORMATION FORM - SEPTIC SYSTEM REPAIR/UPGRADE

Reason for Request:

- Reason for Request:
- [x] Failing System
- [] System relocation for proposed addition
- [] System upgrade for proposed addition
- [] Inadequate treatment zone
- [] Collapsed septic tank
- [] Collapsed drywell

Has the septic tank been pumped within the last month?

- Has the septic tank been pumped within the last month?
- [] Yes Date pumped: _____
- [x] No

Was a visual inspection of the septic tank and/or drain fields conducted?

- Was a visual inspection of the septic tank and/or drain fields conducted?
- [] Yes Explain observations: failing drywell.
- [] No

Was a visual inspection of the sewage line conducted?

- Was a visual inspection of the sewage line conducted?
- [] Yes
 - Blockage leading to the tank
 - [] Yes. Explain: _____
 - [] No
 - Blockage leading to the field
 - [] Yes. Explain: _____
 - [] No
- [x] No

Existing system design

- Existing system design
- [x] Drywell
- [] Trench
- [] Mound
- [] Unknown
- [] Other: _____

Is discharge surfacing on the ground?

- Is discharge surfacing on the ground?
- [] Yes
- [x] No

Additional Comments: _____

*For REPAIRS, are the owners proposing, or do they plan to add in the future, any additions or modifications to the property, i.e. pools, living space additions, garages, etc? This information must be disclosed at the time of this application. The Health Department will not be able to accommodate requests in the field for property modifications unrelated to the repair request. Such requests may require an additional fee, testing, and submittal of a Percolation Certification Plan, if the property does not meet current Code and Regulation.

Septic Contractor: Fogles Septic Clean Inc Contractor's Phone: 410-795-5670
Contractor's Address: 580 Obrecht Rd. Sykesville, MD 21784

Property Address: 2077 Evergreen Way County file: HC
Subdivision: Green Henge Lot: 2B Year Built: 1977
Owner's Name: Frank Lampieri Owner's Phone: 410-493-0548

Name of previous owners: Existing bedrooms: 3
Proposed bedrooms:

Has this request been previously discussed with a Sanitarian? (Name):
Public Sewer available/nearby:

*A Sanitarian will be in contact within three business days, depending upon the urgency of the situation, to coordinate the scheduling/review of the repair or upgrade.

Prior to scheduling inspections, scaled plans should be submitted to clarify the nature of the addition.
Print out a copy of Real Property Data via Dept. of Taxation website Indexed file found
If public sewer may be nearby, verify whether sewer is technically "available" through the Bureau of Engineering.
If sewer is available and the property is within the Metropolitan District, connection to sewer is required: If the owner believes reason for exemption exists, the owner should justify the request in writing.
If soil/site conditions are limited and sewer and/or Metro District status is not conducive to connection, the Sanitarian may recommend pursuit of Emergency Sewer Extension or Emergency Metro District Inclusion. The Owner should contact the Bureau of Utilities for details.
No permit is to be issued nor inspection to be scheduled without prior fee collection at the office unless an emergency situation exists. The contractor is to notify office of the emergency situation as soon as possible.