

APPLICATION

A 26895

P _____

SEWAGE DISPOSAL TESTING

STATE OF MARYLAND - DEPARTMENT OF HEALTH AND MENTAL HYGIENE

DISTRICT 3rd

DATE 9/19/77

HOWARD COUNTY HEALTH DEPARTMENT
ENVIRONMENTAL HEALTH SERVICES
P. O. BOX 476, ELLICOTT CITY, MARYLAND 21043
TELEPHONE: 465-5000, EXT. 356

9/30/77
9/29/77
9:30 A.M.

TO: THE COUNTY HEALTH OFFICER
ELLICOTT CITY, MARYLAND

I, HEREBY, APPLY FOR THE NECESSARY TEST IN ORDER TO CONSTRUCT (OR RECONSTRUCT) A SEWAGE DISPOSAL SYSTEM.

PROPERTY OWNER Wilson property
EDWARD J. KASEMEYER

ADDRESS 2590 PEEPERMAN Rd. W. FRIENDSHIP PHONE 442-2297
461-1456

PROPERTY LOCATION: Lot 6 on
Fund of 9/21/79 Lot 5 on Fund Plat

SUBDIVISION HEATHERWOOD LOT NO. 6

ROAD AND DESCRIPTION Rt. 99 1 mi. W. of Rt. 32 ON LEFT

SIZE OF LOT TA Rental Lot 48,290 ac TYPE BLDG. 3
3.073 ac NUMBER OF BEDROOMS

IF NOT SINGLE RESIDENCE DESCRIBE _____

THE SYSTEM INSTALLED UNDER THIS APPLICATION IS ACCEPTABLE ONLY UNTIL PUBLIC FACILITIES BECOME AVAILABLE.

SIGNATURE OF APPLICANT Edward J. Kasemeyer

APPROVED BY _____ FOR _____ DATE _____
(KIND OF SYSTEM)


REJECTED BY _____ FOR _____ DATE _____
(KIND OF SYSTEM)

HOLD PENDING FURTHER TESTS _____ DATE _____

REASONS FOR REJECTION OR HOLDING 9/30/77 Per OK Hold for Plat
10/6/77 Held for Review with FIF Per OK (77)

THIS IS NOT A PERMIT

lot #6

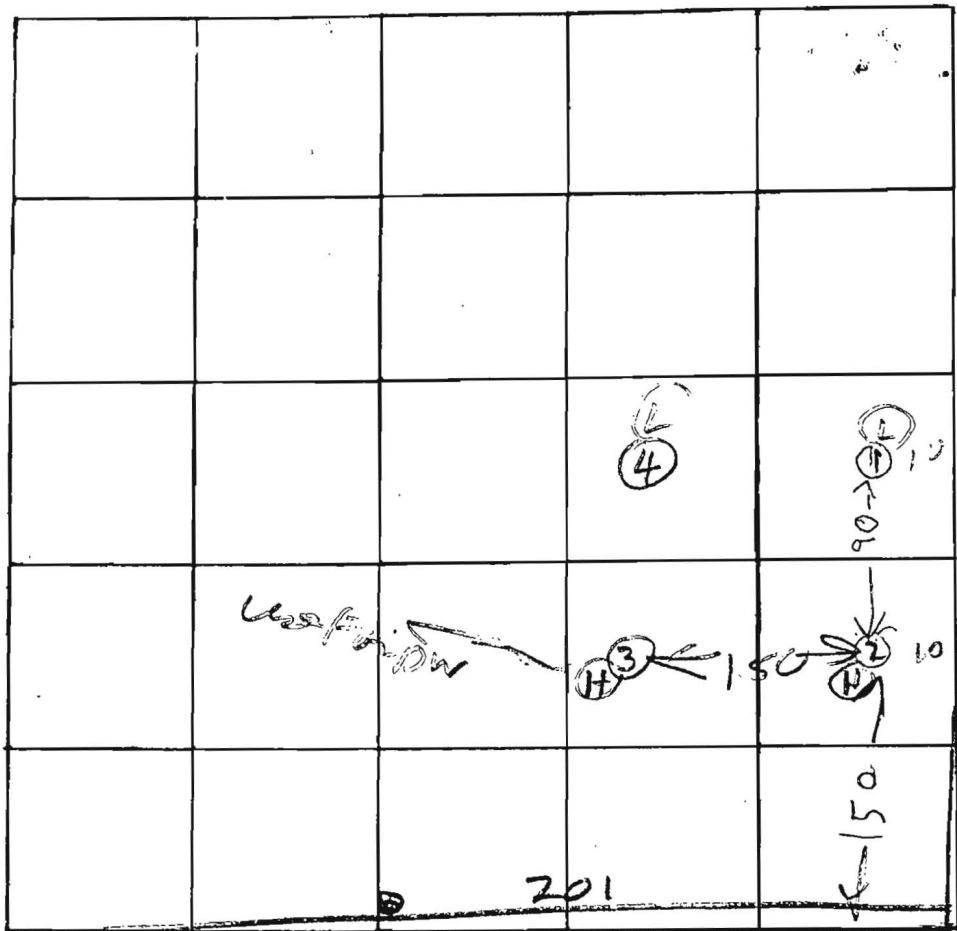

SEE TESTING PLAN

107
See testing plot

INDICATE NORTH - NAME ADJOINING ROADWAY AS BASE LINE

OLD FREDERICK RD

LAST ←

DATE	TEST NO.	DEPTH	PRE-WET		TEST - 1" DROP		TIME	Hole Elevation
			START	STOP	START	STOP		
9/30/57	1S	4	953	1000	1000	1005	5	Low
	1D	11 1/2	1003	1006	1006	1012	6	
	2V	11	TOP 4 FT - CLAY BOT 7 FT - SAND & SANDSTONE					Next to Right
	3S	4	1014	1018	1018	1027	11	HIGH
	3D	11 1/2	1014	1016	1016	1026	10	
	4D	11 1/2	1030	1035	1035	1040	6	Low
	4S	4	1029	1032	1032	1035	3	
9/30/57	4ED	14	TOP 3 FT - CLAY BOT 11 FT - SAND					DRY

REMARKS _____

TYPE OF SOIL _____

TESTED BY B. Rodgers

ALSO PRESENT: R. Barth. Backhoe Co.

46

Oswald, Hank

From: Oswald, Hank
Sent: Wednesday, March 02, 2016 9:50 AM
To: 'texasjeff10@gmail.com'
Subject: 13201 Old Frederick Road Septic Record
Attachments: A26895_03-307417_13201_OLD_FREDERICK_ROAD.pdf; Perc Test and Plan Requirements.pdf

Hi Jeff:

Attached is the septic record for the property. As discussed, in order to receive BP approval from the Health Department for a 2 bedroom addition, percolation testing leading to a Percolation Certification Plan is required to establish a sewage disposal area large enough to accommodate 3 systems. Please see attached requirements.

From what I'm seeing here on the permit, a 1250 tank was installed. This tank is sized for just 4 bedrooms. If your increasing the to 6 bedrooms, then you would be required to upgrade to BAT unit and increase the rest of the system. Currently, the existing drywell plus trench is sized for 3 bedrooms. Depending the condition, you may be able to use them as part of one of required systems.

Should you have any questions, please don't hesitate to ask.

Hank


Hank Oswald, L.E.H.S.
Howard County Health Department
Bureau of Environmental Health
Well & Septic Program
8930 Stanford Boulevard
Columbia, MD 21045
410.313.1786 (Office)
410.313.2648 (Fax)

LEON A. PODOLAK AND ASSOCIATES
SURVEYING AND CIVIL ENGINEERING

63 EAST MAIN STREET, P.O. BOX 266
 WESTMINSTER, MARYLAND 21157
 TELEPHONES: WESTMINSTER 848-2229

BOCKMILLER AND SONS, INC.
 1073 WILDA DRIVE
 WESTMINSTER, MD. 21157

BALTIMORE 876-1226

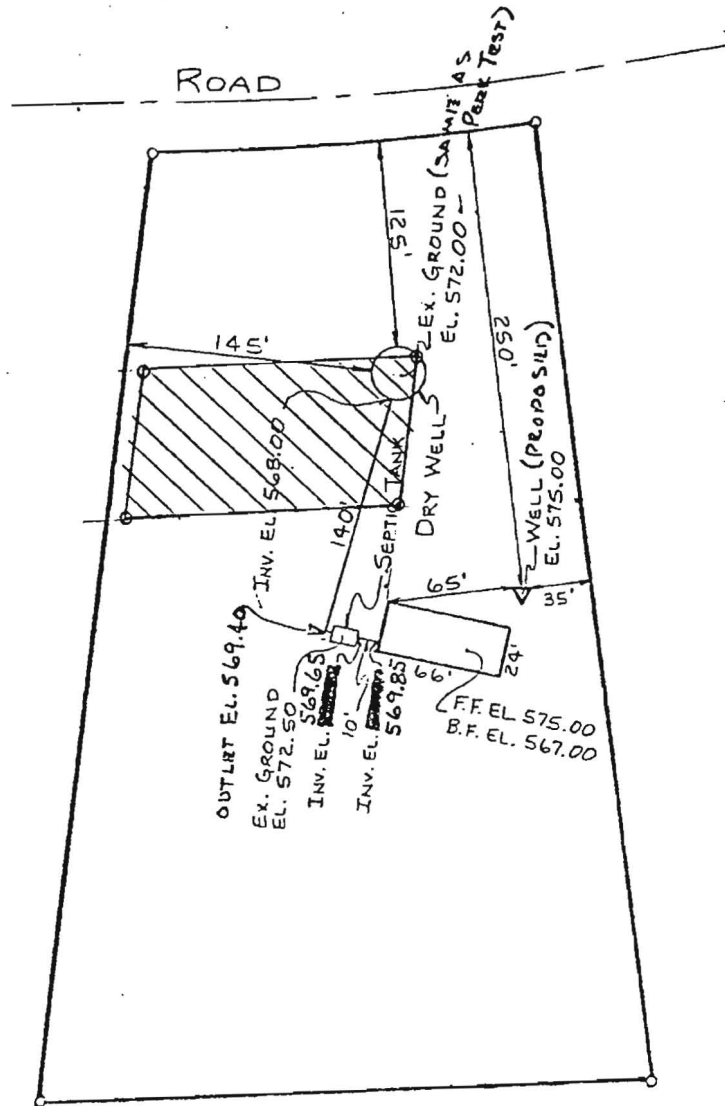

Lot No. 6 HEATHERWOOD
 - WILSON PROPERTY

11/6/80 PLANS OK R/H

I CERTIFY THE ABOVE MEASUREMENTS AND ELEVATIONS
 ARE ACTUAL & CORRECT FOR THIS PROPERTY

SIGNED: *Leon A. Podolak*