

LAYOUT 12/29/03 PM INSP 4 _____
INSP 2 1/16/04 1:00 INSP 5 _____
INSP 3 _____ INSP 6 _____

ISSUE DATE: 12/15/2003

APPROVAL DATE: 1/16/04

PERMIT
TAX ID # 04339371

P 519700

A 517919

ON-SITE SEWAGE DISPOSAL SYSTEM
HOWARD COUNTY HEALTH DEPARTMENT
BUREAU OF ENVIRONMENTAL HEALTH
3525-H ELLICOTT MILLS DRIVE, ELLICOTT CITY, MD 21043

INDEXED

Fogles Septic Clean, Inc IS PERMITTED TO INSTALL ALTER

ADDRESS: 580 Obrecht Road, Sykesville PHONE NUMBER: 410-795-5670

SUBDIVISION: HBL Properties LOT NUMBER: 2

ADDRESS: 14640 Old Frederick Road PROPERTY OWNER: Anderson

SEPTIC TANK CAPACITY (GALLONS): 1250 OUTLET BAFFLE FILTER REQUIRED

PUMP CHAMBER CAPACITY (GALLONS): N/A COMPARTMENTED TANK REQUIRED

NUMBER OF BEDROOMS: 3

SQUARE FEET PER BEDROOM: 180

LINEAR FEET OF TRENCH REQUIRED: 150' @ 10' HOUSE SERVED BY PUBLIC WATER

TRENCHES:	Trench to be 3.0 feet wide. Inlet 5.0 feet below original grade. Bottom maximum depth 7.0 feet below original grade. Effective area begins at 5.0 feet below original grade. 2.0 feet of stone below distribution pipe.
LOCATION:	Place the distribution box on the highest elevation of SDA, 118 feet from the front property line and 75 feet from the right property line when facing the lot from the road. Run trenches in both directions on contour for a total length of 150 feet. PLACE SEPTIC TANK IN AN ACCEPTABLE AREA 10 FEET FROM PROPOSED DECK SHOWN ON PLAN
NOTES:	Basement service by gravity is not proposed. MAY WANT TO CHANGE LOCATION OF INVERT OUT OF HOUSE TO THE SIDE FACING THE SEPTIC AREA

PLANS APPROVED: KN 12/16/03 OK (BB) DATE: 7/2/03

NOTES: PERMIT VOID AFTER 2 YEARS
CONTRACTOR IS RESPONSIBLE FOR SCHEDULING A PRE-CONSTRUCTION INSPECTION FOR ALL INSTALLATIONS
WATERTIGHT SEPTIC TANKS REQUIRED
ALL PARTS OF SEPTIC SYSTEM SHALL BE 100 FEET FROM ANY WATER WELL UNLESS SPECIFICALLY AUTHORIZED
MANHOLE RISERS REQUIRED ON ALL SEPTIC TANKS AND PUMP CHAMBERS UNLESS SPECIFICALLY AUTHORIZED
CONTRACTOR RESPONSIBLE FOR COMPLIANCE WITH APPLICABLE REGULATIONS, GUIDELINES AND THE TERMS OF THIS PERMIT


NEITHER THE HOWARD COUNTY COUNCIL NOR THE HEALTH DEPARTMENT IS RESPONSIBLE FOR THE SUCCESSFUL OPERATION OF ANY SYSTEM PERMITTEE RESPONSIBLE FOR OBTAINING FINAL APPROVAL ON THIS PERMIT

BUILDING PERMIT SIGNED AND RETURNED
DO NOT LEAVE ANY REQUEST FOR INSPECTION ON VOICEMAIL
CALL 410-313-2640 FOR INSPECTION OF SEPTIC SYSTEM

8-14-03 BOD 143606 - REMAINING WALL
1-22-04 BOD 145301 - U6 PROPANE TANK

AS17919

NOT TO SCALE

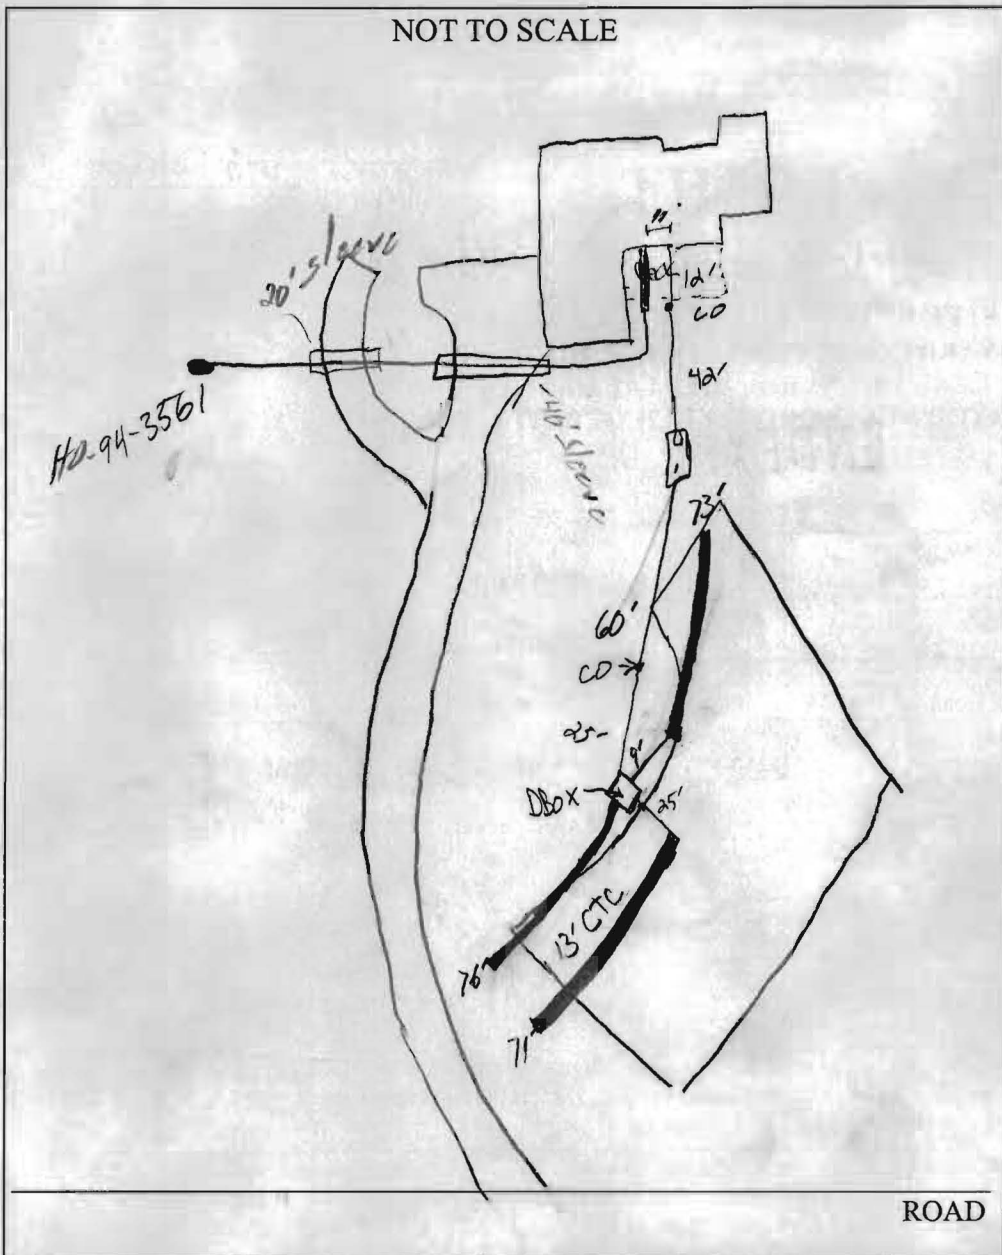

TRENCH/DRAINFIELD DATA		
WIDTH	INLET	BOTTOM
3'	5'	7'
NUMBER OF TRENCHES		3
TOTAL LENGTH		220'
ABSORPTION AREA		660 ft ²
DISTRIBUTION BOX LEVEL		<input checked="" type="checkbox"/>
DISTRIBUTION BOX BAFFLE		<input checked="" type="checkbox"/>
DISTRIBUTION BOX PORT		na

SEPTIC TANK DATA	
SEPTIC TANK 1 LEVEL <input checked="" type="checkbox"/>	
CAPACITY	1500 GAL
SEAM LOC	bp
TANK LID DEPTH	1'
BAFFLES	<input checked="" type="checkbox"/>
BAFFLE FILTER	
MANHOLE LOC	front
6" PORT LOC	Back
WATERTIGHT TEST	na
SEPTIC TANK 2 LEVEL <u>N/A</u>	
CAPACITY	_____ GAL
SEAM LOC	_____
TANK LID DEPTH	_____
BAFFLES	_____
BAFFLE FILTER	_____
MANHOLE LOC	_____
6" PORT LOC	_____
WATERTIGHT TEST	↓

PRE-CONSTRUCTION 12/29/03 - SRA staked, contour flatter than shown. Install (3) 70' trenches w/ D.B. actually out of SRA

INSTALLATION on high side (SO) 1/16/04 tank + (3) 70' + trenches installed ok to cover all work KB

BUILDING PERMIT SIGNED AND RETURNED

FINAL INSPECTOR

[Signature]

DATE OF APPROVAL

1/16/04

