

APPLICATION

A 16702

SEWAGE DISPOSAL TESTING

P _____

MARYLAND STATE DEPARTMENT OF HEALTH

HOWARD COUNTY

ELLICOTT CITY

DISTRICT 4

DATE 12/6/72

TO: THE COUNTY HEALTH OFFICER
ELLICOTT CITY, MARYLAND

I, HEREBY, APPLY FOR THE NECESSARY TESTS IN ORDER TO CONSTRUCT (OR RECONSTRUCT) A SEWAGE DISPOSAL SYSTEM.

PROPERTY OWNER Daisy Hill, Joint Venture

ADDRESS 1131 Univ. Blvd. W., Silver Spring, Md. PHONE 649-1500

PROPERTY LOCATION:

SUBDIVISION Daisy Hill Estates LOT NO. Lot 19, Block A, Sec. Two

ROAD AND DESCRIPTION South side of Union Chapel Road, 350' east of Daisy Road

OCCUPANT none PHONE _____

PERSON TO CONSTRUCT SYSTEM _____

ADDRESS _____ PHONE _____

SIZE OF LOT 133,000 84,025 sq. ft. TYPE BLDG. three

IF NOT SINGLE RESIDENCE DESCRIBE _____

SIGNATURE OF APPLICANT Daisy Hill, Joint Venture, By Sam Ranky Partner


APPROVED BY _____ FOR _____ (KIND OF SYSTEM) _____ DATE _____

REJECTED BY _____ FOR _____ (KIND OF SYSTEM) _____ DATE _____

HOLD PENDING FURTHER TESTS _____ DATE _____

REASONS FOR REJECTION OR HOLDING _____

THIS IS NOT A PERMIT

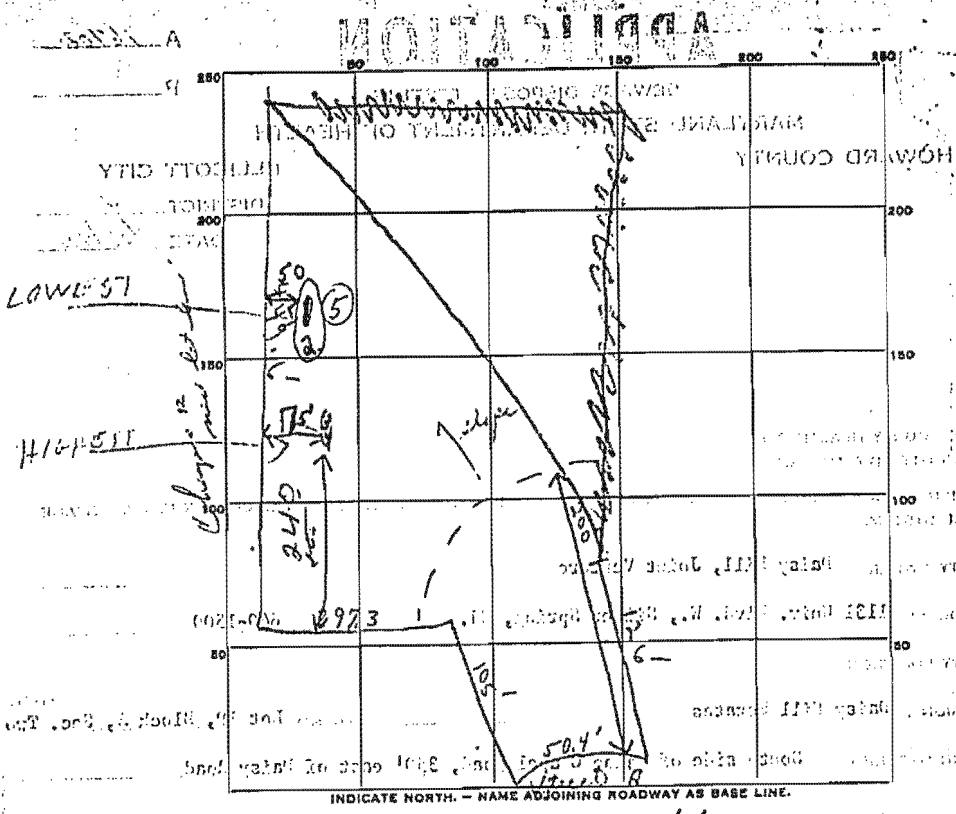

L-19

DATE	TEST NO.	DEPTH	PRE-WET		TEST - 1" DROP		TIME
			START	STOP	START	STOP	
2/10/14	1	3 1/2'	11:02	11:13	11:13	11:21	8 min
	2	9'	11:02	11:06	11:06	11:07	3 min
	3	4'	11:10	11:14	11:14	11:20	6 min
	4	10 1/2'	11:10	11:14	11:14	11:17	4 min
4/15/13	5	12'	DRY	TOP	3 FT LAY	9 FT POROUS	211

Use
VISUAL
FIELD

Rocky had
good soil
5 min average
18.5 ccf/ft
140 ccf/ft

SOIL AUGER FINDING

TESTED BY: *KS*

REMARKS: *TRAILING A 100' IN 2117*

