

# APPLICATION

A 24624

P \_\_\_\_\_

## SEWAGE DISPOSAL TESTING

STATE OF MARYLAND - DEPARTMENT OF HEALTH AND MENTAL HYGIENE

HOWARD COUNTY HEALTH DEPARTMENT  
ENVIRONMENTAL HEALTH SERVICES

ST 3-1000  
4-1250

DISTRICT 3

P O BOX 476, ELLICOTT CITY, MARYLAND 21043  
TELEPHONE: 465-5000, EXT. 356

DATE 9-27-76

Locate the D.W. 170' from Day Rd & 125' from the unnamed road. The inv. will enter the D.W. @ 3' below O.G., with a max D.W. depth of 10' below O.G. Begin the trench 5' from the edge of the D.W. and follow the contour of the land. The trench will be constructed 2' wide, 12' deep, and contain 7' of stone. There will be no less than 175 # of sidewalk / BR in the system.

TO: THE COUNTY HEALTH OFFICER  
ELLICOTT CITY, MARYLAND

2 inspections per

21 Apr 77

I, HEREBY, APPLY FOR THE NECESSARY TEST IN ORDER TO CONSTRUCT (OR RECONSTRUCT) A SEWAGE DISPOSAL SYSTEM.

PROPERTY OWNER James W. Dickey Barry J. Ring

ADDRESS Forsythe Road 3419 Courtleigh 489 7148  
Drive, Balto., Md. 21207

PROPERTY LOCATION:  
SUBDIVISION Day Road Pickey Farms LOT NO. 31

ROAD AND DESCRIPTION End of hard surface road on left,  
Day Road

SIZE OF LOT 2.8789 TYPE BLDG. 3  
NUMBER OF BEDROOMS

IF NOT SINGLE RESIDENCE DESCRIBE \_\_\_\_\_

THE SYSTEM INSTALLED UNDER THIS APPLICATION IS ACCEPTABLE ONLY UNTIL PUBLIC FACILITIES BECOME AVAILABLE.

SIGNATURE OF APPLICANT Charles E. Webber

APPROVED BY R. Morefield FOR D.W. trench DATE 9/77  
(KIND OF SYSTEM)

REJECTED BY \_\_\_\_\_ FOR \_\_\_\_\_ DATE \_\_\_\_\_  
(KIND OF SYSTEM)

HOLD PENDING FURTHER TESTS \_\_\_\_\_ DATE \_\_\_\_\_

REASONS FOR REJECTION OR HOLDING \_\_\_\_\_

# THIS IS NOT A PERMIT

# APPLICATION

A \_\_\_\_\_

P \_\_\_\_\_

## SEWAGE DISPOSAL TESTING

STATE OF MARYLAND - DEPARTMENT OF HEALTH AND MENTAL HYGIENE

HOWARD COUNTY HEALTH DEPARTMENT  
ENVIRONMENTAL HEALTH SERVICES  
P. O. BOX 476, ELLICOTT CITY, MARYLAND 21043  
TELEPHONE: 465-5000, EXT. 356

DISTRICT 3

DATE 9-27-76

TO: THE COUNTY HEALTH OFFICER  
ELLICOTT CITY, MARYLAND

I, HEREBY, APPLY FOR THE NECESSARY TEST IN ORDER TO CONSTRUCT (OR RECONSTRUCT) A SEWAGE DISPOSAL SYSTEM.

PROPERTY OWNER James W. Dickey

ADDRESS Forsythe Road PHONE 489-7148

PROPERTY LOCATION:

SUBDIVISION Day Road LOT NO. 31

ROAD AND DESCRIPTION End of hard surface road on left.

SIZE OF LOT 2.8789 TYPE BLDG. 3  
NUMBER OF BEDROOMS

IF NOT SINGLE RESIDENCE DESCRIBE \_\_\_\_\_

THE SYSTEM INSTALLED UNDER THIS APPLICATION IS ACCEPTABLE ONLY UNTIL PUBLIC FACILITIES BECOME AVAILABLE.

SIGNATURE OF APPLICANT Charles E. Webber

APPROVED BY \_\_\_\_\_ FOR \_\_\_\_\_ DATE \_\_\_\_\_  
(KIND OF SYSTEM)

REJECTED BY \_\_\_\_\_ FOR \_\_\_\_\_ DATE \_\_\_\_\_  
(KIND OF SYSTEM)

HOLD PENDING FURTHER TESTS \_\_\_\_\_ DATE \_\_\_\_\_

REASONS FOR REJECTION OR HOLDING \_\_\_\_\_

# THIS IS NOT A PERMIT

402

33

711/433

32

28

495

439

30

711/486

31

JACKSON

ALL WITH 40  
AND 4000  
LIFT OF

AND 4000



MENT

2-9-77

DATE

Approved  
PERC  
CERT

ONLY FOR  
26, 27

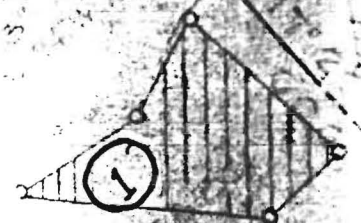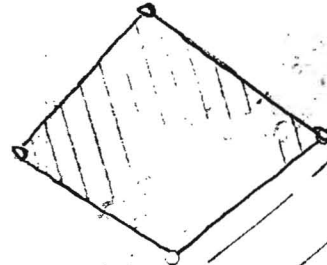

711/516