

4/11/75
9:30 A.M.

4/11/75
Final R. Temp 21335

PERMIT

SEWAGE DISPOSAL SYSTEM

A _____

MARYLAND STATE DEPARTMENT OF HEALTH

HOWARD COUNTY

ELLICOTT CITY

INDEXED

DISTRICT 5th

File

DATE 4/10/75

Jack Fyock

IS PERMITTED TO INSTALL _____ ALTER

ADDRESS Ten Oaks Road, Glenelg, Maryland PHONE 286-22 2939

A SEWAGE DISPOSAL SYSTEM LOCATED AT _____

SUBDIVISION Hopkins Mead ROAD 7401 Oakcrest Lane LOT 1st house on left as you come into Hopkins Mead

PROPERTY OWNER Mr. Jack Bufton

ADDRESS 7401 Oakcrest Lane Phone: 498-5579

SPECIFICATIONS

DRAIN FIELD _____ DEPTH _____ FEET, BOTTOM AREA _____ SQ. FT.

SEEPAGE PITS _____ ABSORBENT SIDE-WALL AREA _____ SQ. FT.

SEPTIC TANK CAPACITY _____ GALLONS

FOR GARBAGE GRINDER, INCREASE DISPOSAL AREA 22% & TANK CAPACITY 50%.

OTHER REPAIR - Call for inspection when ground is opened up and Sanitarian


will recommend repair system. *70 yd trench - top of gravel 4 ft deep*
inspected Mrs. Bufton of poor soil conditions
R.T.

PLANS APPROVED BY Palmer F. Wine DATE 4/10/75

FILL SEPTIC TANK AND DISTRIBUTION BOX WITH WATER BEFORE CALLING FOR AN INSPECTION. COVER NO WORK UNTIL INSPECTED AND APPROVED.

NEITHER THE HOWARD COUNTY COMMISSIONERS NOR THE HEALTH DEPARTMENT IS RESPONSIBLE FOR THE SUCCESSFUL OPERATION OF ANY SYSTEM.

4/21/35

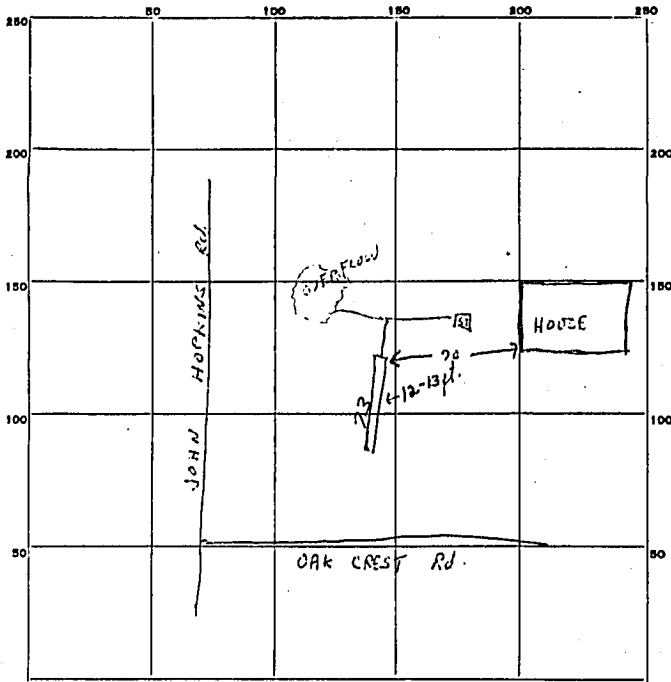

INDICATE NORTH. - NAME ADJOINING ROADWAY AS BASE LINE.

73
6
438

PERMIT CARD Signed

SEPTIC TANK, LEVEL - CLEANOUTS -

DISTRIBUTION BOX, LEVEL -

TILE FIELD, DEPTH 12-13 FT. TRENCH WIDTH 2 FT.

GRAVEL DEPTH 5 1/2 - 7 ft. TOTAL LENGTH 73 FT.

NUMBER OF TRENCHES 1 TOTAL BOTTOM AREA 438 sq ft (one side)

SEEPAGE PITS, INSIDE DIAMETER - FT. DEPTH BELOW INLET - FT.

ABSORBENT AREA - SQ. FT.

REMARKS _____

DATE SYSTEM APPROVED 4/11/75 INSPECTOR R. T. One