


RECEIVED
HOWARD COUNTY
HEALTH DEPT.
ELLCOTT CITY, MD

JAN 16 9 54 AM '80


4/24/80

well location lower elevation than
sewage disposal area.

This granting does not constitute approval
of the well site. Only approval is for
the grant. DWM

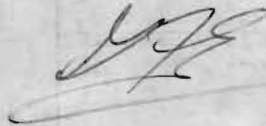

5/1/80

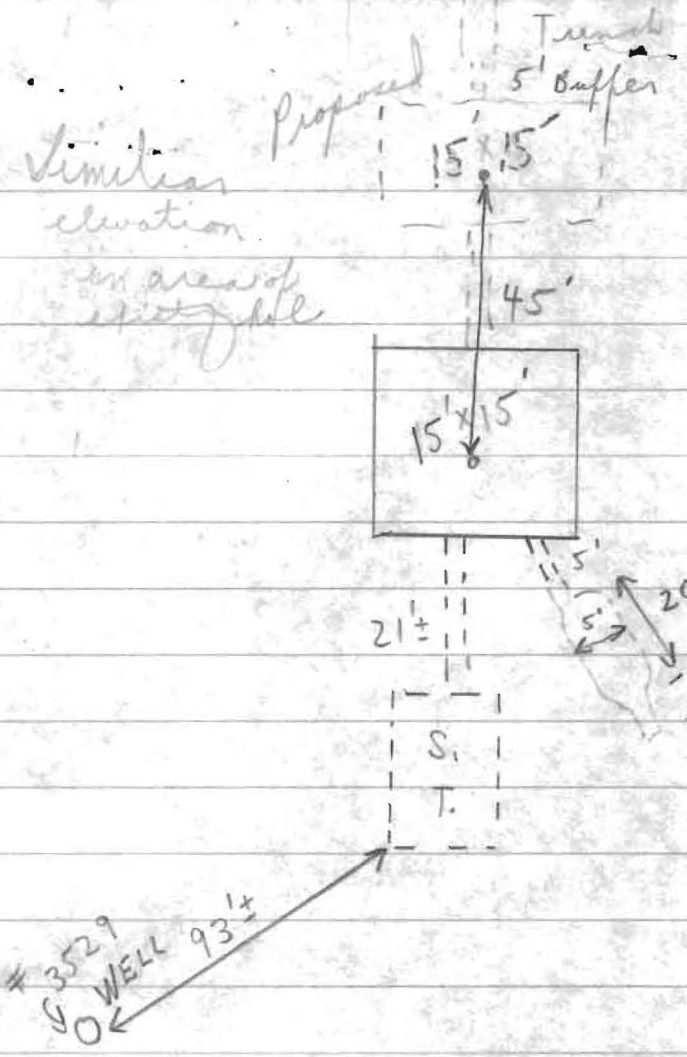

Mr. Browning would like to do away with covered trench and put another dry well and trench off last dry well. Hold & discuss with Mr. C.B. & F.F.

Signed stop work; they are to call 5/2/80. AM. C.B.

PENN SHOP RD

{ A.M. 5/2/80 Discussed with Mr. Moran
ok for 2 dry wells + trench off
back dry well
C.B. & D.W.M. }
✓ Stop in P.M. + note on card.
C.B.