

A59914/5




KNAPP SUBD.

COUNTY #


SOIL PROFILE

47+49

SOIL PROFILE

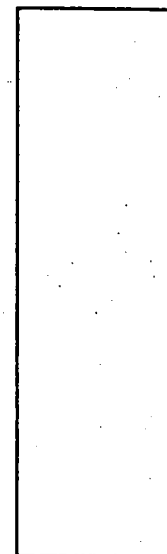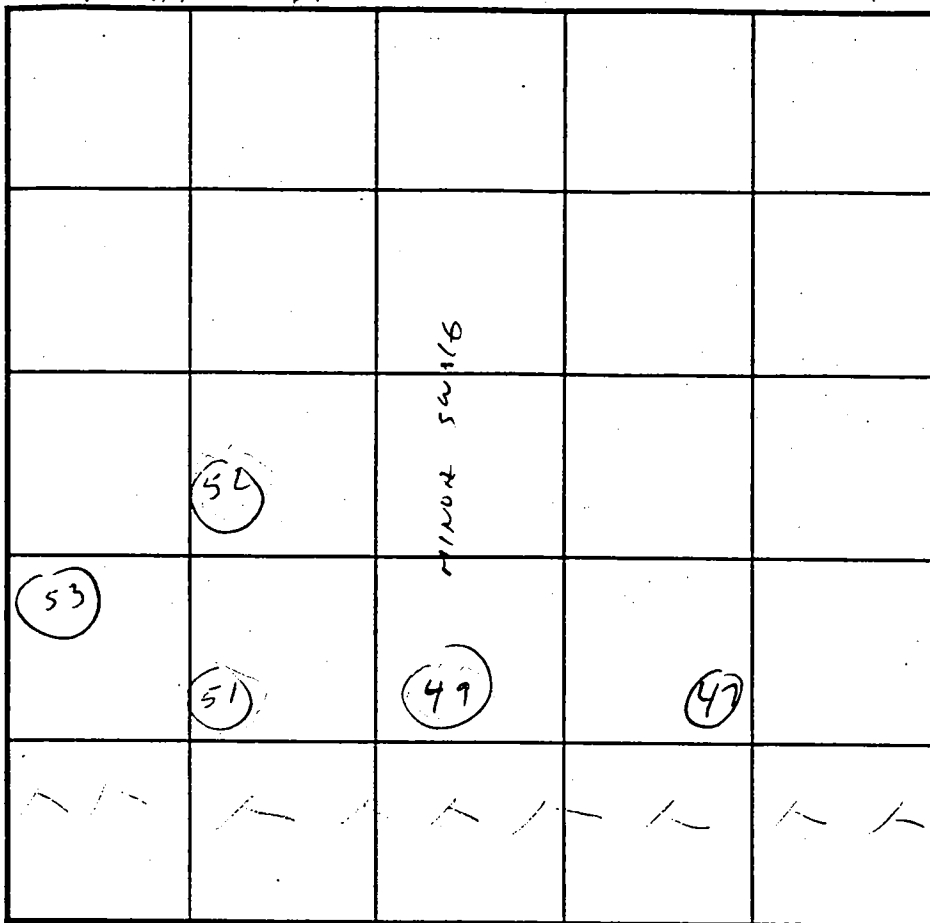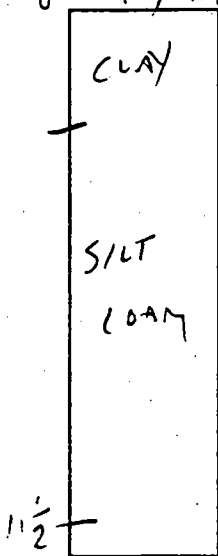


51+53

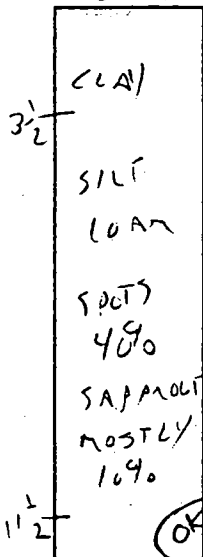

INDICATE NORTH - NAME ADJOINING ROADWAY AS BASE LINE.

DATE	TEST NO.	DEPTH	PRE-WET		TEST - 1" DROP		TIME
			START	STOP	START	STOP	
7/24/98	47	4 1/2	2:04	2:06	2:06	2:08	2 MIN
	49	4 1/2	2:05	2:07	2:07	2:10	3 MIN
		(AT HWY) OF MINOR SWALE					
	51	4 1/2	2:07	2:11	2:11	2:15	4 MIN
	52	4 1/2	2:08	2:12	2:12	2:17	5 MIN
	53	4 1/2	2:13	2:15	2:15	2:19	4 MIN

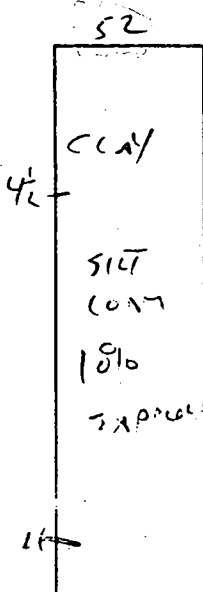

REMARKS _____

TYPE OF SOIL _____

TESTED BY Cwell ALSO PRESENT SPERRY

TRENCH DESIGN DATA: AVERAGE PERCOLATION TIME _____ TRENCH WIDTH _____

INLET DEPTH _____ MAXIMUM BOTTOM DEPTH _____ SQ. FT./BEDROOM _____


A 59914/5

KNAPP SUBD.

COUNTY #

SOIL PROFILE

46+48

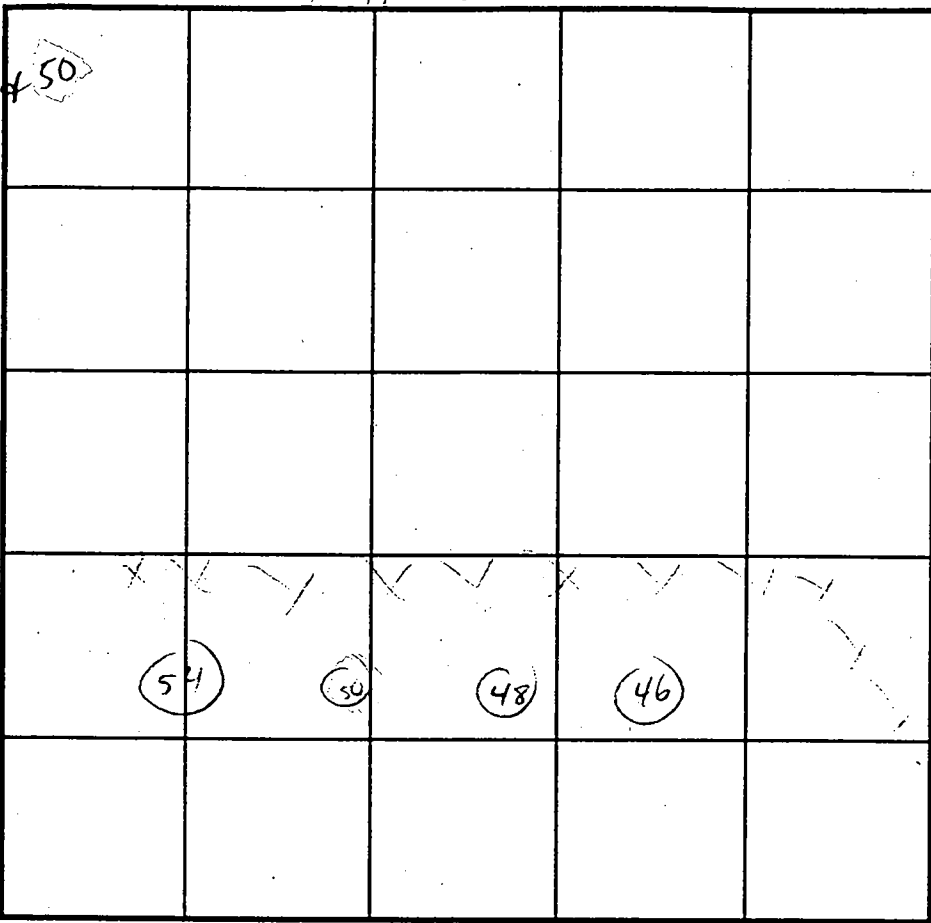

SOIL PROFILE

0' →

CLAY

3 1/2' →

MICA

SILT

LOAM

5/10

SAPPROLITE

10 1/2' →

54

CLAY

4' →

MICA

SILT

LOAM

TO 20/10

SAPPROLITE

INDICATE NORTH - NAME ADJOINING ROADWAY AS BASE LINE.

DATE	TEST NO.	DEPTH	PRE-WET		TEST - 1" DROP		TIME
			START	STOP	START	STOP	
4/24/98	46	4	2:27	2:30	2:30	2:34	4 MIN
	48	4	2:28	2:30	2:30	2:32	2 MIN
	50	4	2:31	2:34	2:34	2:37	3 MIN
	54	4 1/2	2:32	2:35	2:35	2:42	7 MIN

REMARKS _____

TYPE OF SOIL _____

TESTED BY Cowell ALSO PRESENT SPERRY

TRENCH DESIGN DATA: AVERAGE PERCOLATION TIME _____ TRENCH WIDTH _____

INLET DEPTH _____ MAXIMUM BOTTOM DEPTH _____ SQ. FT./BEDROOM _____