

APPLICATION

PERCOLATION TESTING

A 49669X
P _____

HOWARD COUNTY HEALTH DEPARTMENT
BUREAU OF ENVIRONMENTAL HEALTH
P.O. BOX 476 ELLICOTT CITY, MARYLAND 21043
TELEPHONE: 461-9933

DISTRICT FIFTH

DATE SEPTEMBER 13,

TO: THE COUNTY HEALTH OFFICER
ELLICOTT CITY, MARYLAND

I, HEREBY, APPLY FOR THE NECESSARY TEST IN ORDER TO CONSTRUCT (OR RECONSTRUCT) A SEWAGE DISPOSAL SYSTEM.

PROPERTY OWNER OTHA D. UPCHURCH Steven Merck

ADDRESS 457 OLD ORCHARD CIRCLE PHONE 410-988-9555

PROSPECTIVE BUYER SALE AS OWNER

ADDRESS _____ PHONE _____

PROPERTY LOCATION:

SUBDIVISION UPCHURCH PROPERTY / FULTON MAJOR LOT NO. 38

ROAD AND DESCRIPTION 12276 HALL SHOP ROAD 12335 Pleasant View Drive
HIGHLAND MARYLAND

TAX MAP 40 PARCEL # 16A 205

SIZE OF LOT 57,040 TYPE BLDG. SINGLE FAMILY DWELLING
(SINGLE FAMILY DWELLING OR COMMERCIAL)

THE SYSTEM INSTALLED UNDER THIS APPLICATION IS ACCEPTABLE ONLY UNTIL PUBLIC FACILITIES BECOME AVAILABLE. I FULLY UNDERSTAND THE FEE CONNECTED WITH THE FILING OF THIS PERC TEST APPLICATION IS NON-REFUNDABLE UNDER ANY CIRCUMSTANCES. I ALSO AGREE TO COMPLY WITH ALL M.O.S.H.A. REQUIREMENTS IN TESTING THIS LOT. [Signature]
(SIGNATURE OF APPLICANT)

APPROVED BY _____ FOR _____ DATE _____

REJECTED BY _____ FOR _____ DATE _____

HOLD PENDING FURTHER TESTS _____ DATE _____

REASONS FOR REJECTION OR HOLDING _____

BLDG. PERMIT SIGNED
AND RETURNED 11/9/95
Serial # 57890
SFD - YBm

THIS IS NOT A PERMIT

HD-216


77667X

1002
SOIL PROFILE

0' tan C
1 1/2' red C
2'-5' bm to tan SL
0 1/2'

1003
Red C
1/2' lgt brn SiL
1/2' tan Si micl

1004
Red C
3' Very Sandy micl
tan
1'

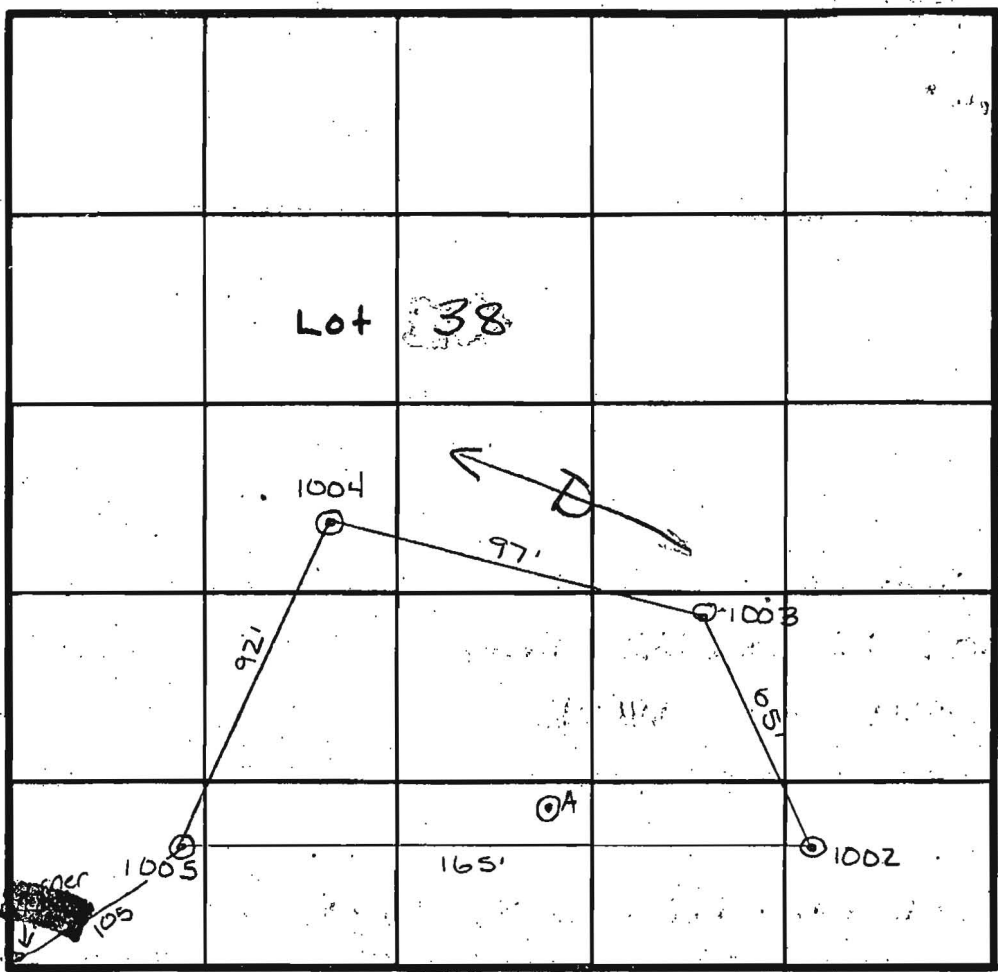

tan C
4' red C
orange brown SL

A
red C
1 1/2' to 5' Sandy w/ small pebbles

INDICATE NORTH - NAME ADJOINING ROADWAY AS BASE LINE.

DATE	TEST NO.	DEPTH	PRE-WET		TEST - 1" DROP		(MIN) TIME
			START	STOP	START	STOP	
10/17/93	1003	5' VII 1/2	11:08	11:10	11:10	11:13 ³⁰	3 1/2 min
		6 1/2' VII 1/2	11:06 ⁵⁰	11:07 ³⁰	11:07 ³⁰	11:09	1 1/2 min
	1004	Visual	to	11'	OK	—	PASS
	1005	4' VII	11:23	11:24	11:24	11:25 ³⁰	1 1/2 min
	1002	5' VI 1/2	11:31 ³⁰	11:34 ³⁰	11:34 ³⁰	11:39 ⁴⁵	5 min
	A	Visual	ONLY	to	11'	—	PASS

REMARKS _____

TYPE OF SOIL MINOR

TESTED BY Amy McMillen / Craig Williams ALSO PRESENT Olan Ketterman

Trench width 3' depth 4 1/2' max bottom depth 16 1/2' to ft below 18

12335 Pleasant View Dr

Tag Number

