

C1 14255

SEQUENCE NO. Y (MDE USE-ONLY)

STATE OF MARYLAND WELL COMPLETION REPORT

THIS REPORT MUST BE SUBMITTED WITHIN 45 DAYS AFTER WELL IS COMPLETED.

(THIS NUMBER IS TO BE PUNCHED IN COLS. 3-5 ON ALL CARDS)

COUNTY NUMBER 58535-B

DATE RECEIVED MM 11 DD 27 YY 13

DATE WELL COMPLETED MM 11 DD 27 YY 13

DEPTH OF WELL 300 (TO NEAREST FOOT)

PERMIT NO. FROM PERMIT TO DRILL WELL HO-94-3504

OWNER Fiege, B.I.I. STREET OR RFD 3150 Pfeifferhorn Rd TOWN Glenely SUBDIVISION SECTION LOT

WELL LOG table with columns: DESCRIPTION, FEET (FROM, TO), check if water bearing. Includes entries for Topsoil, Red rocky clay, Brown Shale, Tannish/brown shale, Tan slate, and grayish/blue shale.

GROUTING RECORD form including fields for CEMENT (CM), BENTONITE CLAY (BC), NO. OF BAGS (20), NO. OF POUNDS (2500), GALLONS OF WATER (120), and DEPTH OF GROUT SEAL (34).

CASING RECORD form including fields for MAIN CASING TYPE (ST), Nominal diameter (4), Total depth (40), and OTHER CASING details.

SCREEN RECORD form including fields for screen type (ST), BR (BRASS), HO (OPEN HOLE), PL (PLASTIC), and OT (OTHER).

PUMPING TEST form including fields for HOURS PUMPED (3), PUMPING RATE (15), METHOD USED TO MEASURE PUMPING RATE (Bucket), WATER LEVEL (50), and TYPE OF PUMP USED (air).

WELL HYDROFRACTURED form with YES (Y) and NO (N) options.

Legend for well status: A (Abandoned and sealed), E (Electric log obtained), P (Test well converted to production well).

I HEREBY CERTIFY THAT THIS WELL HAS BEEN CONSTRUCTED IN ACCORDANCE WITH COMAR 26.04.04...


DRILLERS LIC. NO. and SIGNATURE fields, including MVD 040 and George F. Eusteady.

DEPTH (nearest ft.) table with rows for casing height and slot size.

GRAVEL PACK and MDE USE ONLY (NOT TO BE FILLED IN BY DRILLER) fields.

TELESCOPE CASING and LOG INDICATOR fields.

PUMP INSTALLED form including fields for DRILLER INSTALLED PUMP (YES), TYPE OF PUMP INSTALLED (A.C.J.P.R.S.T.O.), CAPACITY, and PUMP HORSE POWER.

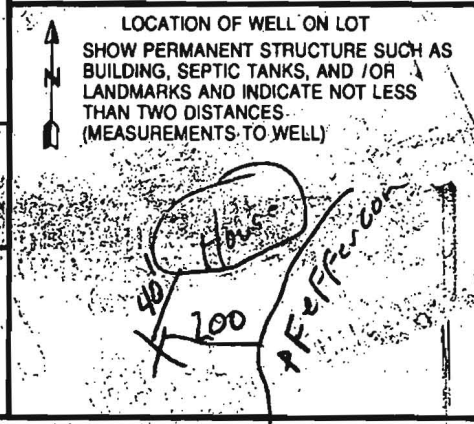

B 1 1329

SEQUENCE NO. (MDE USE ONLY)

STATE OF MARYLAND APPLICATION FOR PERMIT TO DRILL WELL please type W517925

STATE PERMIT NUMBER 70 111 in this form completely 79 HO-94-3504

Date Received (APA) 09 10 02

OWNER INFORMATION

9224

B 3

LOCATION OF WELL

8 15 FIEGE BILL 34 36 3150 PFEFFERKORN RD 55 57 WEST FRIENDSHIP, MD 21794 70 State 72 Zip 76

8 COUNTY Howard 21 CC# 23 SUBDIVISION 42 SECTION 44 46 LOT 48 50 52 NEAREST TOWN Glensieg 71


DRILLER INFORMATION

Driller's Name George F. Easterday M W D License No. 040 Firm Name L. Franklin Easterday, Inc. Address 9265 Brown Church Rd., MT. Airy, Md. 21771 Signature Date 9/9/2002

MILES FROM TOWN (enter 0 if in town) 73 76 77 78

B 4

DIRECTION OF WELL FROM TOWN (CIRCLE BOX)

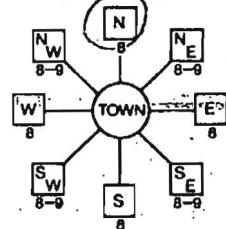

3150 Pfefferkorn Rd

11 NEAR WHAT ROAD 30 ON WHICH SIDE OF ROAD (CIRCLE APPROPRIATE BOX) NORTH WEST SOUTH EAST DISTANCE FROM ROAD 34 50 37 ENTER FT OR MI 38 39 TAX MAP: 15 BLK: PARCEL 153

B 2 WELL INFORMATION APPROX. PUMPING RATE 5 (GAL. PER MIN.) 8 12 AVERAGE DAILY QUANTITY NEEDED 500 (GAL. PER DAY) 14 20

USE FOR WATER (CIRCLE APPROPRIATE BOX)

- DOMESTIC POTABLE SUPPLY & RESIDENTIAL IRRIGATION (circled) FARMING (LIVESTOCK WATERING & AGRICULTURAL IRRIGATION) INDUSTRIAL, COMMERCIAL, DEWATERING PUBLIC WATER SUPPLY WELL TEST, OBSERVATION, MONITORING GEO-THERMAL

NOT TO BE FILLED IN BY DRILLER: HEALTH DEPARTMENT APPROVAL


Howard 58535-B COUNTY NAME COUNTY NO. STATE SIGNATURE INSERT S DATE ISSUED 09 10 02 Steven R. King 09 10 03 EXP. DATE NORTH GRID 520 000 EAST GRID 805 000

APPROXIMATE DEPTH OF WELL 300 FEET 24 28 APPROXIMATE DIAMETER OF WELL 6 INCH NEAREST


SHOW MAJOR FEATURES OF BOX & LOCATE WELL WITH AN X

- SOURCES OF DRILLING WATER 1. wells 2. 3.

WRITE THE BOX NUMBER FROM THE MAP HERE

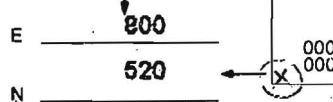

DRAW A SKETCH BELOW SHOWING LOCATION OF WELL IN RELATION TO NEARBY TOWNS AND ROADS AND GIVE DISTANCE FROM WELL TO NEAREST ROAD JUNCTION 946

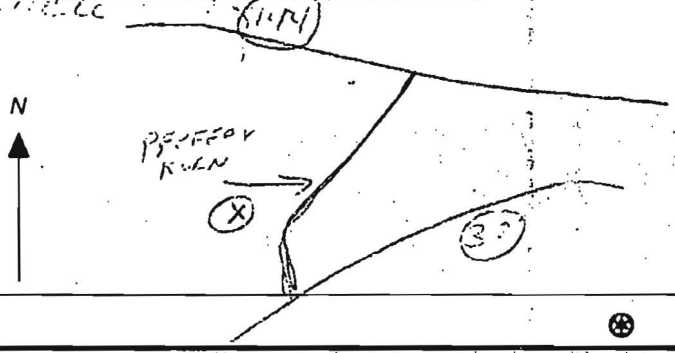

METHOD OF DRILLING (circle one)

- BORED (or Augered) JETTED Jetted & DRIVEN AIR-ROTARY AIR-PERCussion ROTARY (Hydraulic Rotary) CABLE REVERSE-ROTARY Drive-POINT other

REPLACEMENT OR DEEPEMED WELLS (CIRCLE APPROPRIATE BOX)

- THIS WELL WILL NOT REPLACE AN EXISTING WELL THIS WELL WILL REPLACE A WELL THAT WILL BE ABANDONED AND SEALED THIS WELL WILL REPLACE A WELL THAT WILL BE USED AS A STANDBY CONTACT LOCAL APPROVING AUTHORITY FOR POLICY ON STANDBY WELLS THIS WELL WILL DEEPEM AN EXISTING WELL PERMIT NUMBER OF WELL TO BE REPLACED OR DEEPEMED (IF AVAILABLE)

Not to be filled in by driller (MDE OR COUNTY USE ONLY)

APPROX. PERMIT NUMBER G PERMIT No. HO-94-3504


SPECIAL CONDITIONS

9/4/02 ~~LAM~~ 1:30 PM

SITE INSPECTION SHEET

OWNER: Bill Frige PHONE #: \_\_\_\_\_  
ADDRESS: 3150 Pfefferhorn Rd CONTRACTOR: Estaday  
WELL TAG #: HO-94-3504  
SUBDIVISION: \_\_\_\_\_ LOT: \_\_\_\_\_ COUNTY #: 58535-B  
PROPOSAL: Replacing spring with low flow

LOCATION DIAGRAM

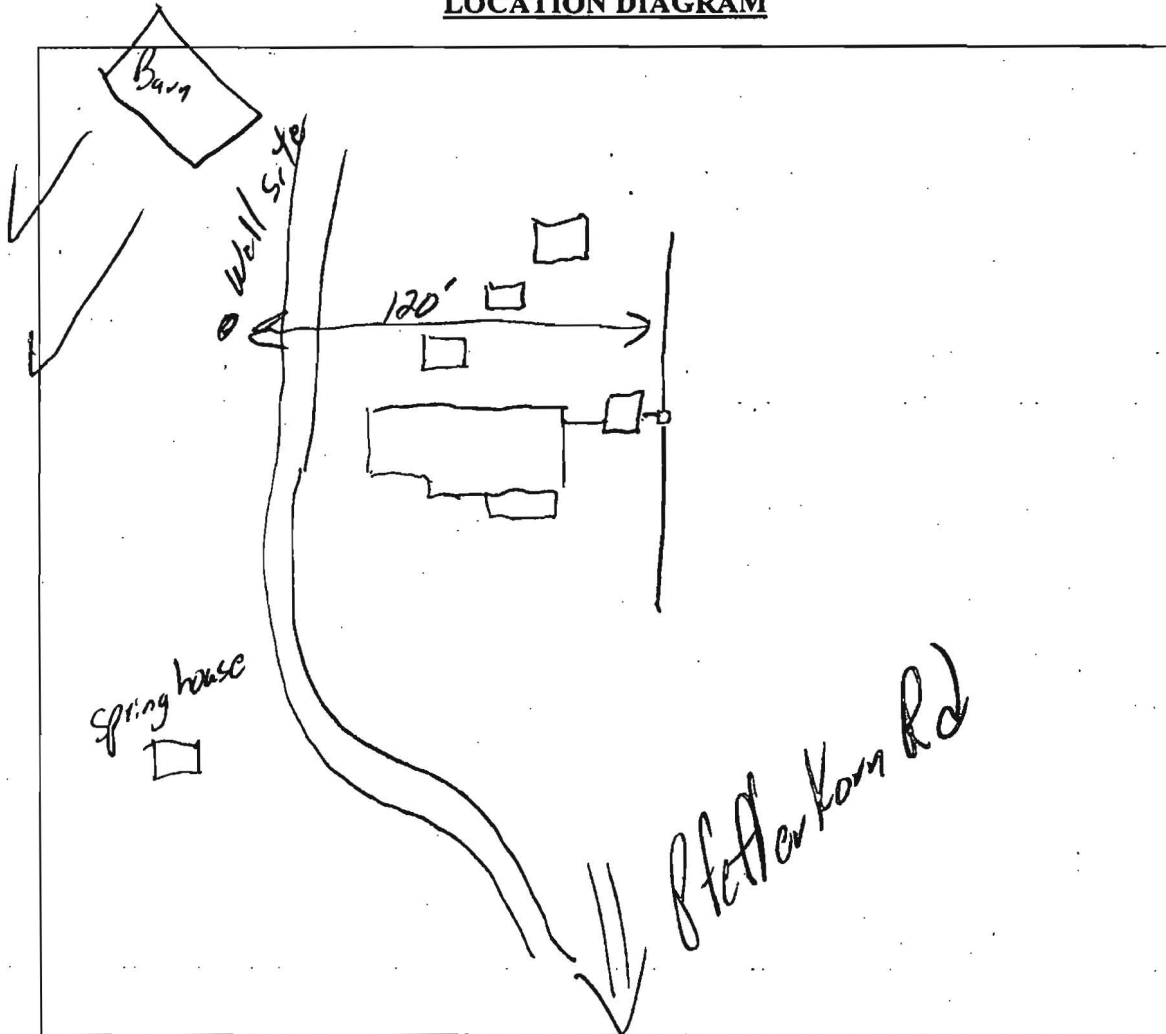

COMMENTS: 9/4/02 - Well site ok - (SRK)

DATE: 9/4/02

INSPECTOR: (SO)