

11/15/63 *of incomplete* *37A*

PERMIT

P. ~~07573~~

SEWAGE DISPOSAL SYSTEM

A. 07006

4/1/64

MARYLAND STATE DEPARTMENT OF HEALTH

HOWARD COUNTY

ELLICOTT CITY

INDEXED

DISTRICT 2

DATE 10-14-63

Reginald N. Arrington Jr. IS PERMITTED TO INSTALL ALTER

ADDRESS _____ PHONE _____

A SEWAGE DISPOSAL SYSTEM LOCATED AT Phifferkorn Rd. 1/4 mile from
Rt 144 on right

SUBDIVISION _____ ROAD _____ LOT _____

PROPERTY OWNER Reginald N. Arrington Jr.

ADDRESS _____

SPECIFICATIONS

DRAIN FIELD _____ DEPTH _____ FEET, BOTTOM AREA _____ SQ. FT.

SEEPAGE PITS ABSORBENT SIDE-WALL AREA 300 SQ. FT. below inlet

SEPTIC TANK CAPACITY 750 GALLONS

FOR GARBAGE GRINDER, INCREASE DISPOSAL AREA 22% & TANK CAPACITY 50%.

OTHER Place dry well 6.5 to 80 ft. from front lot line and

25 to 165 ft. from right L.T. line as seen when facing


lot from Phifferkorn Rd.

PLANS APPROVED BY Raymond Hodges DATE 7-3-63

FILL SEPTIC TANK AND DISTRIBUTION BOX WITH WATER BEFORE CALLING FOR AN INSPECTION. COVER NO WORK UNTIL INSPECTED AND APPROVED.

NEITHER THE HOWARD COUNTY COMMISSIONERS NOR THE HEALTH DEPARTMENT IS RESPONSIBLE FOR THE SUCCESSFUL OPERATION OF ANY SYSTEM.

A 07006

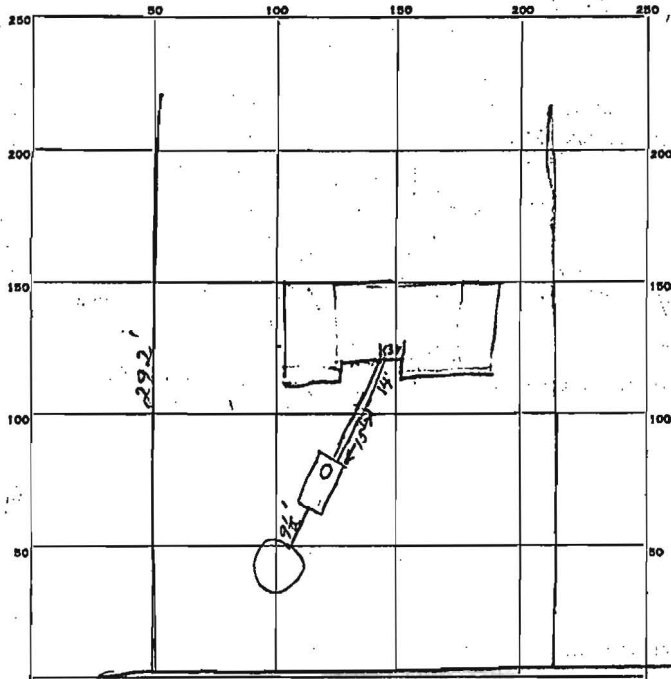

INDICATE NORTH. - NAME ADJOINING ROADWAY AS BASE LINE.

PERMIT CARD yes
 SEPTIC TANK, LEVEL 750 asphalt CLEANOUTS 8" stand pipes
 DISTRIBUTION BOX, LEVEL 620mc
 TILE FIELD, DEPTH _____ FT. TRENCH WIDTH _____ FT.
 GRAVEL DEPTH _____ IN. TOTAL LENGTH _____ FT.
 NUMBER OF TRENCHES _____ TOTAL BOTTOM AREA _____
 SEEPAGE PITS, INSIDE DIAMETER 4-1-64 10 1/2 FT. DEPTH BELOW INLET 11 1/2 FT.
 ABSORBENT AREA _____ SQ. FT.

15 NOV 63
 REMARKS 2 Cast Iron sewer pipes 14 ft long to be
connected to future tank. OK to cover that line R17
4-1-63 In place tested JH

DATE SYSTEM APPROVED 4-1-64 INSPECTOR J. H. Conroy