

APPLICATION

PERCOLATION TESTING

A 45330

P _____

HOWARD COUNTY HEALTH DEPARTMENT
BUREAU OF ENVIRONMENTAL HEALTH
P.O. BOX 476 ELLICOTT CITY, MARYLAND 21043
TELEPHONE: 461-9933

DISTRICT _____

DATE 12/13/89

TO: THE COUNTY HEALTH OFFICER
ELLICOTT CITY, MARYLAND

I HEREBY APPLY FOR THE NECESSARY TEST IN ORDER TO CONSTRUCT (OR RECONSTRUCT) A SEWAGE DISPOSAL SYSTEM.

PROPERTY OWNER B. Neville Arrington, Sr

ADDRESS 2530 Pfefferkorn Rd PHONE 442-2715
West Friendship, MD 21794

PROSPECTIVE BUYER William C. Arrington

ADDRESS 5831 Westchester Hills Ct PHONE 795-4553
Eldersburg MD 21784

PROPERTY LOCATION:

SUBDIVISION B. Neville Arrington LOT NO. 1

ROAD AND DESCRIPTION Pfefferkorn Road

TAX MAP 15 PARCEL # 3

SIZE OF LOT 3.0059 TYPE BLDG. Single family 4 BRMS
(SINGLE FAMILY DWELLING OR COMMERCIAL)

BLDG PERMIT SIGNED
AND RETURNED 3-27-96
Serial # 63832

THE SYSTEM INSTALLED UNDER THIS APPLICATION IS ACCEPTABLE ONLY UNTIL PUBLIC FACILITIES BECOME AVAILABLE. I FULLY UNDERSTAND THE

FEE CONNECTED WITH THE FILING OF THIS PERC TEST APPLICATION IS NON-REFUNDABLE UNDER ANY CIRCUMSTANCES. I ALSO AGREE TO COMPLY

WITH ALL M.O.S.H.A. REQUIREMENTS IN TESTING THIS LOT. William C. Arrington
(SIGNATURE OF APPLICANT)

APPROVED BY _____ FOR _____ DATE _____

REJECTED BY _____ FOR _____ DATE _____

HOLD PENDING FURTHER TESTS _____ DATE _____

REASONS FOR REJECTION OR HOLDING 11/13/90, Perc OK Hold for Plat R/H


HD-216

THIS IS NOT A PERMIT



290.67

SEE PLAT ATTACHED

FOR NFORB DATA

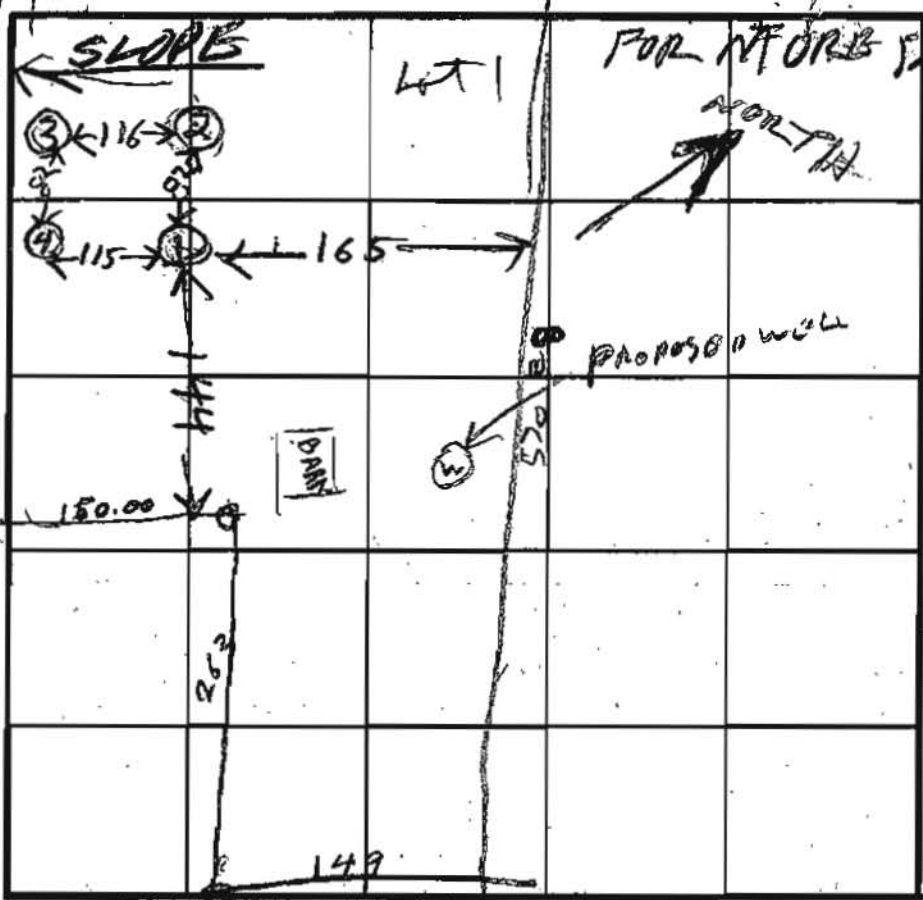

RUN TIME
 5 MIN
 780 SPT
 PER BR.
 INLET
 3 FT
 BOTTOM
 8 FT
 5 FT STN

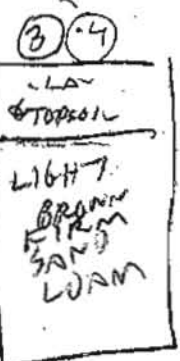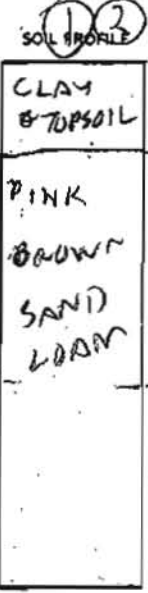

INDICATE NORTH - NAME ADJOINING ROADWAY AS BASE LINE

PREFERCORN RD


DATE	TEST NO.	DEPTH	PRE-WET		TEST - 1" DROP		TIME
			START	STOP	START	STOP	
1/3/90	1S	4	1120	1123	1123	1132	9
	1D	8	1121	1128	1128	1132	4
1/3/90	1V	12	OK	C			
1/30/90	2S	4.5	1133	1142	1142	1156	6
	2V	12	OK				
1/3/90	3S	4	1139	1205	extensive per		
	3V	12.5	OK				
1/3/90	4S	4.5	1151	1219	extensive per		
	4V	7.5					
	3M	5.5	1215	1221	1221	1232	11
	4M	6	1226	1228	1228	1232	4

REMARKS _____


TYPE OF SOIL _____

TESTED BY R. HODGES

ALSO PRESENT ED. (BACKHOLE) BY LL (OWNER)

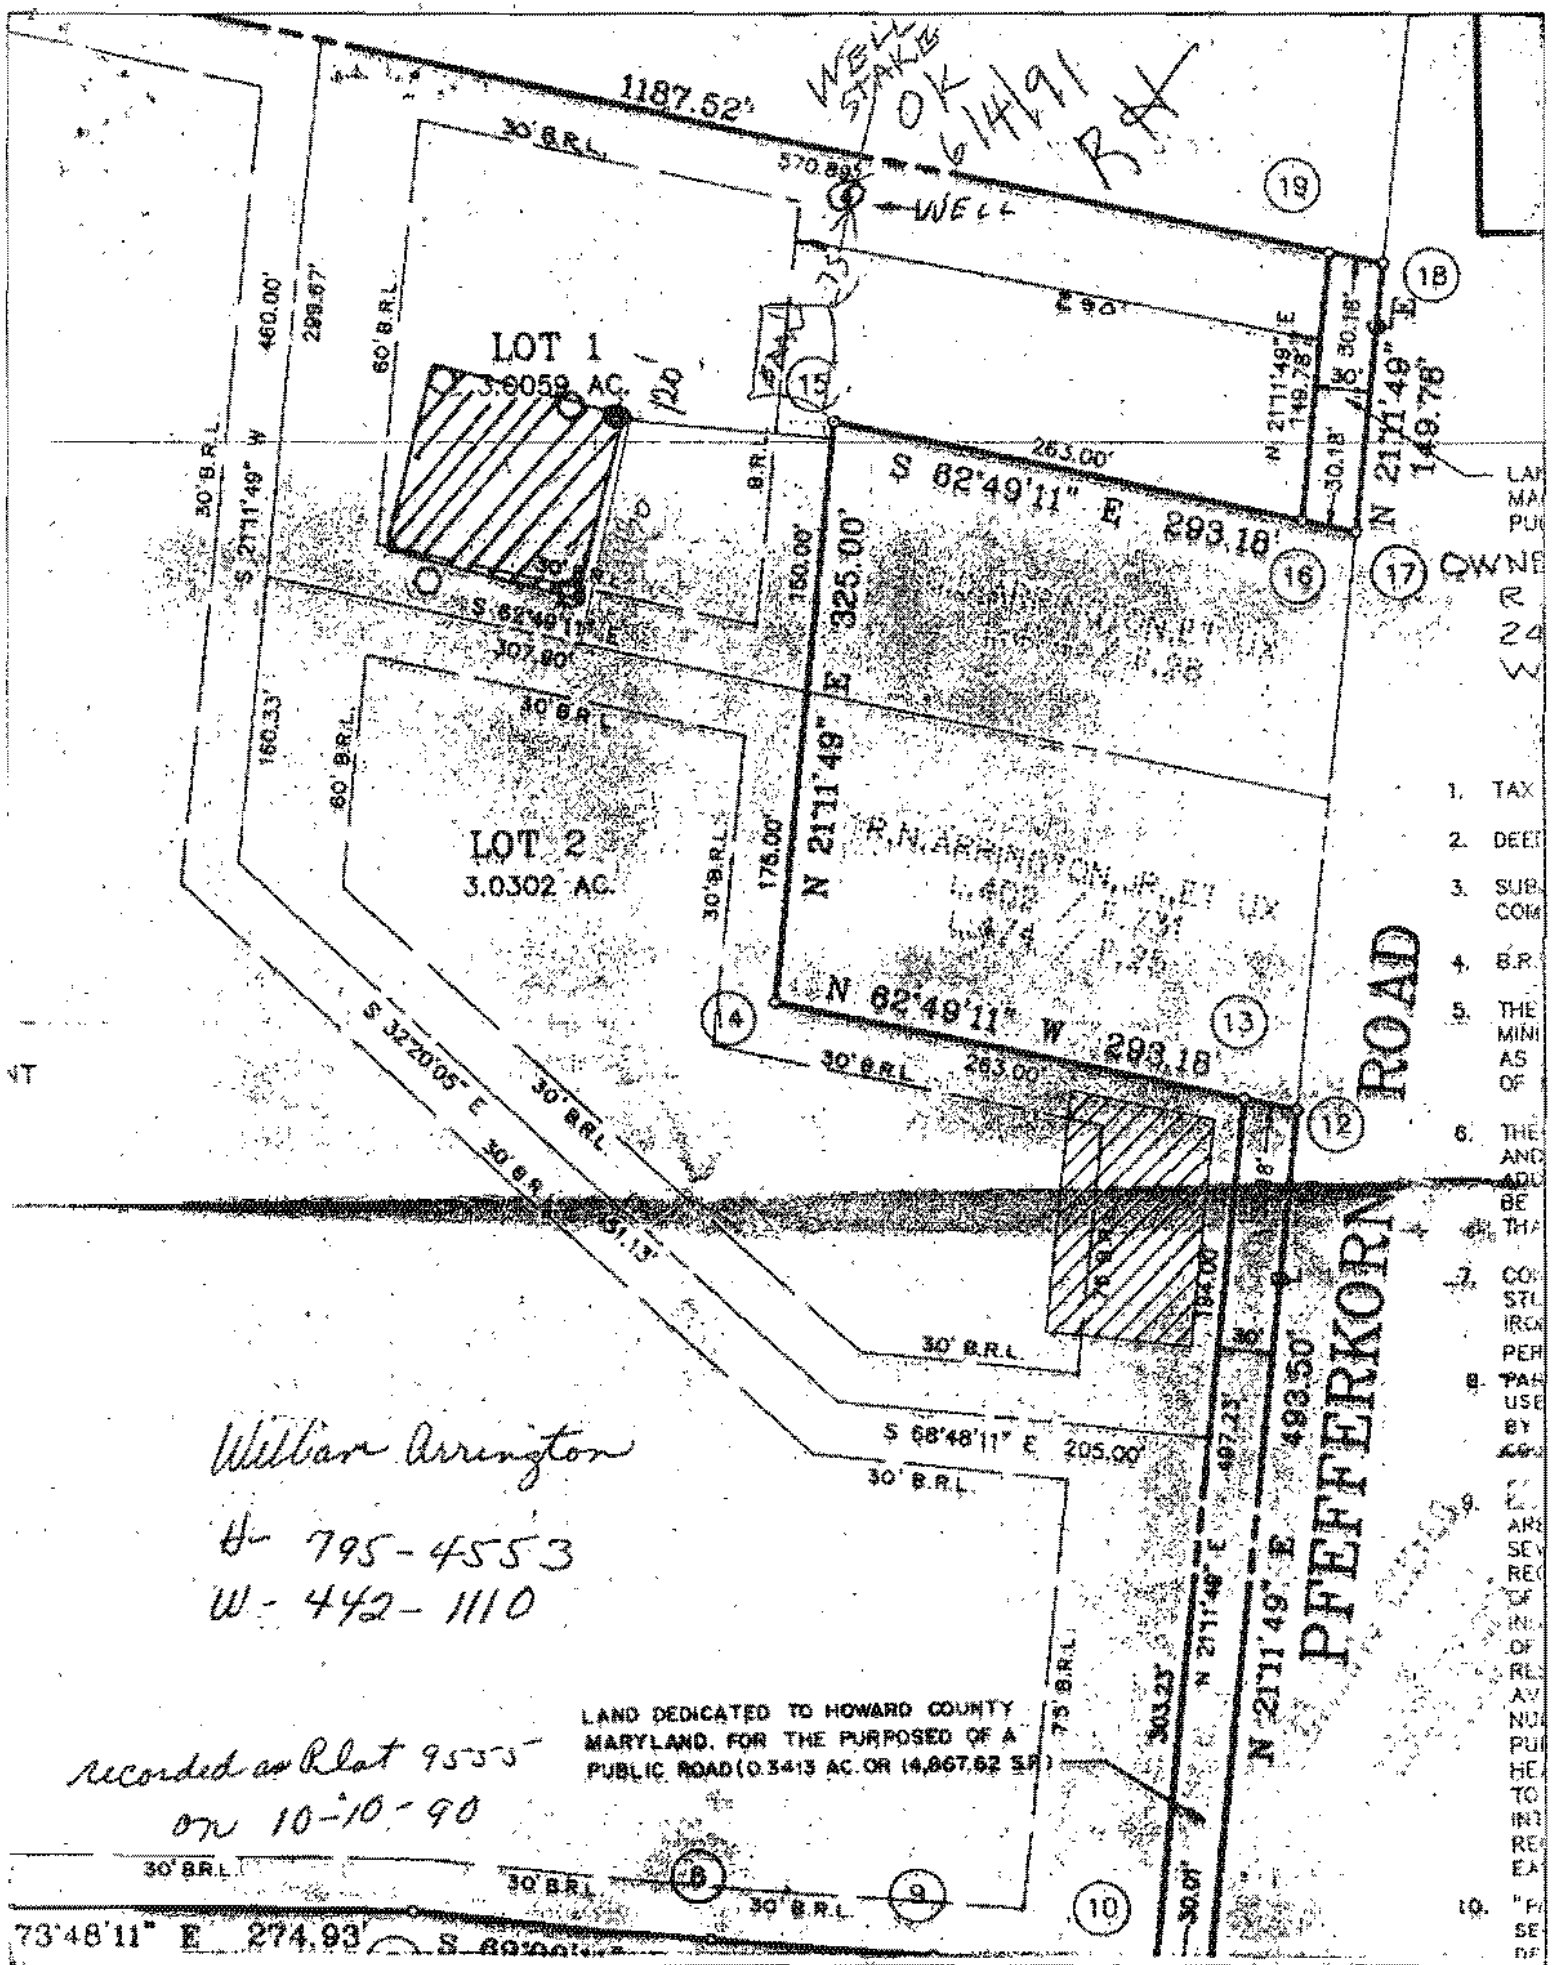

WELL STAKES OK 6/4/91 B.H.

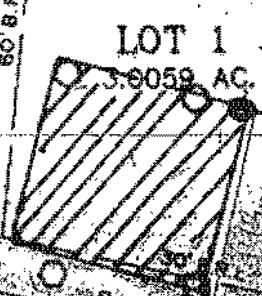

LOT 1
3.6059 AC.

LOT 2
3.0302 AC.

ROAD

PFEFFERKORN

- 1. TAX
- 2. DEED
- 3. SUB. COM
- 4. E.R.
- 5. THE MINI AS OF
- 6. THE ANCO ADU BE THA
- 7. COM STL IRCA PER
- 8. PAE USE BY
- 9. E. ARE SEV REC OF INL OF REL AV NU PUI HEA TO INI REA
- 10. "F SE OF

William Arrington
H- 795-4553
W- 442-1110

recorded as Plat 9555
on 10-10-90


LAND DEDICATED TO HOWARD COUNTY MARYLAND. FOR THE PURPOSES OF A PUBLIC ROAD (0.3413 AC. OR 14,867.62 SQ FT)

313-20644
 Ashford Army

Scale 1" = 100'

I certify that the above measurements are actual and correct for this property.

Signed: *[Signature]*

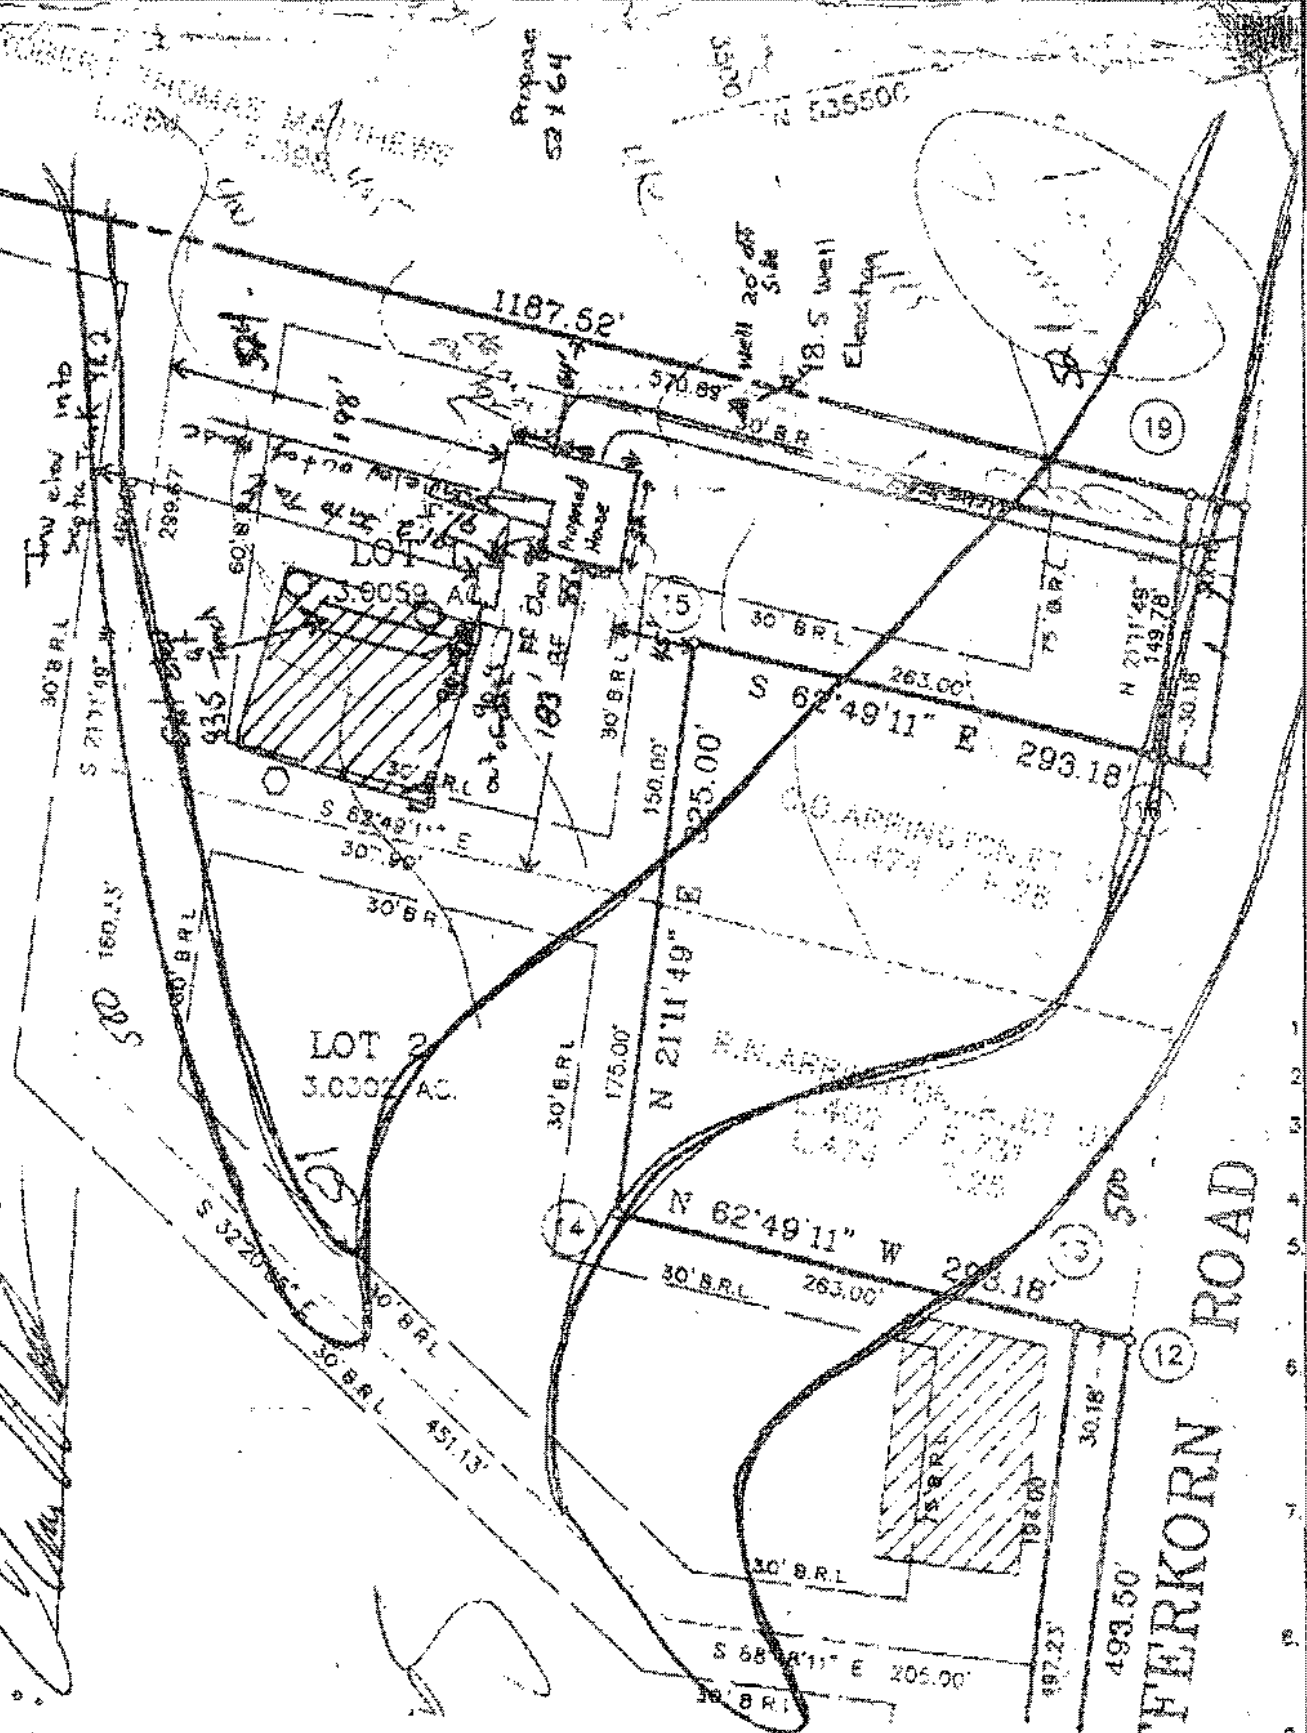

Post-It Fax Note	7671
Date	
To	<i>[Signature]</i>
From	<i>[Signature]</i>
Col'd	
Phone #	63832
Fax #	676-9593

Post-It Fax Note
 Date
 To
 From
 Col'd
 Phone #
 Fax #

C11 4578

SEQUENCE NO. (DENY USE ONLY)

STATE OF MARYLAND WELL COMPLETION REPORT

THIS REPORT MUST BE SUBMITTED WITHIN 45 DAYS AFTER WELL IS COMPLETED.

(THIS NUMBER IS TO BE PUNCHED IN COLS. 3, 6 ON PUL CARDS)

COUNTY NUMBER A 45330

ST/CO USE ONLY DATE RECEIVED

DATE WELL COMPLETED

Depth of Well

PERMIT NO. FROM "PERMIT TO DRILL WELL"

060691

2225 (TO NEAREST FOOT)

HO-28-11707

OWNER ARRINGTON WILLIAM STREET OR RFD PEEFERKORN RD TOWN WEST FRIENDSHIP SUBDIVISION ARRINGTON SECTION LOT 1

WELL LOG Not required for driven wells STATE THE KIND OF FORMATIONS PENETRATED, THEIR COLOR, DEPTH, THICKNESS AND IF WATER BEARING

Table with columns: DESCRIPTION (Use additional sheets if needed), FEET (FROM, TO), Check if water bearing. Includes handwritten entries: SAND Stone 0 56, GRAYISH Rock 56 225.

GROUTING RECORD WELL HAS BEEN GROUTED (Circle Appropriate Box)

TYPE OF GROUTING MATERIAL CEMENT CM BENTONITE CLAY BC NO. OF BAGS 10 NO. OF POUNDS 290 GALLONS OF WATER 60 DEPTH OF GROUT SEAL (to nearest foot) from 0 ft. to 40 ft.

CASING RECORD casing types insert appropriate code below ST CO STEEL CONCRETE PL OT PLASTIC OTHER

MAIN CASING TYPE ST Nominal diameter top (main) casing (nearest inch) 6 Total depth of main casing (nearest foot) 63

OTHER CASING (if used) diameter inch depth (feet) from to

SCREEN RECORD screen type or open hole insert appropriate code below ST BR HO STEEL BRASS OPEN HOLE PL OT PLASTIC OTHER

Table with columns: DEPTH (nearest ft.), rows for screen depth intervals.

CIRCLE APPROPRIATE LETTER. A WELL WAS ABANDONED AND SEALED WHEN THIS WELL WAS COMPLETED E ELECTRIC LOG OBTAINED P TEST WELL CONVERTED TO PRODUCTION WELL

DRILLERS IDENT. NO. 238

DRILLERS SIGNATURE (MUST MATCH SIGNATURE ON APPLICATION)

SITE SUPERVISOR (sign. of driller or journeyman responsible for sitework if different from permittee)

GRAVEL PACK IF WELL DRILLED WAS FLOWING WELL INSERT P IN BOX 66

TELESCOPE CASING LOG INDICATOR OTHER DATA


PUMPING TEST

HOURS PUMPED (nearest hour) 3 PUMPING RATE (gal. per min. to nearest gal.) 7.5 METHOD USED TO MEASURE PUMPING RATE Bucket WATER LEVEL (distance from land surface) BEFORE PUMPING 3.2 WHEN PUMPING 7.7 TYPE OF PUMP USED (for test) S submersible


PUMP INSTALLED DRILLER WILL INSTALL PUMP (CIRCLE) YES NO

IF DRILLER INSTALLS PUMP, THIS SECTION MUST BE COMPLETED FOR ALL WELLS, EXCEPT HOME USE. TYPE OF PUMP INSTALLED PLACE (A,C,J,P,R,S,T,O) IN BOX - SEE ABOVE. CAPACITY: GALLONS PER MINUTE (to nearest gallon) PUMP HORSE POWER PUMP COLUMN LENGTH (nearest ft.) CASING HEIGHT (circle appropriate box and enter casing height) LAND SURFACE

LOCATION OF WELL ON LOT SHOW PERMANENT STRUCTURE SUCH AS BUILDING, SEPTIC TANKS, AND/OR LANDMARKS AND INDICATE NOT LESS THAN TWO DISTANCES (MEASUREMENTS TO WELL)

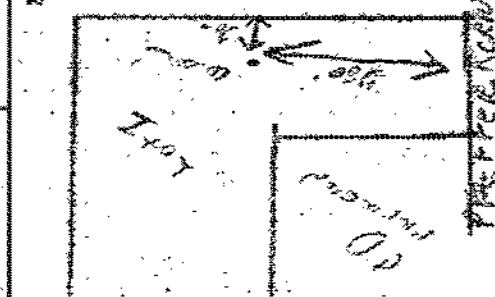

COUNTY

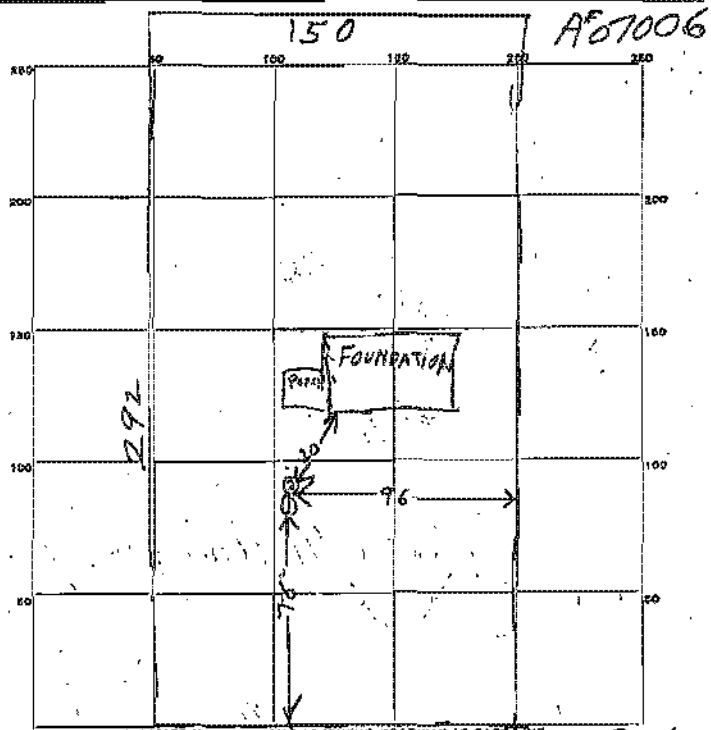

INDICATE NORTH - NAME ADJOINING ROADWAY AS BASE LINE
Pfeffercorn Road *To Route 144* $\frac{3}{10}$ mile

DATE	TEST NO.	DEPTH	PRE-WET		TEST - 1" DROP		TIME
			START	STOP	START	STOP	
7-3-63	1	5½	937	941	941	944	3
"	2	9½	939	941	941	944	3

SOIL AUGER FINDING _____
 TESTED BY *Raymond Hodges*
 REMARKS _____
 ALSO PRESENT *Reginald N. Arrington* TEST NO. _____