

B 1 09714

SEQUENCE NO. (MDE USE ONLY)

STATE OF MARYLAND PERMIT TO DRILL WELL

STATE PERMIT NUMBER

Ho - 94 - 2748

WS 3688 please print or type

fill in this form completely

Date Received (APA) 07/14/00

OWNER INFORMATION: Karlonta H. Chuck, 10 Mellor Lane, Catonsville Md 21228

LOCATION OF WELL: Howard High Forest Estates, Dayton, 4.72 miles from town

DRILLER INFORMATION: Joseph L. Magye, MSD 024, 5512 Ridge Rd Mt. Airy 21771

DIRECTION OF WELL FROM TOWN: NE, ON WHICH SIDE OF ROAD: EAST, DISTANCE FROM ROAD: 25 FT

WELL INFORMATION: APPROX. PUMPING RATE 5 GAL PER MIN, AVERAGE DAILY QUANTITY NEEDED 500 GAL PER DAY

USE FOR WATER: DOMESTIC POTABLE SUPPLY & RESIDENTIAL IRRIGATION


NOT TO BE FILLED IN BY DRILLER HEALTH DEPARTMENT APPROVAL: HOWARD COUNTY, 7/19/01

APPROXIMATE DEPTH OF WELL 300 FEET, APPROXIMATE DIAMETER OF WELL 6 INCH

SHOW MAJOR FEATURES OF BOX & LOCATE WELL WITH AN X, SOURCES OF DRILLING WATER: WELL, WRITE THE BOX NUMBER FROM THE MAP HERE: E 790, N 510

METHOD OF DRILLING: BORED (or Augered), AIR-ROTARY, CABLE

REPLACEMENT OR DEEPEMED WELLS: THIS WELL WILL NOT REPLACE AN EXISTING WELL

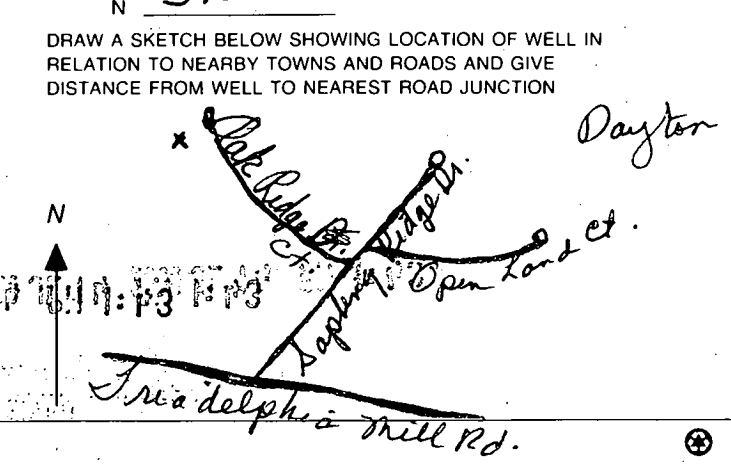

Not to be filled in by driller (MDE OR COUNTY USE ONLY): APPROP. PERMIT NUMBER 54, PERMIT NO. Ho - 94 - 2748

SPECIAL CONDITIONS: NOTE - APPROVING AUTHORITIES SHOULD USE SEPARATE SHEET IF NEEDED

B 1 **09714**

SEQUENCE NO. (MDE USE ONLY)

STATE OF MARYLAND PERMIT TO DRILL WELL

STATE PERMIT NUMBER

**40-94-2748**  
fill in this form completely

Date Received (APA)

**07/14/00**

OWNER INFORMATION

8 MM DD YY 13

Last Name **Kanonta**

Owner

First Name **Chuck**

Street or RFD **10 Mellon**

Town **Patonville** Md **21228**

State **70** Zip **76**

B 3

LOCATION OF WELL

8 COUNTY **Howard**

23 SUBDIVISION **High Forest Estates**

SECTION **44**

LOT **8**

52 NEAREST TOWN **Dayton**

MILES : : M TOWN (enter 0 if in town)

**4 1/2** M I

DRILLER INFORMATION

Driller's Name **Joseph L. Mayne**

M **SD** License No. **024**


Firm Name **J. L. Mayne Well Drilling**

Address **5517 Ridge Rd Mt. Airy 21771**

Signature **Joseph L. Mayne** Date **7/13/2000**

B 4

DIRECTION OF WELL FROM TOWN (CIRCLE BOX)

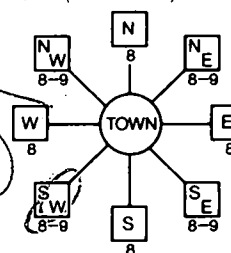

11 NEAR WHAT ROAD **Oak Ridge Ct.** 30

ON WHICH SIDE OF ROAD (CIRCLE APPROPRIATE BOX)



DISTANCE FROM ROAD **25** FT

TAX MAP: \_\_\_\_\_ BLK: \_\_\_\_\_ PARCEL \_\_\_\_\_

B 2 WELL INFORMATION

APPROX. PUMPING RATE (GAL. PER MIN.)

**5**

AVERAGE DAILY QUANTITY NEEDED (GAL. PER DAY)

**500**

USE FOR WATER (CIRCLE APPROPRIATE BOX)

- DOMESTIC POTABLE SUPPLY & RESIDENTIAL IRRIGATION
- FARMING (LIVESTOCK WATERING & AGRICULTURAL IRRIGATION)
- INDUSTRIAL, COMMERCIAL, DEWATERING
- PUBLIC WATER SUPPLY WELL
- TEST, OBSERVATION, MONITORING
- GEO-THERMAL

NOT TO BE FILLED IN BY DRILLER HEALTH DEPARTMENT APPROVAL:

COUNTY NAME **HOWARD** COUNTY NO. **13**

STATE SIGNATURE \_\_\_\_\_ INSERT S →

DATE ISSUED **7/20/00** SIGNATURE **C. W. With** EXP. DATE **7/19/01**

NORTH GRID **510 000** EAST GRID **740 000**

APPROXIMATE DEPTH OF WELL **300** FEET

APPROXIMATE DIAMETER OF WELL **6** INCH

METHOD OF DRILLING (circle one)

- BORED (or Augered)
- JETTED
- Jetted & DRIVEN
- AIR-ROTARY
- AIR-PERCussion
- ROTARY (Hydraulic Rotary)
- CABLE
- REVERSE-ROTARY
- DRIVE-POINT

REPLACEMENT OR DEEPEMED WELLS (CIRCLE APPROPRIATE BOX)

- THIS WELL WILL NOT REPLACE AN EXISTING WELL
- THIS WELL WILL REPLACE A WELL THAT WILL BE ABANDONED AND SEALED
- THIS WELL WILL REPLACE A WELL THAT WILL BE USED AS A STANDBY-CONTACT LOCAL APPROVING AUTHORITY FOR POLICY ON STANDBY WELLS
- THIS WELL WILL DEEPEMED AN EXISTING WELL

PERMIT NUMBER OF WELL TO BE REPLACED OR DEEPEMED (IF AVAILABLE) 41 \_\_\_\_\_ 52

Not to be filled in by driller (MDE OR COUNTY USE ONLY)

APPROP. PERMIT NUMBER **54** G A P **63**  
PERMIT No. **40-94-2748**

SPECIAL CONDITIONS

NOTE - APPROVING AUTHORITIES SHOULD USE SEPARATE SHEET IF NEEDED

SHOW MAJOR FEATURES OF BOX & LOCATE WELL WITH AN X

SOURCES OF DRILLING WATER

1. **WELL**
- 2.
- 3.

WRITE THE BOX NUMBER FROM THE MAP HERE

E **790**  
N **510**

DRAW A SKETCH BELOW SHOWING LOCATION OF WELL IN RELATION TO NEARBY TOWNS AND ROADS AND GIVE DISTANCE FROM WELL TO NEAREST ROAD JUNCTION

