

notes location of test holes

Percolation holes have been field located. 8/14/79 & 3/21/80

APPROVED: for Private Water & Private Sewerage System  
Howard County Health Department.


*William Byrum*  
Health Officer

4-14-80

Date

ORION

1155' to MORING STAR DRIV.

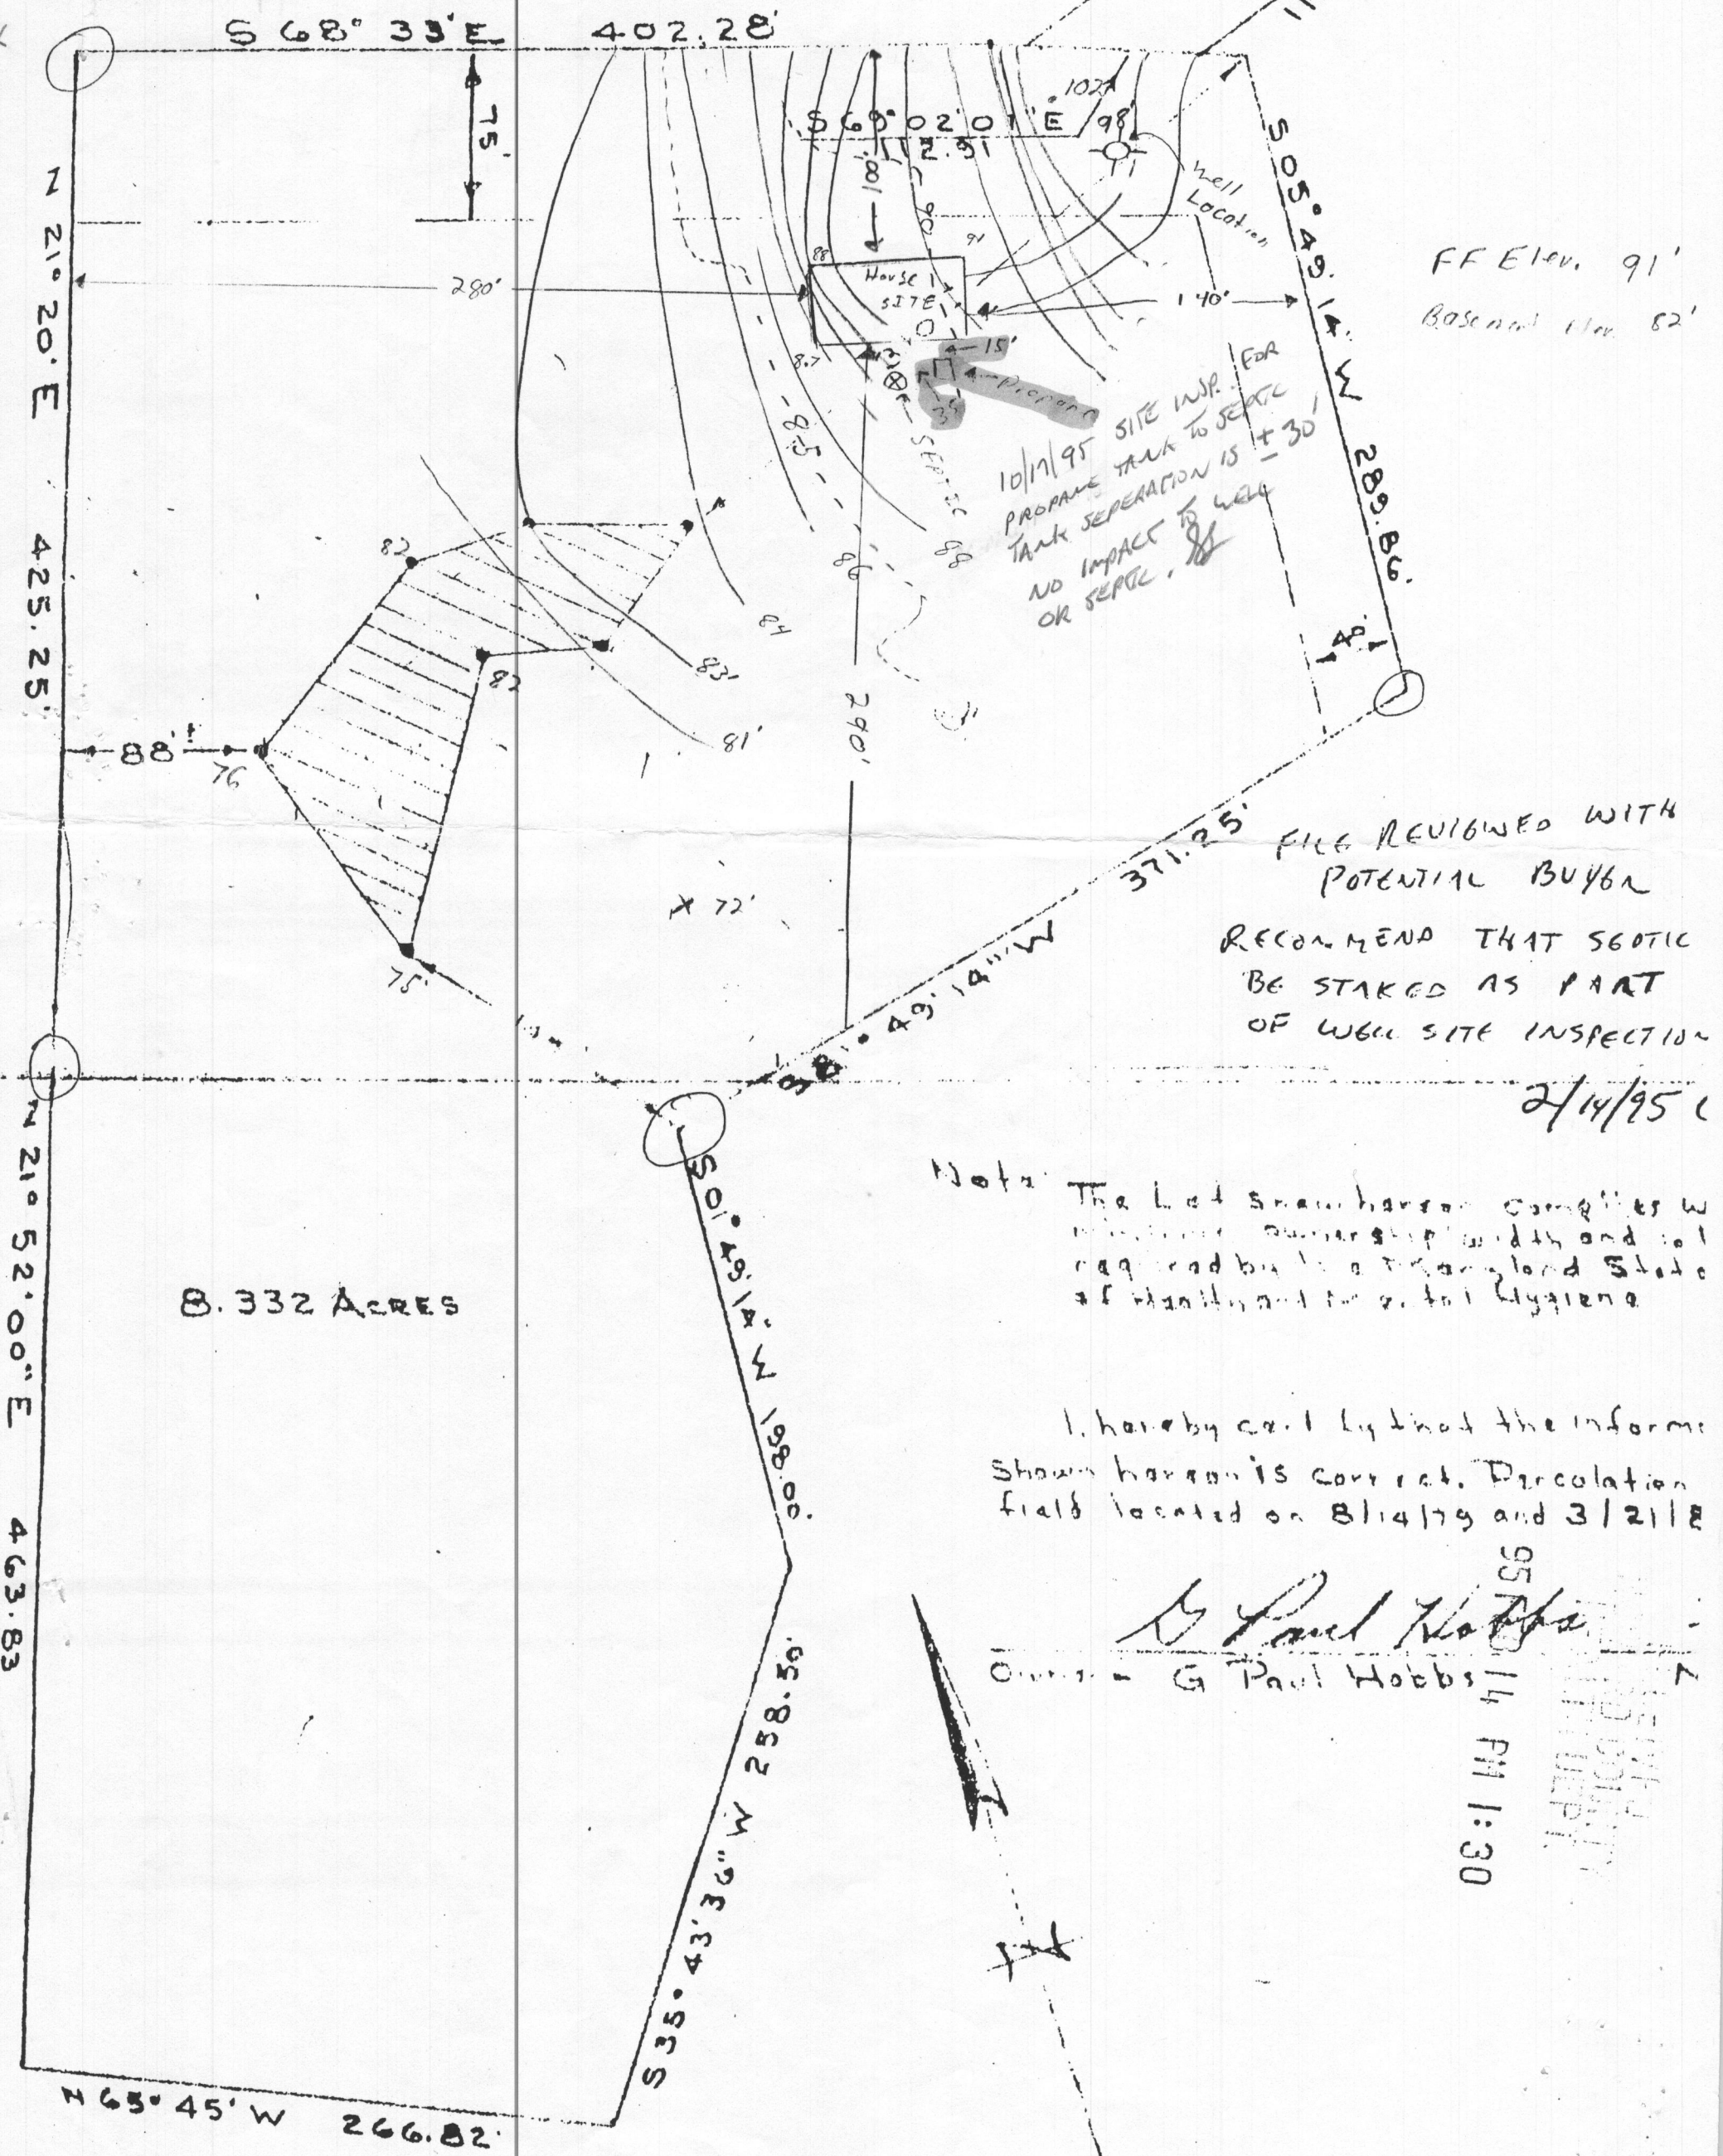

FFElev. 91'  
Basement Elev. 82'

10/17/95 SITE VISIT FOR  
PROPOSED TANK TO SEPTIC  
TANK SEPARATION IS ± 30'  
NO IMPACT TO WELL  
OR SEPTIC.

FILE REVIEWED WITH  
POTENTIAL BUYER  
RECOMMEND THAT SGOTIC  
BE STAKED AS PART  
OF WELL SITE INSPECTION

2/14/95

8.332 ACRES

Note: The Lot shown hereon complies w  
minimum ownership width and lot  
required by the Maryland State  
of Health and Mental Hygiene

I, hereby certify that the information  
shown hereon is correct. Percolation  
field located on 8/14/79 and 3/21/80

*Paul Hobbs*

Owner - G Paul Hobbs

95  
14 PM 1:30



This area designates a Private Sewage Easement of approximately 10,500 Sq. Ft. as required by the Maryland State Dept. of Health for individual Sewage disposal system. Improvements of any nature in this area are restricted until Public Sewerage is available and servicing any residential structure constructed on this site. This easement shall become null and void upon connection to a public Sewerage System.

"•" Denotes location of test holes.


Note: Perc. holes have been field located. 8/14/79 & 3/21/80

APPROVED: for Private Water & Private Sewerage System  
Howard County Health Department.

*Joseph Burgess* 4-14-80  
County Health Officer

Data

ORION DRIVE  
1155'± to MORING STAR DRIVE

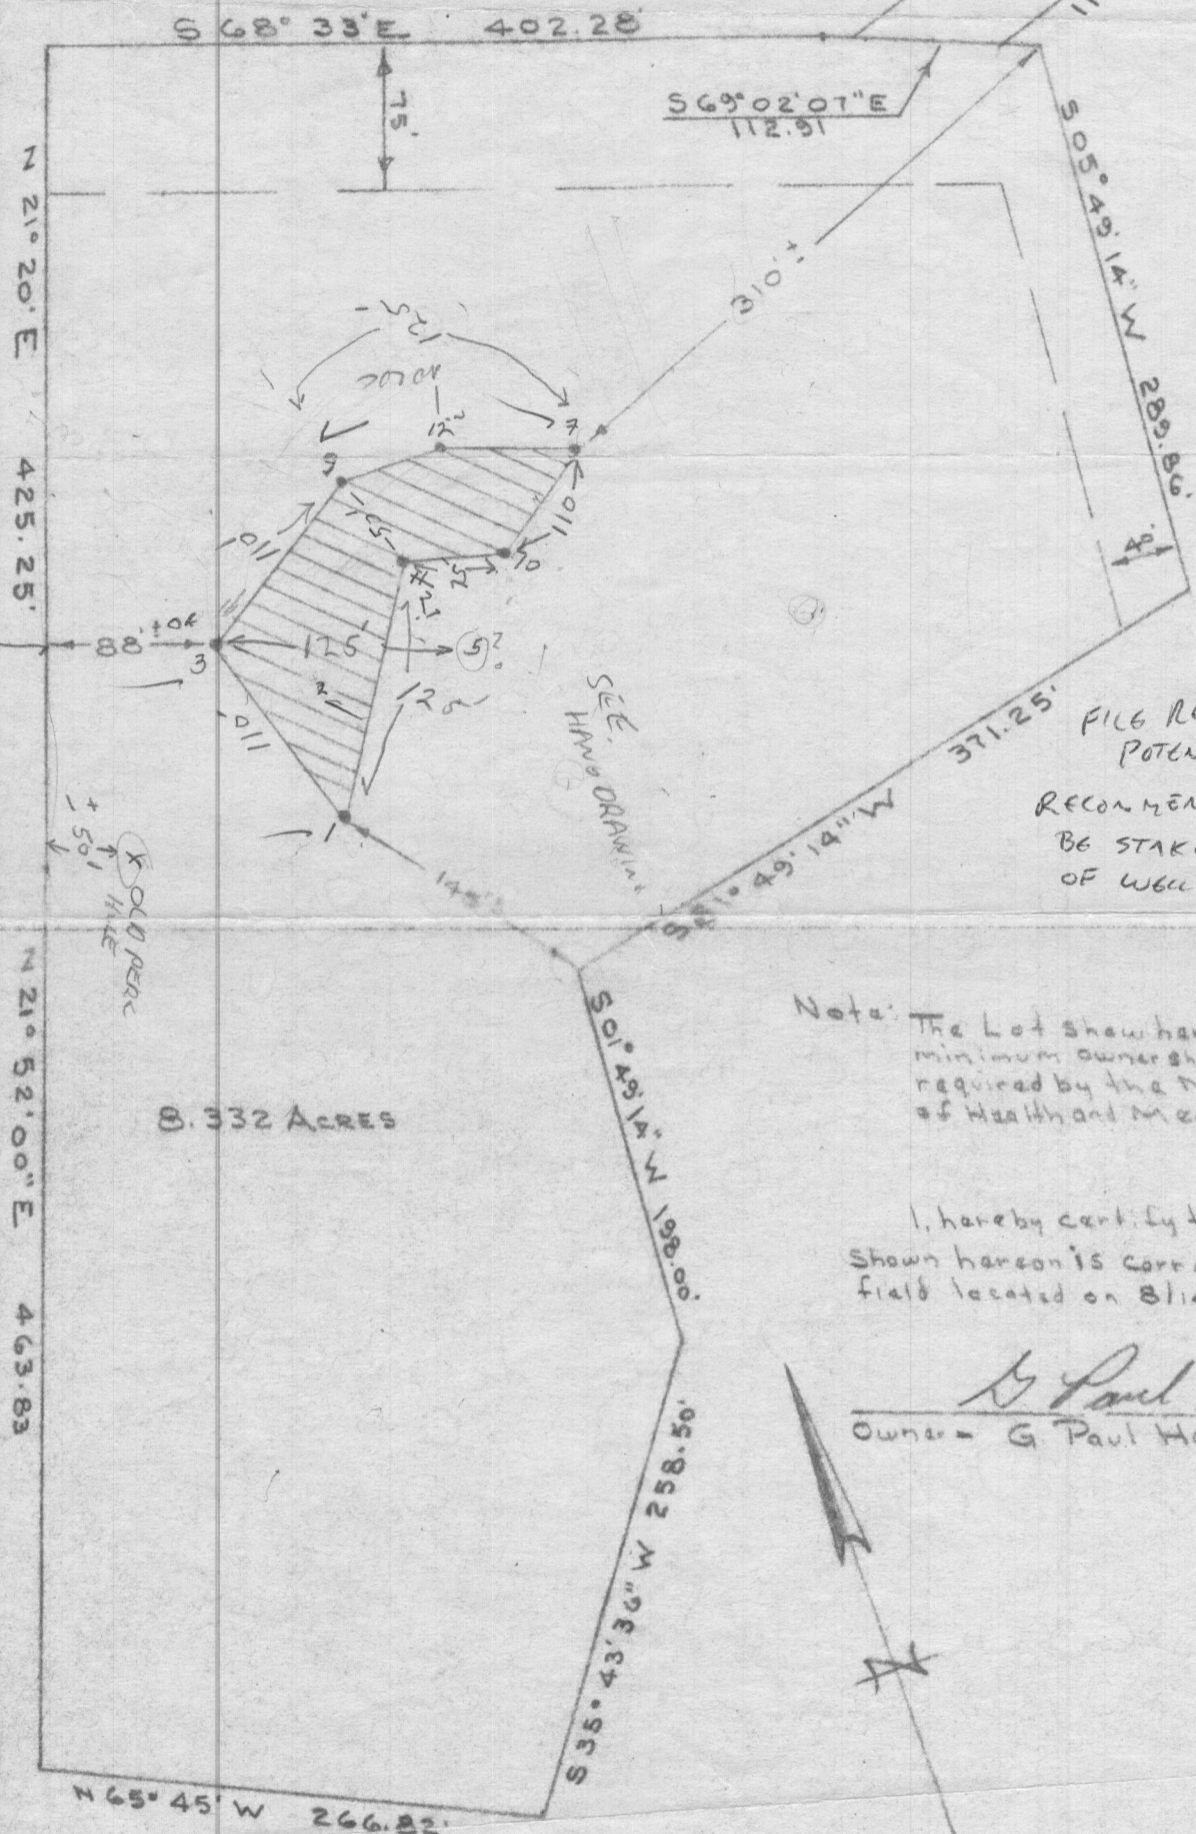

4/10/95 SEPTIC AREA INSP.  
MINOR DISCREPANCIES  
COMPARE WITH NOTEBOOK  
LINE DRAWING MEASUREMENTS  
GS

FILE REVIEWED WITH  
POTENTIAL BUYER  
RECOMMEND THAT SEPTIC AREA  
BE STAKED AS PART  
OF WELL SITE INSPECTION REVIEW.  
2/14/95 CWJ/llh

Note: The Lot shown hereon complies with the minimum ownership width and lot area as required by the Maryland State Dept. of Health and Mental Hygiene.

I, hereby certify that the information shown hereon is correct. Percolation test holes field located on 8/14/79 and 3/21/80

*G. Paul Hobbs* 3/21/80  
Owner - G. Paul Hobbs March 21, 1980

Percolation Test Plan  
For  
G. Paul Hobbs  
Fifth Election Dist. of Howard Co.  
Dayton, Maryland  
Scale: 1" = 100 ft. March 21, 1980