

APPLICATION

SEWAGE DISPOSAL TESTING

STATE OF MARYLAND - DEPARTMENT OF HEALTH AND MENTAL HYGIENE

A 29836
P _____

HOWARD COUNTY HEALTH DEPARTMENT
ENVIRONMENTAL HEALTH SERVICES
P.O. BOX 476 ELLICOTT, MARYLAND 21043
TELEPHONE: 992-2330

DISTRICT 5th
DATE 5/14/79

TO: THE COUNTY HEALTH OFFICER
ELLICOTT CITY, MARYLAND

I, HEREBY, APPLY FOR THE NECESSARY TEST IN ORDER TO CONSTRUCT (OR RECONSTRUCT) A SEWAGE DISPOSAL SYSTEM.

PROPERTY OWNER Paul Hobbs mo. Scholl 465-2544

ADDRESS _____ PHONE _____

PROPERTY LOCATION:

SUBDIVISION _____ LOT NO. _____

ROAD AND DESCRIPTION Orion Drive, off Linden Chapel

SIZE OF LOT 8.332 acres TYPE BLDG. 3 or 4 bedrooms

THE SYSTEM INSTALLED UNDER THIS APPLICATION IS ACCEPTABLE ONLY UNTIL PUBLIC FACILITIES BECOME AVAILABLE.

I FULLY UNDERSTAND THE FEE CONNECTED WITH THE FILING OF THIS PERC TEST APPLICATION IS NON-REFUNDABLE UNDER

ANY CIRCUMSTANCES.

SIGNATURE OF APPLICANT /s/ Connie Scholl, Breckinridge & Hanna

APPROVED BY J. Stayer FOR drawn fields DATE 3/21/80


REJECTED BY _____ FOR _____ DATE _____

HOLD PENDING FURTHER TESTS _____ DATE _____

REASONS FOR REJECTION, OR HOLDING 8-7-79 HOLD FOR WET SEASON


3/11/80 - hold for more testing

THIS IS NOT A PERMIT

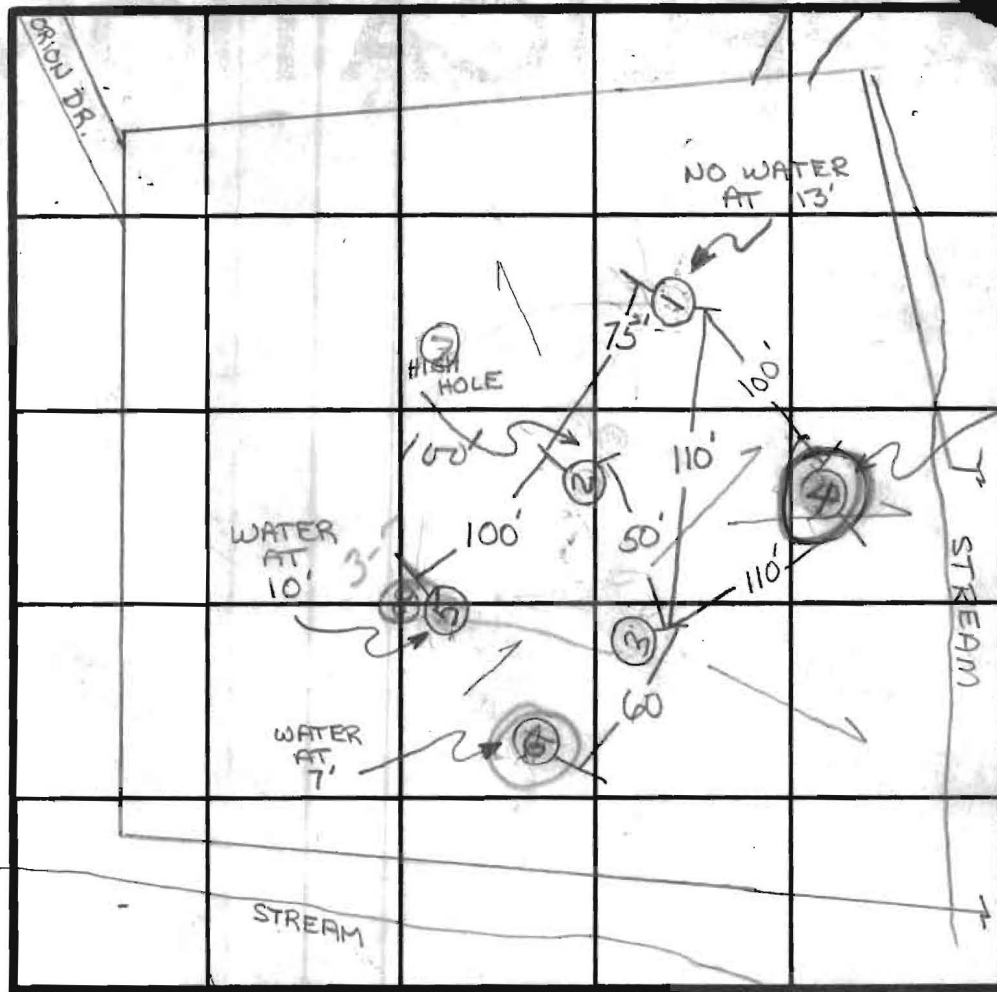

INDICATE NORTH - NAME ADJOINING ROADWAY AS BASE LINE.

SOIL PROFILE

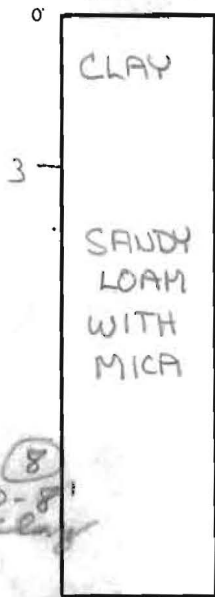

8
0-3' clay

9
0-3' clay
3'-8'
sandy loam

DATE	TEST NO.	DEPTH	PRE-WET		TEST - 1" DROP		TIME	
			START	STOP	START	STOP		
8/7/79	1S	4	2:05	2:09	2:09	2:14	5	
	1D	10	2:05	2:09	2:09	2:15	6	
	2S	3	2:19	2:21	2:21	2:25	4	
	2D	10	2:20	2:29	2:29	2:41	12	
	3S	3	3:21	3:22	3:22	3:24	2	
	3D	10	3:33	3:36	3:36	3:40	4	
	4	7'	WATER	AT 7'	dry to 10'			
	5	10'	WATER	AT 10'	dry to 11'			
	6S	3	3:57	3:58	3:58	4:01	3	
	6D	9	WATER IN HOLE		AT 6'		- SHALE	
3/11/80	7S	3	2:00	2:06	2:06	2:30	24	
	7M	7	2:00	2:15	2:15	2:41	26	
	8S (old)	3	2:16	both failed		109 inches		
	8M (old)	7	2:16	both failed		109 inches		
	9S	3	3:32	3:35	3:35	3:45	10	
	9M	7	3:32	3:34	3:34	3:36	2	
3/20/80	10	8	-(0-3') (3'-8') sandy loam					
	11		clay					

{ wet season test

REMARKS #10 & 11 - water at 10'

TYPE OF SOIL _____

TESTED BY R. Demarco J. Stayer ALSO PRESENT PAUL HOBBS