

1911

SEQUENCE NO. (MDE USE ONLY)

STATE OF MARYLAND WELL COMPLETION REPORT

FILL IN THIS FORM COMPLETELY. PLEASE PRINT OR TYPE

THIS REPORT MUST BE SUBMITTED WITHIN 45 DAYS AFTER WELL IS COMPLETED.

COUNTY NUMBER A50428

(THIS NUMBER IS TO BE PUNCHED IN COLS. 3-6 ON ALL CARDS)

DATE RECEIVED

DATE WELL COMPLETED

Depth of Well

PERMIT NO. FROM "PERMIT TO DRILL WELL"

080296

092496

22 205 26 (TO NEAREST FOOT)

HO-94-0802

OWNER Trinity Custom Homes
STREET OR RFD Park Overlook Ct
SUBDIVISION Benson Branch Est SECTION LOT 14 20

WELL LOG Not required for driven wells.

GROUTING RECORD WELL HAS BEEN GROUTED (Y) (N)

C 3 PUMPING TEST

STATE THE KIND OF FORMATIONS PENETRATED, THEIR COLOR, DEPTH, THICKNESS AND IF WATER BEARING

TYPE OF GROUTING MATERIAL (Circle one) CEMENT (CM) BENTONITE CLAY (BC)

HOURS PUMPED (nearest hour) 3

Table with columns: DESCRIPTION (Use additional sheets if needed), FEET (FROM, TO), check if water bearing. Rows include Top Soil, Sandy Sandstone, MICKA, Sandstone, MICKA, Sandstone, MICKA.

NO. OF BAGS 18 NO. OF POUNDS 1800
GALLONS OF WATER
DEPTH OF GROUT SEAL (to nearest foot) from 0 ft to 30 ft

PUMPING RATE (gal. per min.) 10
METHOD USED TO MEASURE PUMPING RATE Bucket
WATER LEVEL (distance from land surface)

CASING RECORD STEEL (ST) CONCRETE (CO) PLASTIC (PL) OTHER (OT)

BEFORE PUMPING 46 ft
WHEN PUMPING 60 ft

MAIN CASING TYPE PL Nominal diameter 6 Total depth 44

TYPE OF PUMP USED (for test) S submersible

OTHER CASING (if used) diameter inch depth (feet) from to

PUMP INSTALLED DRILLER WILL INSTALL PUMP YES (NO)

NUMBER OF UNSUCCESSFUL WELLS: 0

SCREEN RECORD STEEL (ST) BRASS BRONZE (BR) OPEN HOLE (HO) PLASTIC (PL) OTHER (OT)

IF DRILLER INSTALLS PUMP, THIS SECTION MUST BE COMPLETED FOR ALL WELLS. TYPE OF PUMP INSTALLED PLACE (A,C,J,P,R,S,T,O) IN BOX 29

WELL HYDROFRACTURED (Y) (N)

DEPTH (nearest ft.) HO 42 205

PUMP COLUMN LENGTH (nearest ft.)

CIRCLE APPROPRIATE LETTER A A WELL WAS ABANDONED AND SEALED WHEN THIS WELL WAS COMPLETED

DEPTH (nearest ft.) HO 42 205

CASING HEIGHT (circle appropriate box and enter casing height) + above LAND SURFACE (nearest foot)


I HEREBY CERTIFY THAT THIS WELL HAS BEEN CONSTRUCTED IN ACCORDANCE WITH COMAR 26.04.04 "WELL CONSTRUCTION" AND IN CONFORMANCE WITH ALL CONDITIONS STATED IN THE ABOVE CAPTIONED PERMIT...

SLOT SIZE 1 2 3 DIAMETER OF SCREEN (NEAREST INCH)

LOCATION OF WELL ON LOT SHOW PERMANENT STRUCTURE SUCH AS BUILDING, SEPTIC TANKS, AND /OR LANDMARKS AND INDICATE NOT LESS THAN TWO DISTANCES (MEASUREMENTS TO WELL)

TYPE: MWD/MSD/IMGD DRILLERS LIC. NO. 116

GRAVEL PACK IF WELL DRILLED WAS FLOWING WELL INSERT F IN BOX 68

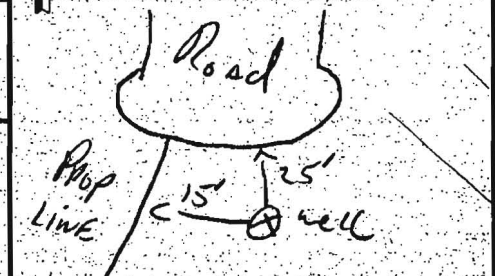


DRILLERS SIGNATURE (MUST MATCH SIGNATURE ON APPLICATION)

MDE USE ONLY (NOT TO BE FILLED IN BY DRILLER) (E.R.O.S.)

LIC. NO. 117

TELESCOPE CASING LOG INDICATOR OTHER DATA

SITE SUPERVISOR (sign. of driller or journeyman responsible for sitework if different from permittee)

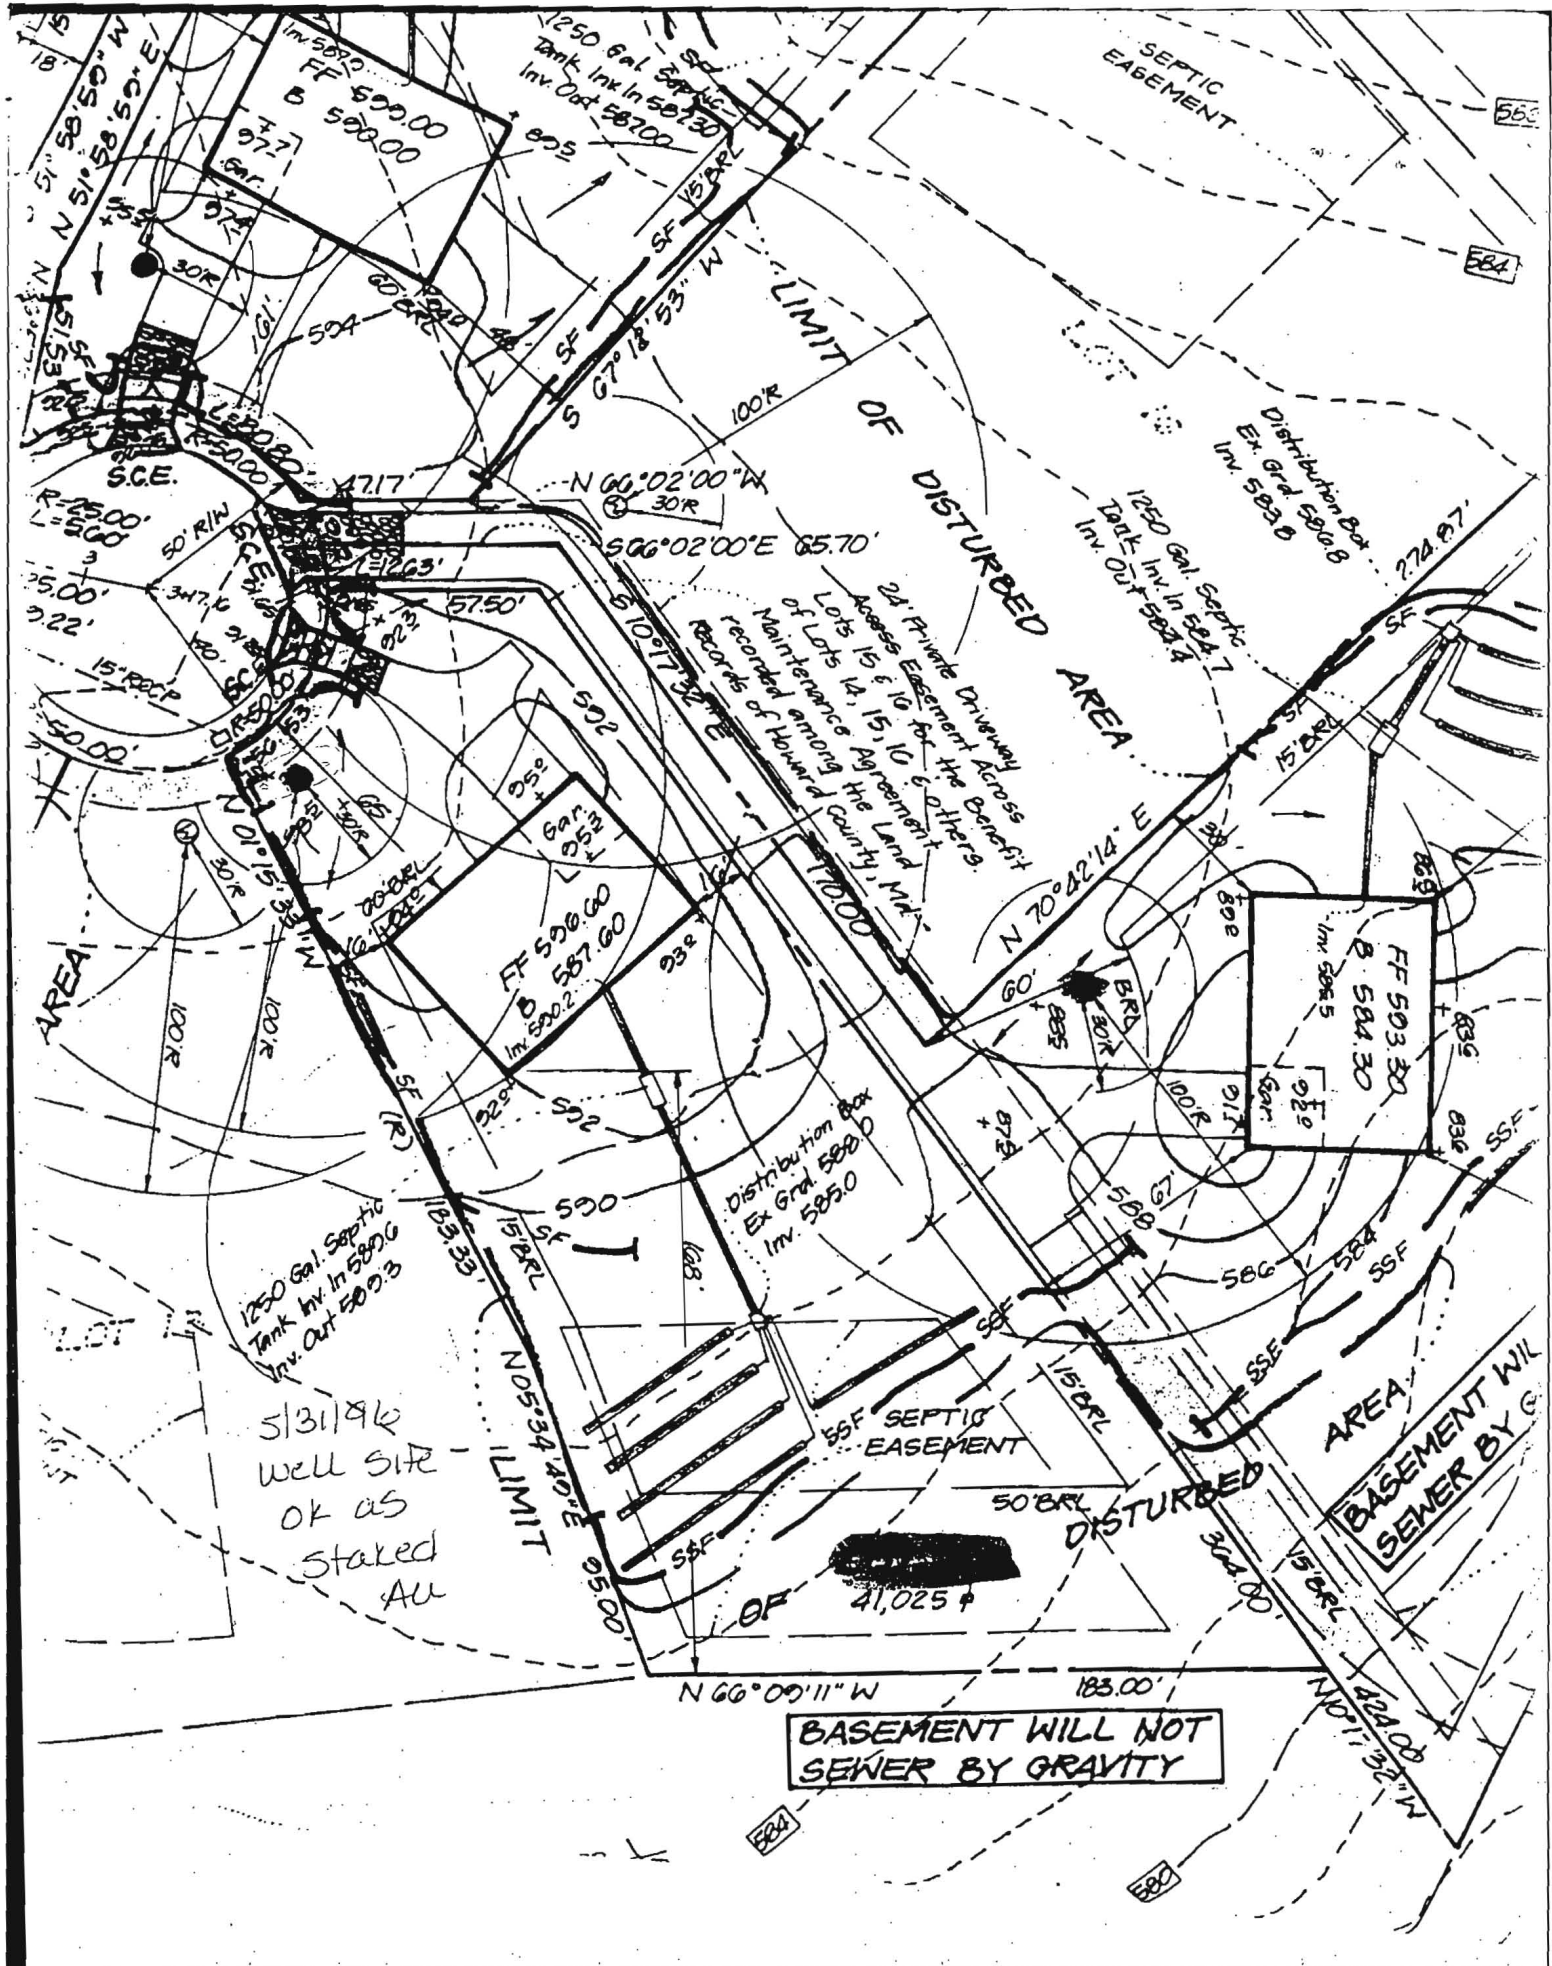

BASEMENT WILL NOT SEWER BY GRAVITY

5131196 Well S/R of AS Staked AU

41,025 #

BASEMENT WILL SEWER BY GRAVITY