

4/26/71  
Postulok  
Jin

app 4-27-71  
DUM

# INDEXED

# PERMIT

SEWAGE DISPOSAL SYSTEM

P 15880

A \_\_\_\_\_

MARYLAND STATE DEPARTMENT OF HEALTH

HOWARD COUNTY

ELLCOTT CITY

DISTRICT 4

DATE 4/19/71

Jack Fyock IS PERMITTED TO INSTALL ALTER

ADDRESS Fen Oaks Road, Glenelg, Maryland PHONE 286-2939

A SEWAGE DISPOSAL SYSTEM LOCATED AT \_\_\_\_\_

SUBDIVISION \_\_\_\_\_ ROAD 1503 Old Annapolis Road LOT \_\_\_\_\_

PROPERTY OWNER J. C. Berger 489-7091 off St. Michael's Road - approx. 2 ft. hts.  
in 1503 on mid. lot  
turn left right into field.

ADDRESS \_\_\_\_\_

SPECIFICATIONS - REPAIR

DRAIN FIELD \_\_\_\_\_ DEPTH \_\_\_\_\_ FEET. BOTTOM AREA \_\_\_\_\_ SQ. FT.

SEEPAGE PITS \_\_\_\_\_ ABSORBENT SIDE-WALL AREA \_\_\_\_\_ SQ. FT.

SEPTIC TANK CAPACITY 1,200 GALLONS

FOR GARBAGE GRINDER, INCREASE DISPOSAL AREA 22% & TANK CAPACITY 50%.

OTHER REPAIR - Deep trench if possible - when ground is opened up call  
for an inspection so Sanitarian can recommend repair size.


PLANS APPROVED BY Palmer F. Wine DATE 4/19/71

FILL SEPTIC TANK AND DISTRIBUTION BOX WITH WATER BEFORE CALLING FOR AN INSPECTION. COVER NO WORK UNTIL INSPECTED AND APPROVED.

NEITHER THE HOWARD COUNTY COMMISSIONERS NOR THE HEALTH DEPARTMENT IS RESPONSIBLE FOR THE SUCCESSFUL OPERATION OF ANY SYSTEM.

permit # 42257  
addition of family room  
signed 1/2/80

9  
15-880

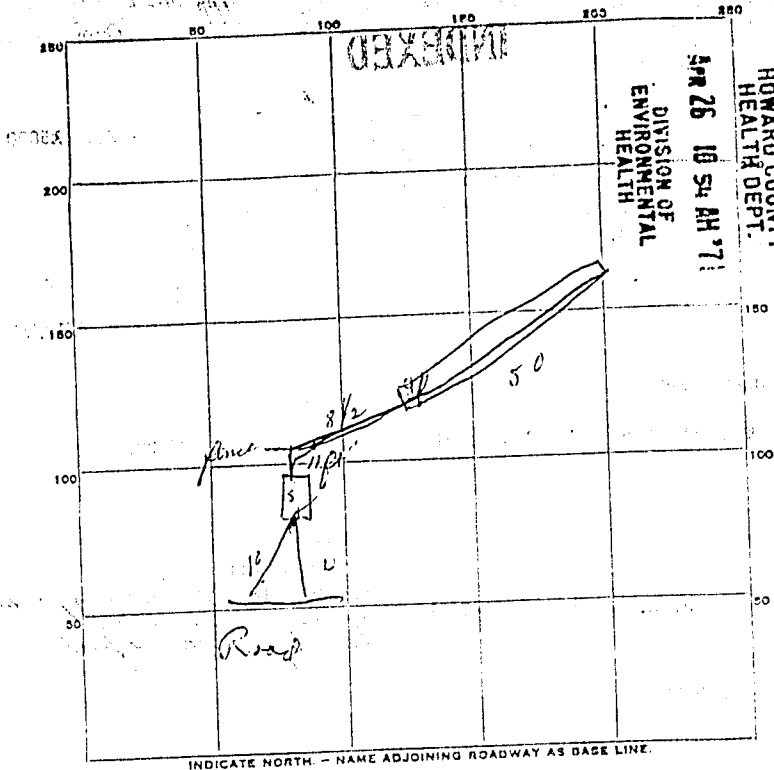

PERMIT CARD OK

SEPTIC TANK, LEVEL \_\_\_\_\_ CLEANOUTS \_\_\_\_\_

DISTRIBUTION BOX, LEVEL \_\_\_\_\_

TILE FIELD, DEPTH 10 FT. TRENCH WIDTH 2 FT.

GRAVEL DEPTH 7.2 IN. TOTAL LENGTH 56 FT.

NUMBER OF TRENCHES \_\_\_\_\_ TOTAL BOTTOM AREA 100

SEEPAGE PITS, INSIDE DIAMETER \_\_\_\_\_ FT. DEPTH BELOW INLET \_\_\_\_\_ FT.

ABSORBENT AREA 600 SQ. FT.

REMARKS 4/25/71 OK for ground water tank here

\_\_\_\_\_

\_\_\_\_\_

\_\_\_\_\_

\_\_\_\_\_

DATE SYSTEM APPROVED 4-27-71 INSPECTOR Dw. Monaghan