

# APPLICATION

PERCOLATION TESTING

A 47038  
P \_\_\_\_\_

HOWARD COUNTY HEALTH DEPARTMENT  
BUREAU OF ENVIRONMENTAL HEALTH  
PO BOX 476 ELLICOTT CITY, MARYLAND 21043  
TELEPHONE 461-9933

DISTRICT 4th

DATE ~~April 14, 1991~~  
5/7/91

TO: THE COUNTY HEALTH OFFICER  
ELLICOTT CITY, MARYLAND

I, HEREBY, APPLY FOR THE NECESSARY TEST IN ORDER TO CONSTRUCT (OR RECONSTRUCT) A SEWAGE DISPOSAL SYSTEM

PROPERTY OWNER W. Lambert Cissel, Jr.

ADDRESS 3425 Hipsley Mill Road, Woodbine, MD 21797 PHONE 301-442-2463

PROSPECTIVE BUYER Same

ADDRESS \_\_\_\_\_ PHONE \_\_\_\_\_

PROPERTY LOCATION:

SUBDIVISION Lambert Green LOT NO 3

ROAD AND DESCRIPTION 17300± Hardy Rd.

TAX MAP 7 PARCEL # 144

SIZE OF LOT 3.5 acres ± TYPE BLDG Single Family Dwelling  
(SINGLE FAMILY DWELLING OR COMMERCIAL)

THE SYSTEM INSTALLED UNDER THIS APPLICATION IS ACCEPTABLE ONLY UNTIL PUBLIC FACILITIES BECOME AVAILABLE. I FULLY UNDERSTAND THE FEE CONNECTED WITH THE FILING OF THIS PERC TEST APPLICATION IS NON-REFUNDABLE UNDER ANY CIRCUMSTANCES. I ALSO AGREE TO COMPLY WITH ALL M.O.S.H.A. REQUIREMENTS IN TESTING THIS LOT.

Christine A. Richards  
(SIGNATURE OF APPLICANT)

APPROVED BY \_\_\_\_\_ FOR \_\_\_\_\_ DATE \_\_\_\_\_

REJECTED BY \_\_\_\_\_ FOR \_\_\_\_\_ DATE \_\_\_\_\_

HOLD PENDING FURTHER TESTS \_\_\_\_\_ DATE \_\_\_\_\_

REASONS FOR REJECTION OR HOLDING \_\_\_\_\_

# THIS IS NOT A PERMIT


HD-216

Lot 3  
A47038

(X) = NOT DUG;  
STAKES PER PLAT

SOIL PROFILE

0'  
org brn red  
saccl lm  
10% frags  
3 1/2'  
brn tan  
purple  
sand lm  
20%  
shaley  
saprolite  
1 1/2'  
12 1/2'  
frags

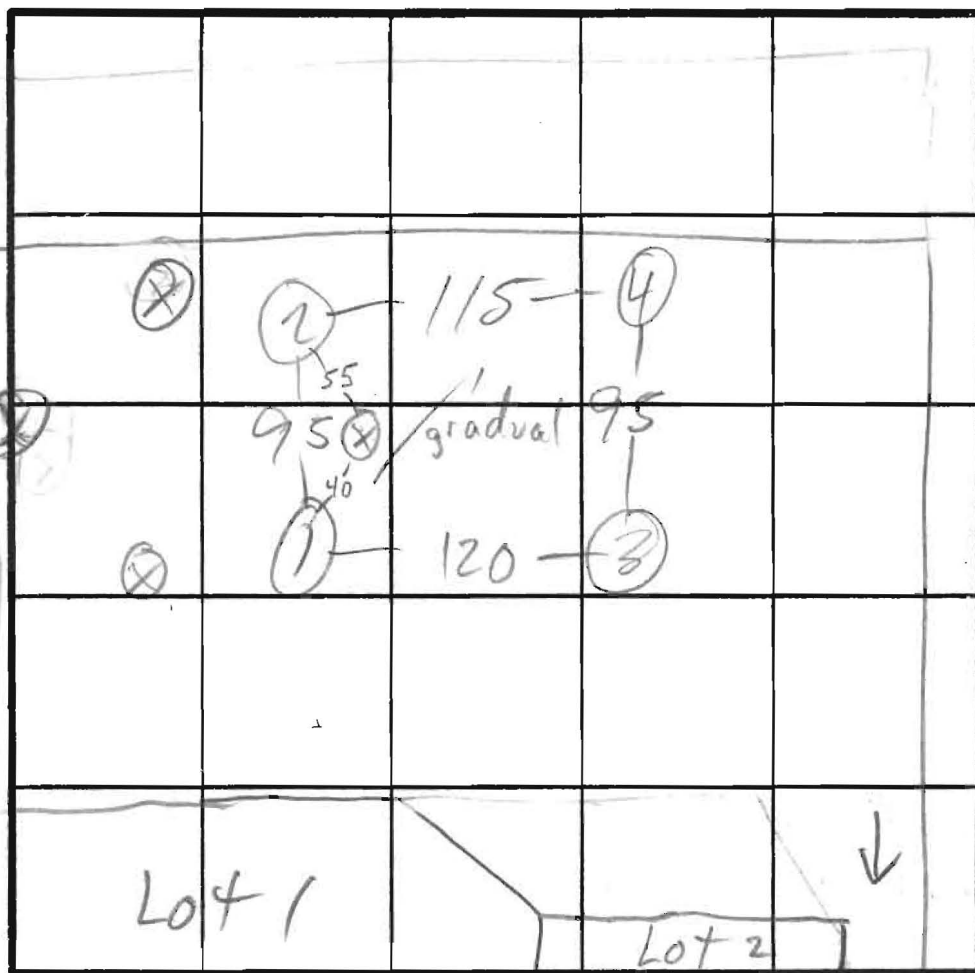

INDICATE NORTH - NAME ADJOINING ROADWAY AS BASE LINE

HARDY RD

DATE	TEST NO.	DEPTH	PRE-WET		TEST - 1" DROP		TIME
			START	STOP	START	STOP	
5/31/91	1 S	4 1/2	2:47	2:55	2:55	3:07	12
	1 V	7	2:46	2:50	2:50	2:55	5
	2 S	2 1/2	see profile				
	2 S	5	2:50	2:55	2:55	3:12	17
	2 V	11 1/2	sim to (1) 25-30% frags				
	3 S	5	3:02	3:07	3:07	3:15	8
	3 V	12	sim to (1) 20% frags				
	4 S	5	3:10	3:16	3:16	3:28	12
	4 V	13	sim to (1) 20% frags				

REMARKS

HOLES NOT PER PLAN

TYPE OF SOIL

TESTED BY

ALSO PRESENT

OPEN SPACE

LOT 3

10,264 sq. ft.

17,543 sq. ft.

LAMBERT GREEN

LOT 1

LOT 2

NO PLUMBING IN THESE BUILDINGS

*BARN*  
*WATER TREATERS*

EX. WELL

Sep Tank

ep Tank

Sep Tank

EX. WELL

Private Property

*OPEN SPACE*  
*Hardy Green & Lambert Green*  
*Signed 10/2/91*  
*Copy Per Cent 20*

# 3828001  
NO. CO. MON

OPEN SPACE

OK 5'

OK 5'

LOT 3

A 47036

Rocky

shale #5  
1/2 clay #6  
220'

A 47038

10,264 sq. ft.

LAMBERT GREEN

LOT 1

LOT 2

NITRATES?

2 BARNs

NO PLUMBING IN THESE BUILDINGS

tests ok 5'

A 47037

EX. WELL

X Sep tank

X Sep Tank


EX. WELL

Private Property

# 3828001

HO. CO. MON.

1997.67

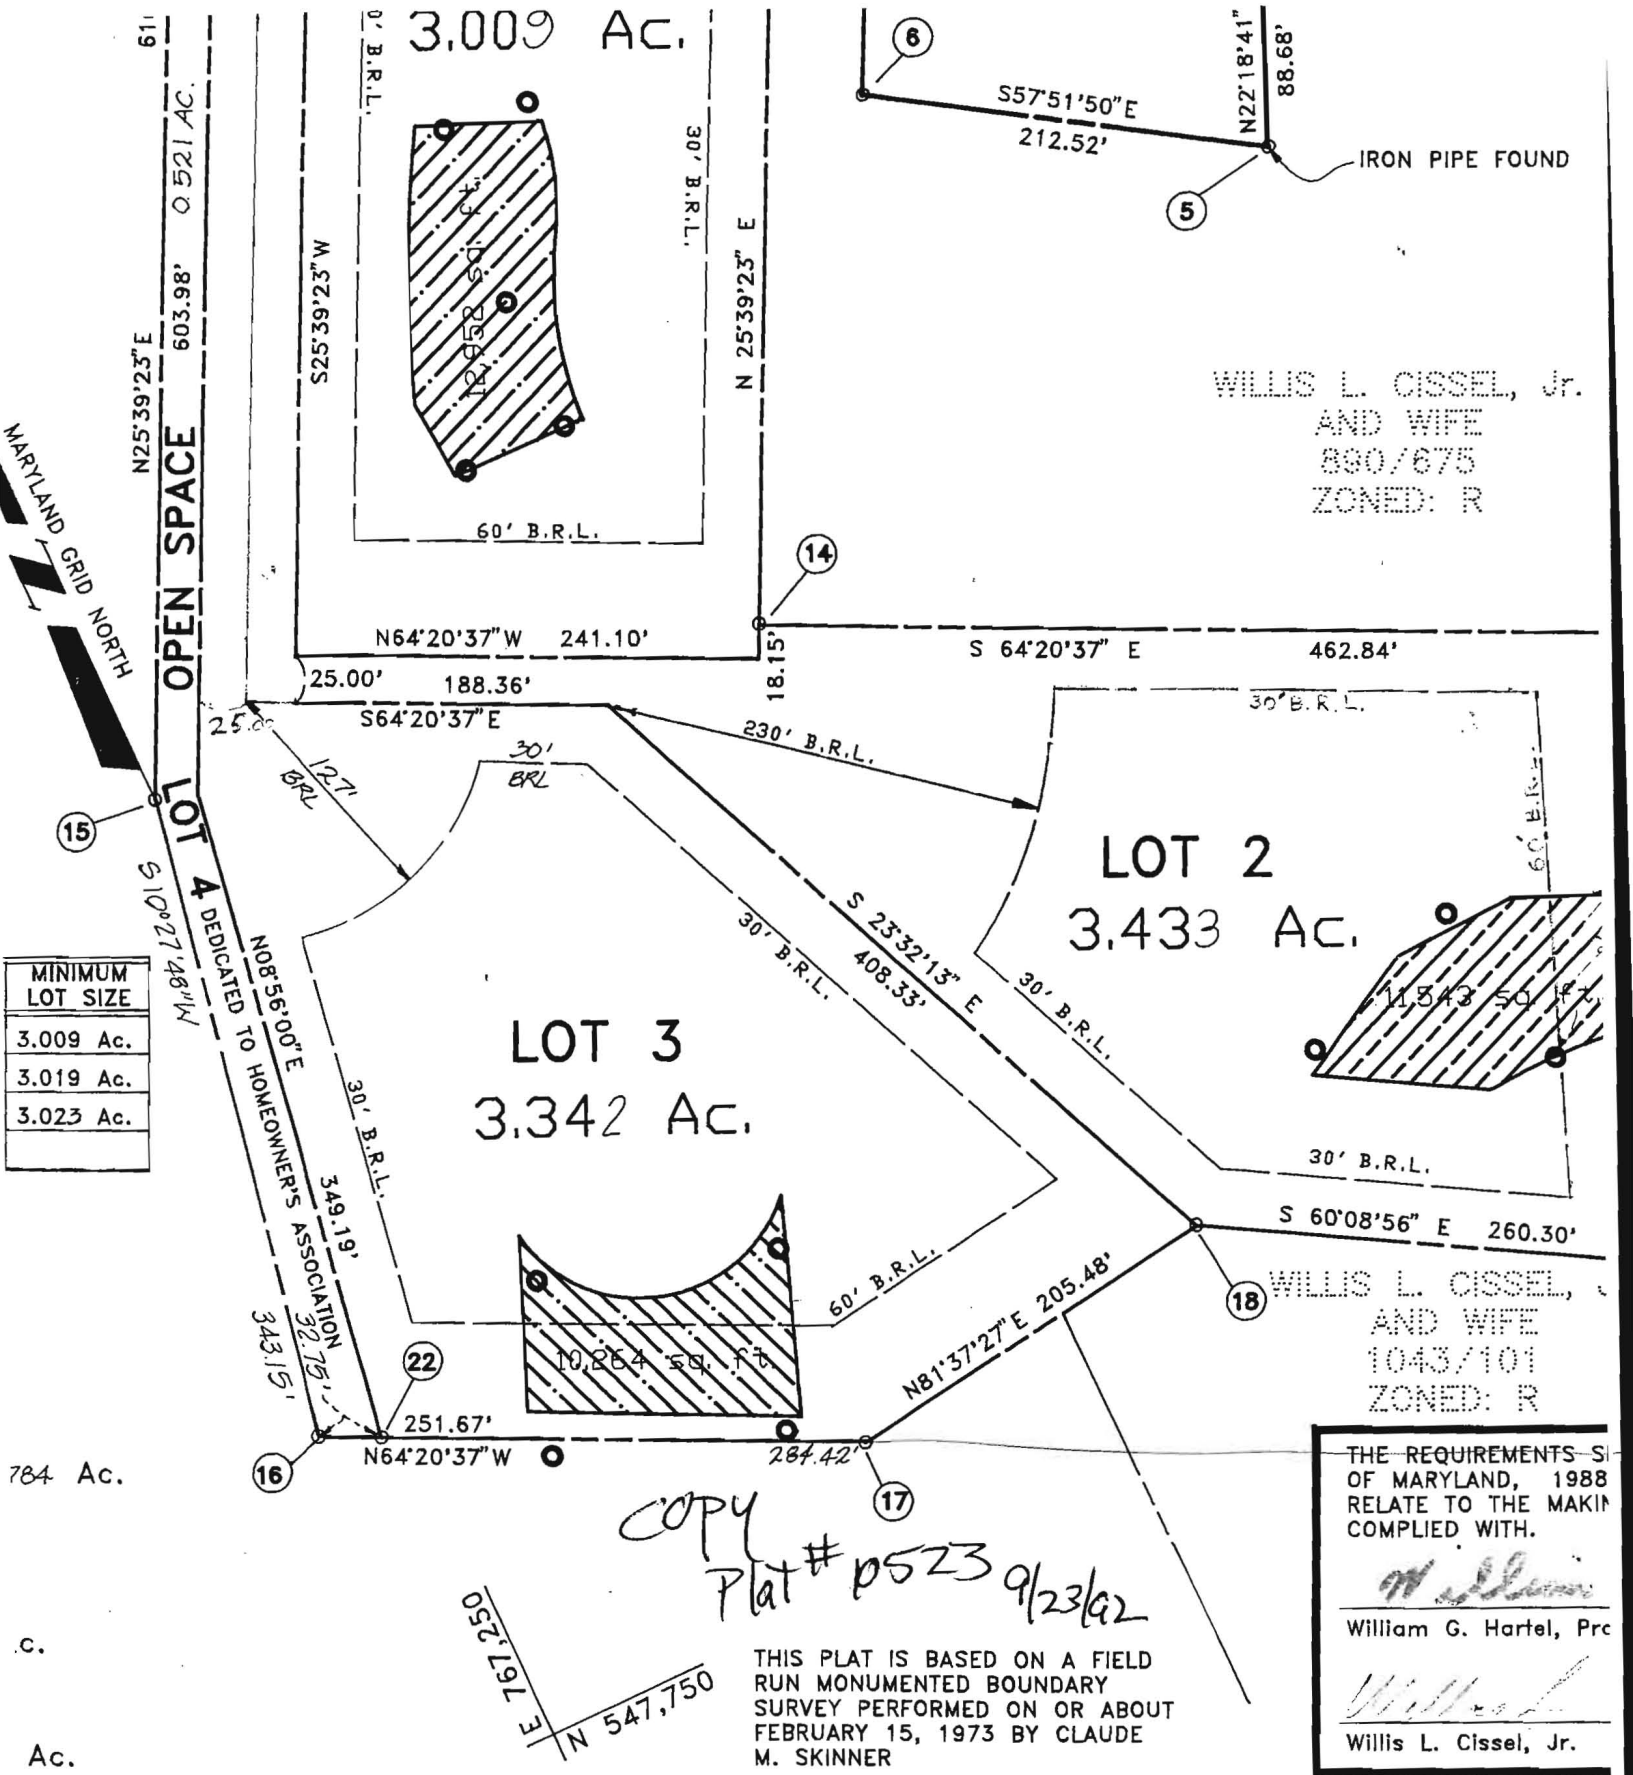

**OWNER'S STATEMENT**

**SURVEY**

I, Willis L. Cissel, Jr. & Marjorie S. Cissel, owners of the property shown and described hereon, do hereby certify that this is a subdivision plan of subdivision, and in consideration of the approval of this final plat by the Department of Planning and Zoning, establish the minimum building restriction to be granted unto Howard County, Maryland, its successors and assigns, 1) the right to construct and maintain sewers, drains, water pipes and other municipal utilities, and in and under all roads and street rights-of-way and the specific easements shown, 2) the right to require dedication for public use, the beds of the streets

I hereby certify that this is a subdivision plan of subdivision, and in consideration of the approval of this final plat by the Department of Planning and Zoning, establish the minimum building restriction to be granted unto Howard County, Maryland, its successors and assigns, 1) the right to construct and maintain sewers, drains, water pipes and other municipal utilities, and in and under all roads and street rights-of-way and the specific easements shown, 2) the right to require dedication for public use, the beds of the streets