

12688 FRANK RD.  
WEST FRIENDSHIP MD 20794

B17000886

APPROVED


WALK-THRU BUILDING PERMIT

BP# 17000886 A#

APP. SAN DBernard DATE: 4/12/17

DESC. OF WORK: Basement

Approved as shown

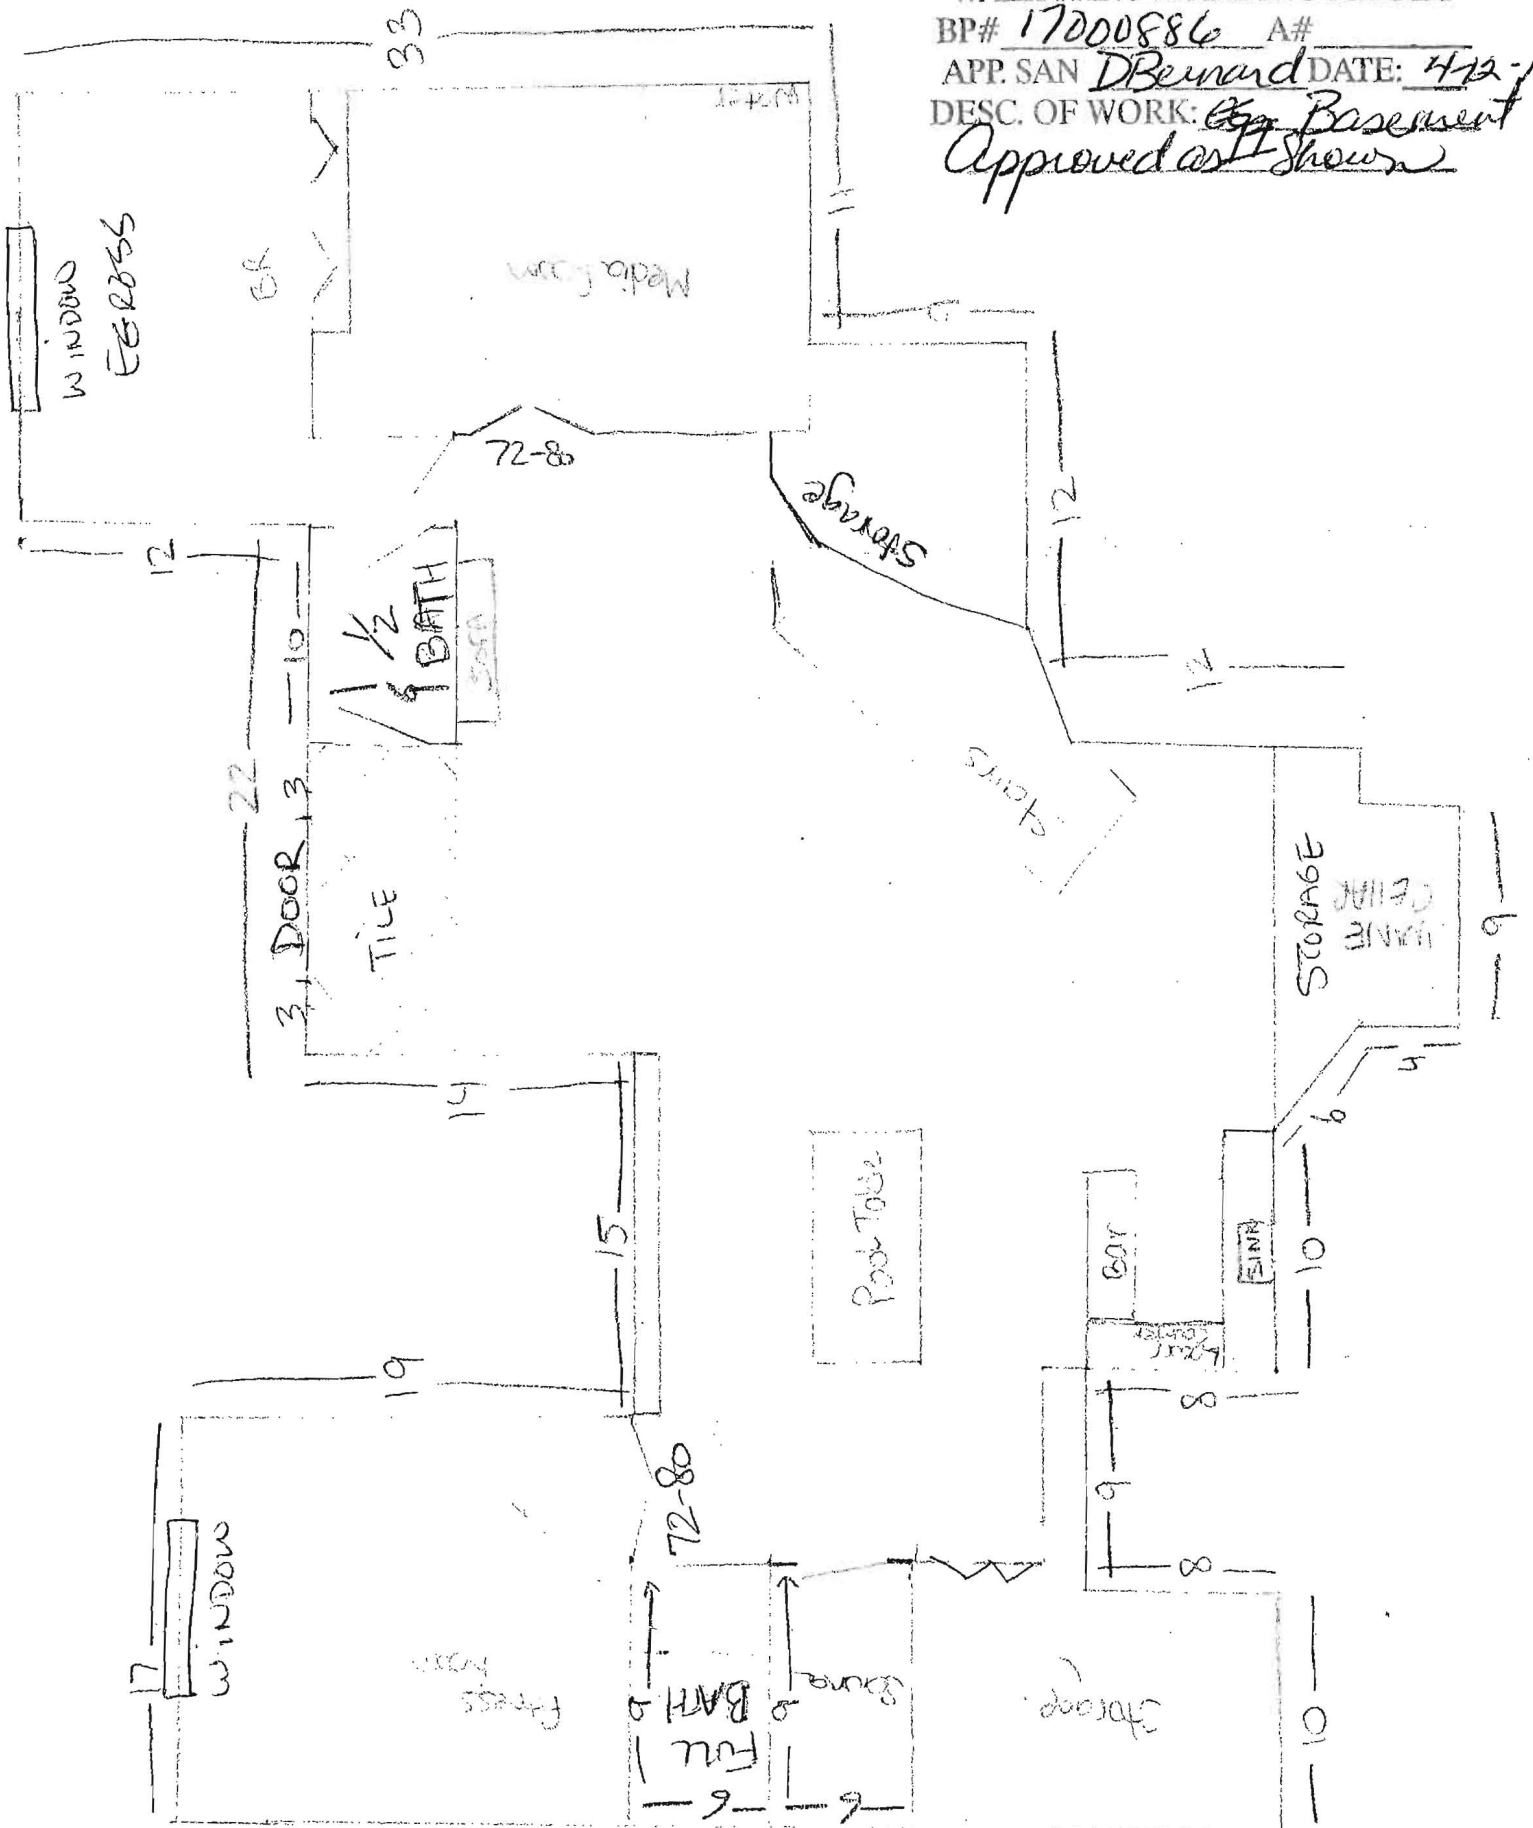

12668 FRANK PD:  
 WEST FRIENDSHIP RD 21910

B17000886

APPROVED


WALKTHRU BUILDING PERMIT

BP# 17000886 A#

APP SAN DEVID DATE: 4-17-17

DESC. OF WORK: *By Permit*

*Approved at Show*

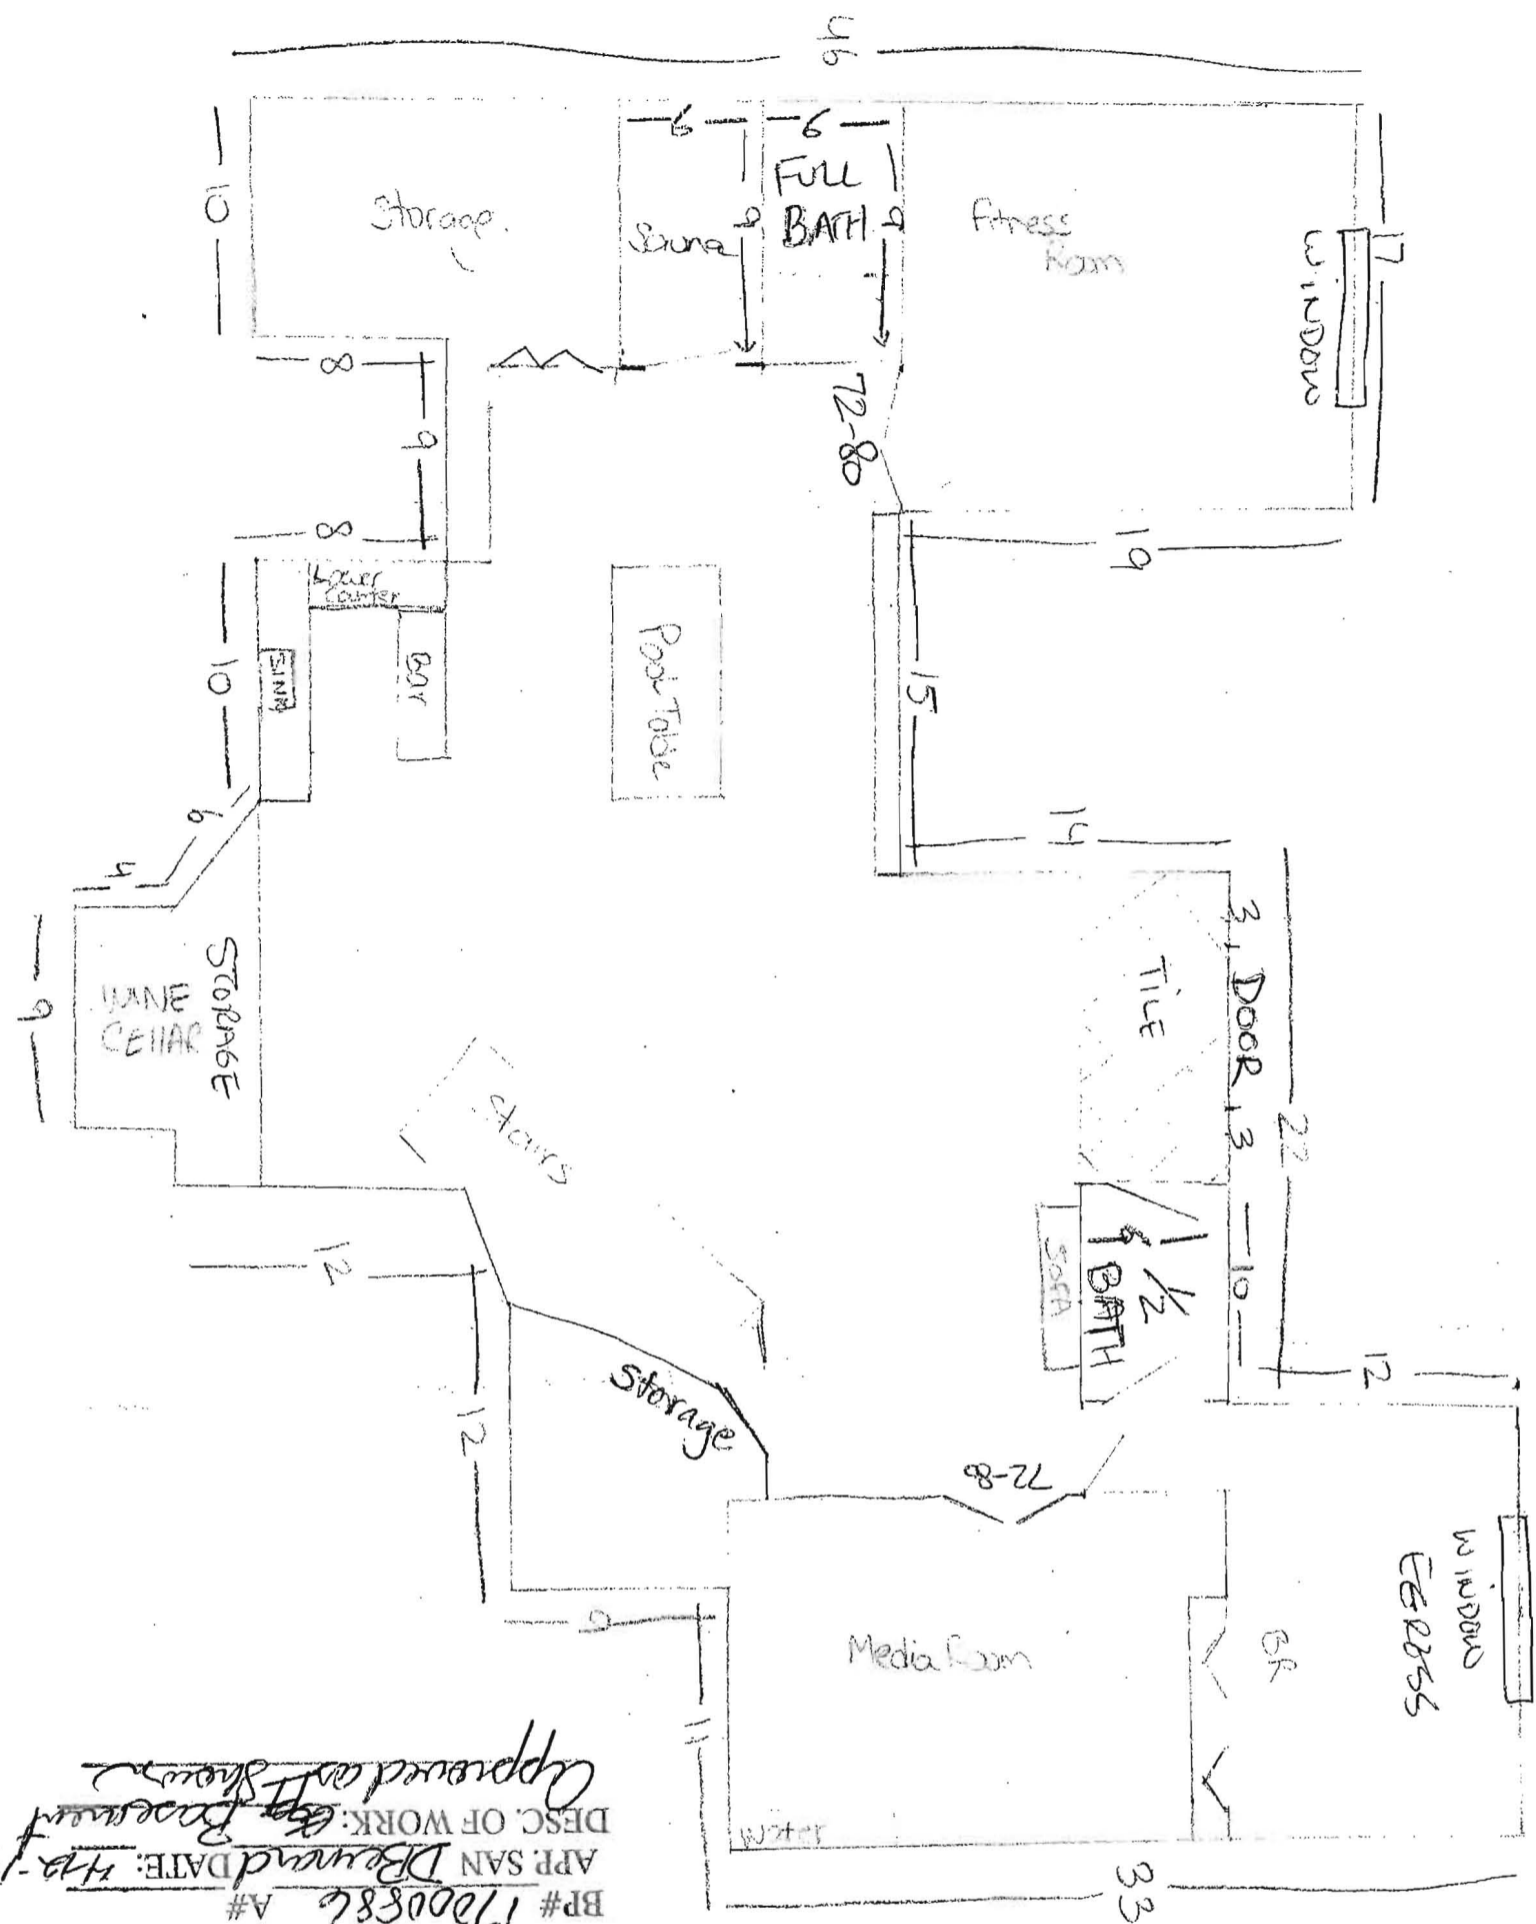

12688 FREDRICK RD.  
WEST FRIENDSHIP MD 21794

B17000886


APPROVED

WALK-THRU BUILDING PERMIT

BP# 17000886 A#

APP. SAN DBernard DATE: 4-12-17

DESC. OF WORK: Basement  
Approved as shown

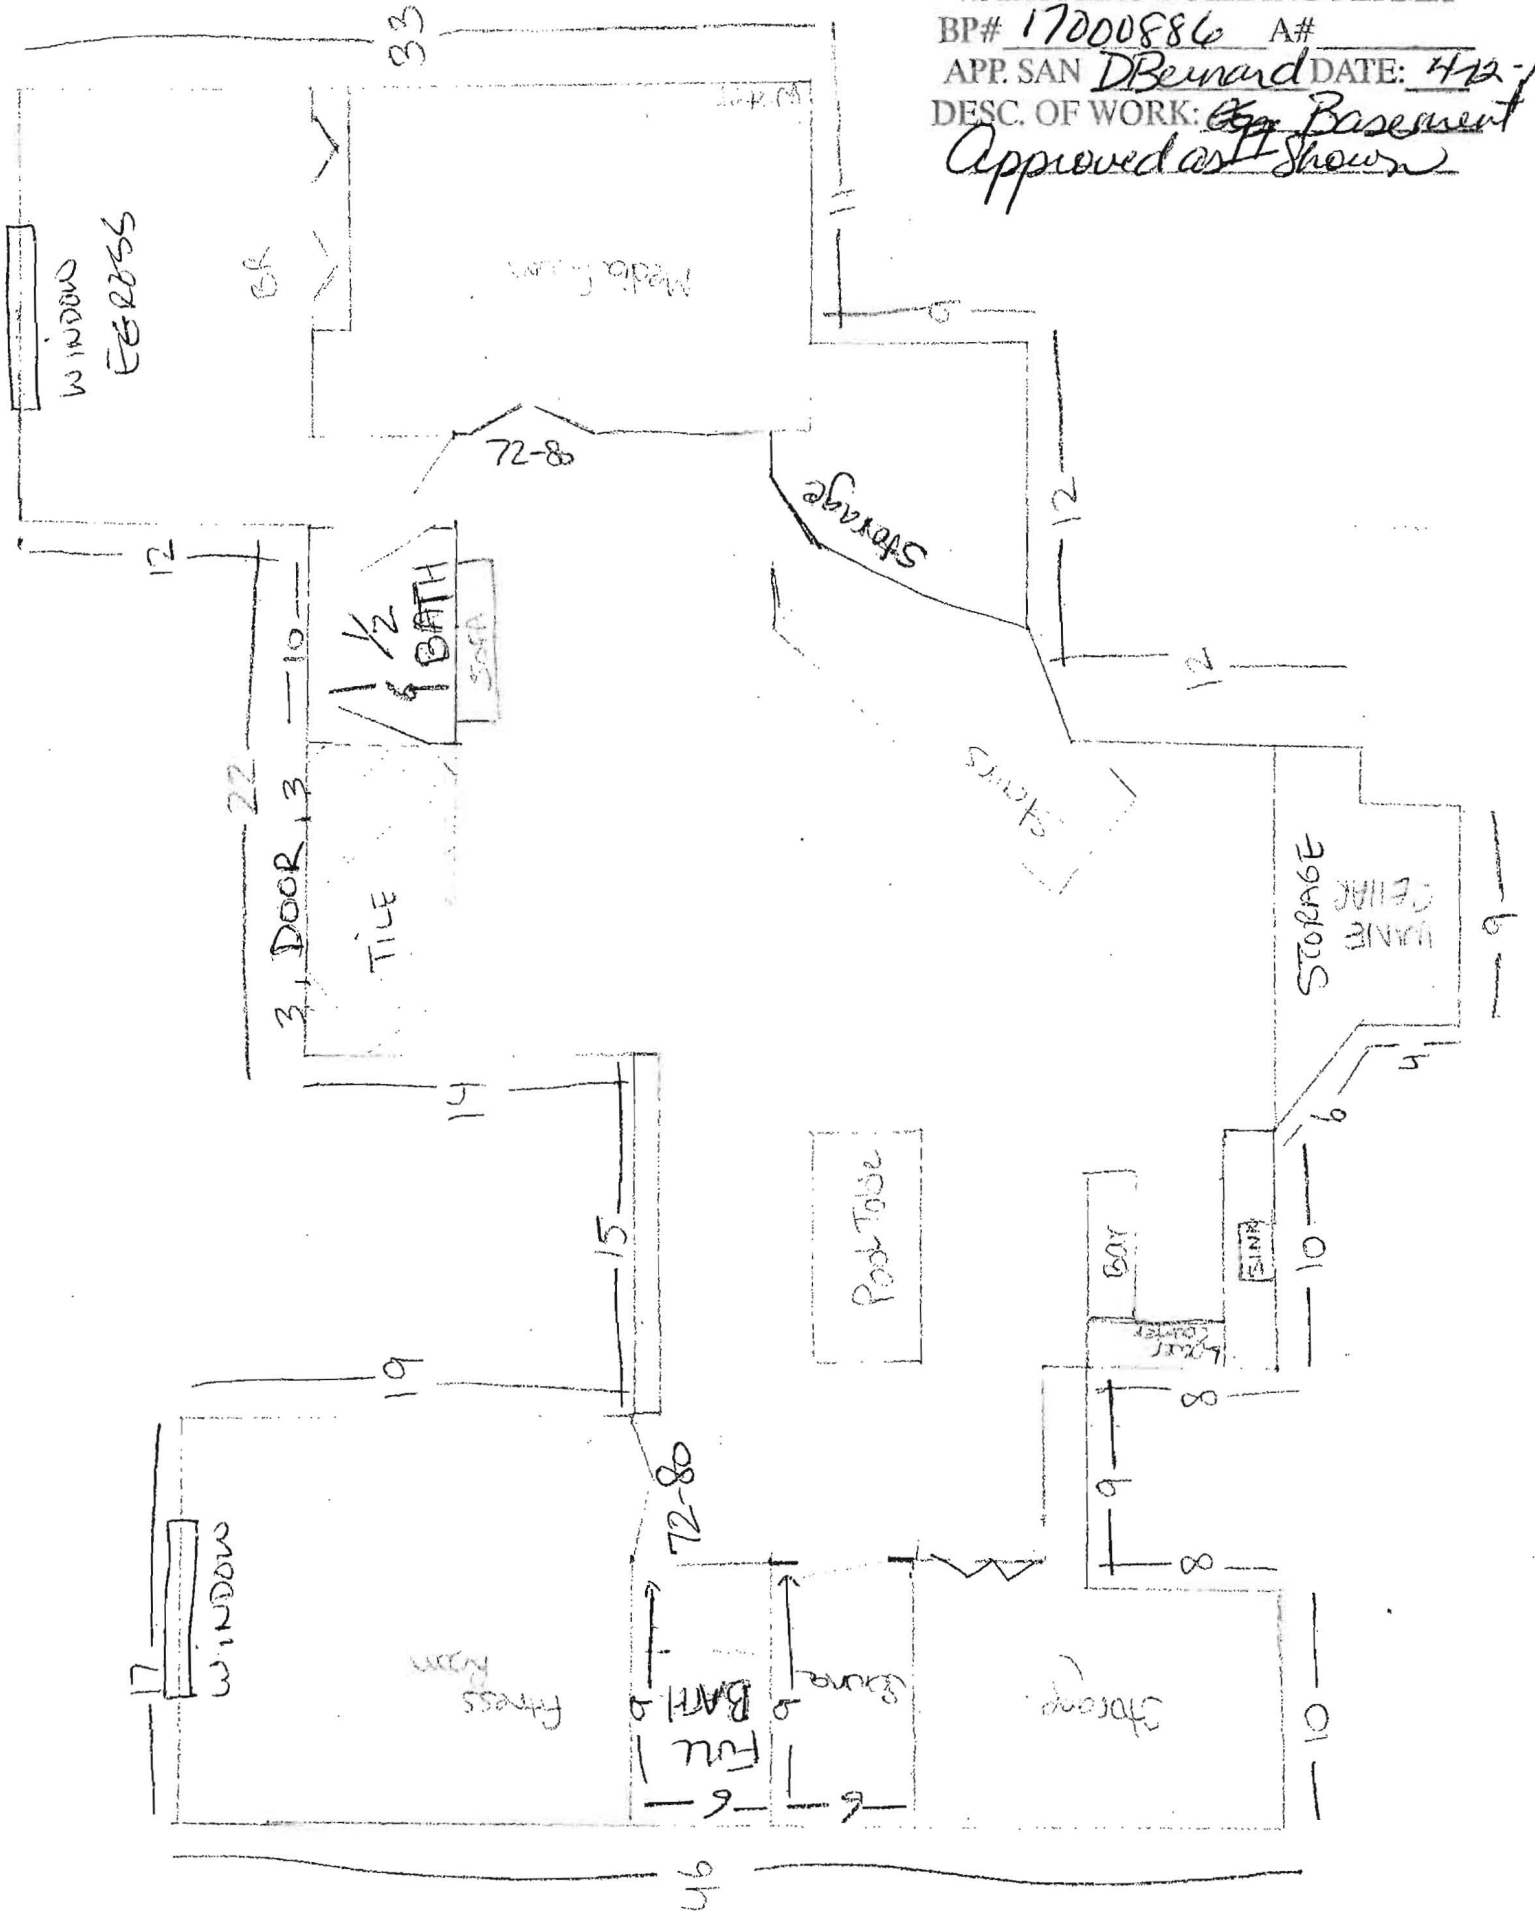

**HOWARD COUNTY**  
**DEPARTMENT OF INSPECTIONS, LICENSES AND PERMITS**  
**3430 COURT HOUSE DRIVE**  
**ELLCOTT CITY, MD 21043**

---

---

**Residential Interior Alteration Single Family Dwelling Permit**

---

---

PERMIT NUMBER: B17000886

APPLICATION DATE: 3/9/2017

ISSUE DATE: 3/9/2017

---

---

**SITE ADDRESS:**

12668 FREDERICK RD  
WEST FRIENDSHIP, MD 21794

**PROPERTY OWNER INFO:**

ALEX SONG  
12668 STATE ROUTE 144  
WEST FRIENDSHIP, MD 21794  
Phone #: 202-430-3076

Subdivision: Terrapin Reserve

Lot No.: 1      Tax Map: 15      Grid: 15-11

ADC Map: 4813-H2      SDP No.:      Zoning: RR-DEO      Census Tract: 603000

**DESCRIPTION OF WORK:**

SFD/ FINISH BASEMENT TO INCLUDE: BEDROOM, FULL BATH , HALF BATH, MEDIA ROOM, & HOME OFFICE, RECREATION ROOM WITH WET BAR & UNFINISHED STORAGE ROOM, APPROXIMATELY 2,500 SQ FT

**PRIMARY CONTRACTOR INFO:**

Contractor License No.: 0

License Address: HOMEOWNER  
ALEX SONG

12668 STATE ROUTE 144  
Phone #: WEST FRIENDSHIP, MD 21794  
202-430-3076

**PRIMARY CONTACT INFO:**

Contact Type: CONTACT  
HOMEOWNER

12668 STATE ROUTE 144  
WEST FRIENDSHIP, MD 21794

Phone #: 202-430-3076

**Building/Lot Characteristics**

---

---

Legal Description: IMPSLOT 1 1.390 A[ ]12668 FREDERICK RD[ ]TERRAPIN PRESERVE

Existing Use:

Water Supply:

Height:

Sewage Disposal:

Basement:

SF # of Bedrooms:

SF # of Full Baths:

SF # of Half Baths:

---

---

**Zoning Setback Requirements:**

Front -	Proposed:	Required:
Rear -	Proposed:	Required:
Side -	Proposed:	Required:
Side Street -	Proposed:	Required:

**Permit Fees:**

Total Fees Invoiced:	\$135.00
Total Fees Paid:	\$135.00
Balance Due:	\$0.00

Meets Minimum Required Setbacks?:

Lot Coverage for NT Zoning:

To schedule an inspection or check the results of an inspection please call (410) 313-3800

**APPROVED BY THE DIRECTOR OF INSPECTIONS, LICENSES AND PERMITS - BUILDING OFFICIAL**