

APPLICATION

6/11/92 10:00
6/12/92

PERCOLATION TESTING

A 48193
P _____

HOWARD COUNTY HEALTH DEPARTMENT
BUREAU OF ENVIRONMENTAL HEALTH
PO BOX 476 ELLICOTT CITY, MARYLAND 21043
TELEPHONE 461-9933

PERCULOW OK -
ADALL, ANBA RENOTE
FROM EXISTING SYSTEM,
FULL 10,000 SQ FT
TO BE PERC'D.
6/11/92 *Carroll*

DISTRICT 2ND
DATE 5/27/92

TO: THE COUNTY HEALTH OFFICER
ELLICOTT CITY, MARYLAND

EXISTING SYSTEM - REPAIR ONLY

I HEREBY APPLY FOR THE NECESSARY TEST IN ORDER TO CONSTRUCT (OR RECONSTRUCT) A SEWAGE DISPOSAL SYSTEM.

PROPERTY OWNER MRS. ELIZABETH SAUTER

ADDRESS 8431 OLD FREDERICK RD ELLICOTT CITY, MD 21043
PHONE 461-1354

PROSPECTIVE BUYER N/A

ADDRESS _____ PHONE _____

PROPERTY LOCATION:

SUBDIVISION SAUTER PROPERTY LOT NO. 1

ROAD AND DESCRIPTION EAST SIDE OF OLD FREDERICK RD 250' NORTHEAST OF
INTERSECTION OF ROLLING RIDGE COURT & OLD FREDERICK RD.

TAX MAP 18 PARCEL # 313

SIZE OF LOT 2.84 AC. ± TYPE BLDG. EXISTING SINGLE FAMILY
(SINGLE FAMILY DWELLING OR COMMERCIAL)

THE SYSTEM INSTALLED UNDER THIS APPLICATION IS ACCEPTABLE ONLY UNTIL PUBLIC FACILITIES BECOME AVAILABLE. I FULLY UNDERSTAND THE FEE CONNECTED WITH THE FILING OF THIS PERC TEST APPLICATION IS NON-REFUNDABLE UNDER ANY CIRCUMSTANCES. I ALSO AGREE TO COMPLY WITH ALL M.O.S.H.A. REQUIREMENTS IN TESTING THIS LOT.

Elizabeth Sauter
(SIGNATURE OF APPLICANT)

APPROVED BY _____ FOR _____ DATE _____

REJECTED BY _____ FOR _____ DATE _____

HOLD PENDING FURTHER TESTS _____ DATE _____

REASONS FOR REJECTION OR HOLDING PERC OK, HOLD FOR PLAT MR 6/23/92

BLDG. PERMIT SIGNED
AND RETURNED 6/10/92
Serial # 52316
Interior alterations - Bathroom

HD-216


THIS IS NOT A PERMIT

Lot 1
48193

↑ Lot 2

① ② ③ ④
SOIL PROFILE

brn sa
cl lm
2 1/2 - 3
lt. brn
tan beige
sa lm
10% soft
sandstone
& other
frags
12 1/2 - 13

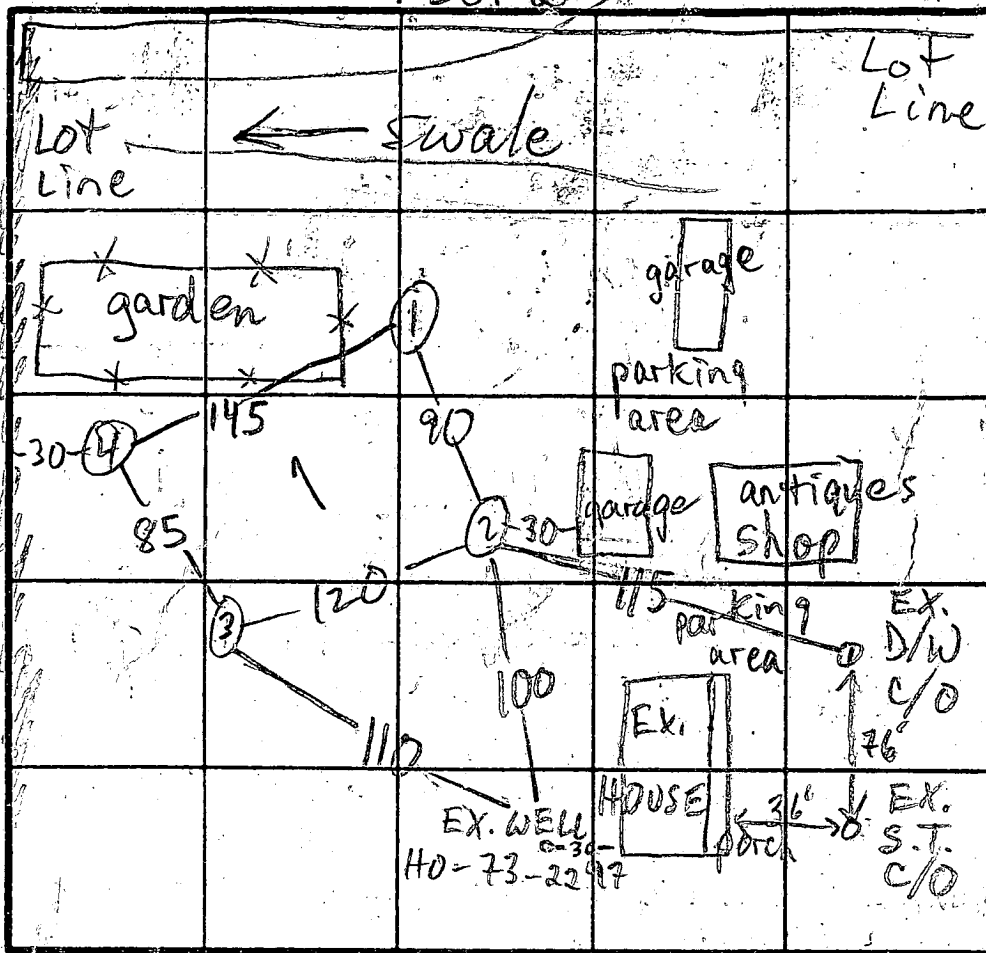

② ③ H1
① ④ L0
x=3
180 BR
Inlet 3 1/2
Bottom 7 1/2

OLD FRED. RD INDICATE NORTH - NAME ADJOINING ROADWAY AS BASE LINE.

DATE	TEST NO.	DEPTH	PRE-WET		TEST - 1" DROP		TIME
			START	STOP	START	STOP	
6/12/92	1 S	3 1/2	11:33	11:35	11:35	11:38	3
"	1 V	12' 9"	see profile				
	2 S	3 1/2	11:45	11:47	11:47	11:50	3
	2 M	7 1/2	11:47	11:48:30	11:48:30	11:50:30	2
	2 V	13	see profile				
	3 V	13	see profile				
	4 S	3 1/2	12:04	12:05:30	12:05:30	12:08	2 1/2
	4 V	13	sim to profile		more brown		

REMARKS HOLES PER PLAN

TYPE OF SOIL

TESTED BY M. R. Skin

ALSO PRESENT OK JF

FILE INQUIRY FORM

Property Address: 8431 Old Frederick Rd.

3⁴⁵ 2/9/04 Called Dave Naxon and requested information on whether ~~the~~ this project is ~~in~~ in the metropolitan district and if water and sewer is available to them. (FR)

2/10/04 ~~Spoke to~~

9^{30 AM} 2/12/04 Called Ron Fenzel of Shamrock & Lane & told him I needed a new plan, perc test plan, C, 1"=50" scale for the proposed subdivision of lot 1. He wanted a perc date but I told him I could not give him one until I have a ~~new~~ revised plan.

9^{00 AM} 3/15/04 Spoke to Ron Fenzel this morning to confirm the message he left me earlier on 3/12/04 cancelling the perc on the proposed subdivision of (Souter) property. He told me that the owners had decided not to perc test at this time. (FR) Told Ron Fenzel of Shamrock & Lane to send a receipt written ~~to~~ request for a refund ^{of receipt} to Mary Lou Buggs. (FR)

3/16/04 Proposed perc testing for subdivision to two lots cancelled. See subdivision file under Souter, Old Frederick Rd. (FR)