

PUB. SEWER STATUS VERIFIED BY \_\_\_\_\_

ISSUE DATE: 3/12/07

P 526276

APPROVAL DATE: 3/29/07

# PERMIT

A REPAIR 15127

Tax ID # 03-286894

## ON-SITE SEWAGE DISPOSAL SYSTEM HOWARD COUNTY HEALTH DEPARTMENT BUREAU OF ENVIRONMENTAL HEALTH

Jenkins Bros. Septic Services IS PERMITTED TO INSTALL  ALTER

ADDRESS: 7670 Smiths Private Road, Sykesville PHONE NUMBER: 410-781-7133

SUBDIVISION: \_\_\_\_\_ LOT NUMBER: 1

ADDRESS: 11280 Old Frederick Road PROPERTY OWNER: Melvia Hawkins

SEPTIC TANK CAPACITY (GALLONS): \_\_\_\_\_

PUMP CHAMBER CAPACITY (GALLONS): \_\_\_\_\_

NUMBER OF BEDROOMS: \_\_\_\_\_

SQUARE FEET PER BEDROOM: \_\_\_\_\_

LINEAR FEET OF TRENCH REQUIRED: \_\_\_\_\_

TRENCHES:	Trench to be _____ feet wide. Inlet _____ feet below original grade. Bottom maximum depth _____ feet below original grade. Effective area begins at _____ feet below original grade. _____ feet of stone below distribution pipe.
LOCATION:	_____
PURPOSE:	Existing septic system has failed. Call for inspection when ground is opened so sanitarian can recommend repair.

PLANS APPROVED: \_\_\_\_\_ DATE: \_\_\_\_\_

NOTE: PERMIT VOID AFTER 2 YEARS

NOTE: CONTRACTOR RESPONSIBLE FOR SCHEDULING A PRE-CONSTRUCTION INSPECTION FOR ALL INSTALLATIONS


NOTE: WATERTIGHT SEPTIC TANKS REQUIRED

NOTE: ALL PARTS OF SEPTIC SYSTEM SHALL BE 100 FEET FROM ANY WATER WELL

NOTE: MANHOLE RISERS REQUIRED ON ALL SEPTIC TANKS AND PUMP CHAMBERS

**NEITHER THE HOWARD COUNTY COUNCIL OR THE HEALTH DEPARTMENT IS  
RESPONSIBLE FOR THE SUCCESSFUL OPERATION OF ANY SYSTEM  
PERMITTEE RESPONSIBLE FOR OBTAINING FINAL APPROVAL ON THIS PERMIT  
CALL 410-313-2640 FOR INSPECTION OF SEPTIC SYSTEM**

NOT TO SCALE

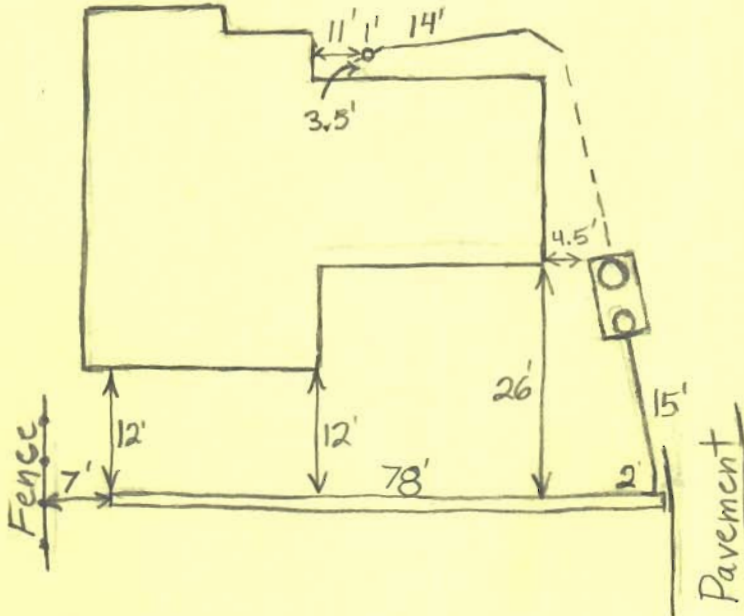

Old Frederick

ROAD

TRENCH/DRAINFIELD DATA		
WIDTH	INLET	BOTTOM
2'	3.5'	14'
NUMBER OF TRENCHES		1
TOTAL LENGTH		78'
ABSORPTION AREA		~663
DISTRIBUTION BOX LEVEL		<input type="checkbox"/>
DISTRIBUTION BOX BAFFLE		<input checked="" type="checkbox"/>
DISTRIBUTION BOX PORT		<input checked="" type="checkbox"/>

SEPTIC TANK DATA	
SEPTIC TANK 1 LEVEL	Yes
CAPACITY	1500 GAL
SEAM LOC	Top
TANK LID DEPTH	0.5-1.5
BAFFLES	Yes
BAFFLE FILTER	No
MANHOLE LOC	Front+Rear
6" PORT LOC	None
WATERTIGHT TEST	No
SEPTIC TANK 2 LEVEL	N/A
CAPACITY	_____ GAL
SEAM LOC	_____
TANK LID DEPTH	_____
BAFFLES	_____
BAFFLE FILTER	_____
MANHOLE LOC	_____
6" PORT LOC	_____
WATERTIGHT TEST	_____

PRE-CONSTRUCTION 3/28/07 Tank set, Trench location marked (BB)

INSTALLATION 3/29/07 System finished, O.K. to backfill. Old tank and drywell pumped out and filled in. (BB)

FINAL INSPECTOR B. Baker

DATE OF APPROVAL 3/29/07

Fee Paid \$ 336.00  
Receipt # P 526 276

**SEPTIC SYSTEM REPAIR / UPGRADE / EVALUATION REQUEST**

**Please fill out this form completely and check off the reason for the request:**

Date requested: \_\_\_\_\_

**Reason for Request**

Failing System (includes surface discharge or inadequate treatment zone) Yes

Has the contractor verified through excavation/pumping evaluation, that there are no pipe blockages? Yes

In support of a building permit. Type of building addition: \_\_\_\_\_

\*System relocation for proposed addition for setback compliance \_\_\_\_\_

\*Verification of adequate system capacity per COMAR 26.04.02.02D (4) \_\_\_\_\_

To replace collapsed septic tank or upgrade tank capacity \_\_\_\_\_

To replace collapsed drywell \_\_\_\_\_

\*\*\*\*\*  
Septic Contractor: Charles Jenkins (Jenkins Bros Septic Svc Inc.)

Contractor's Address: 7670 Smiths Private Rd  
Sykesville, Md 21784

Contractor's Phone #: 410 781 7133

Property Address: 11280 Old Frederick Rd Marriottsville, Md  
21104

Property (Subdivision) & Lot # \_\_\_\_\_

Owner's Name: Melvia V Hawkins

Is public sewer available/nearby: No

Names of Any Previous Owners: \_\_\_\_\_

Year House Built: \_\_\_\_\_

# of Existing Bedrooms: \_\_\_\_\_

# of Bedrooms after completion of addition: \_\_\_\_\_


Has this request been discussed previously with a Sanitarian, who? No

*If public sewer is close, further research will be performed to verify availability and possible hook up to public sewer.*


A Sanitarian will be in contact within three business days depending upon the urgency of the situation to coordinate the scheduling of the repair/upgrade/evaluation. No inspection will be performed without fee collection at the office.

Environmental Sanitarian tentatively assigned Charles Jenkins

FAX TO 410-313-2648

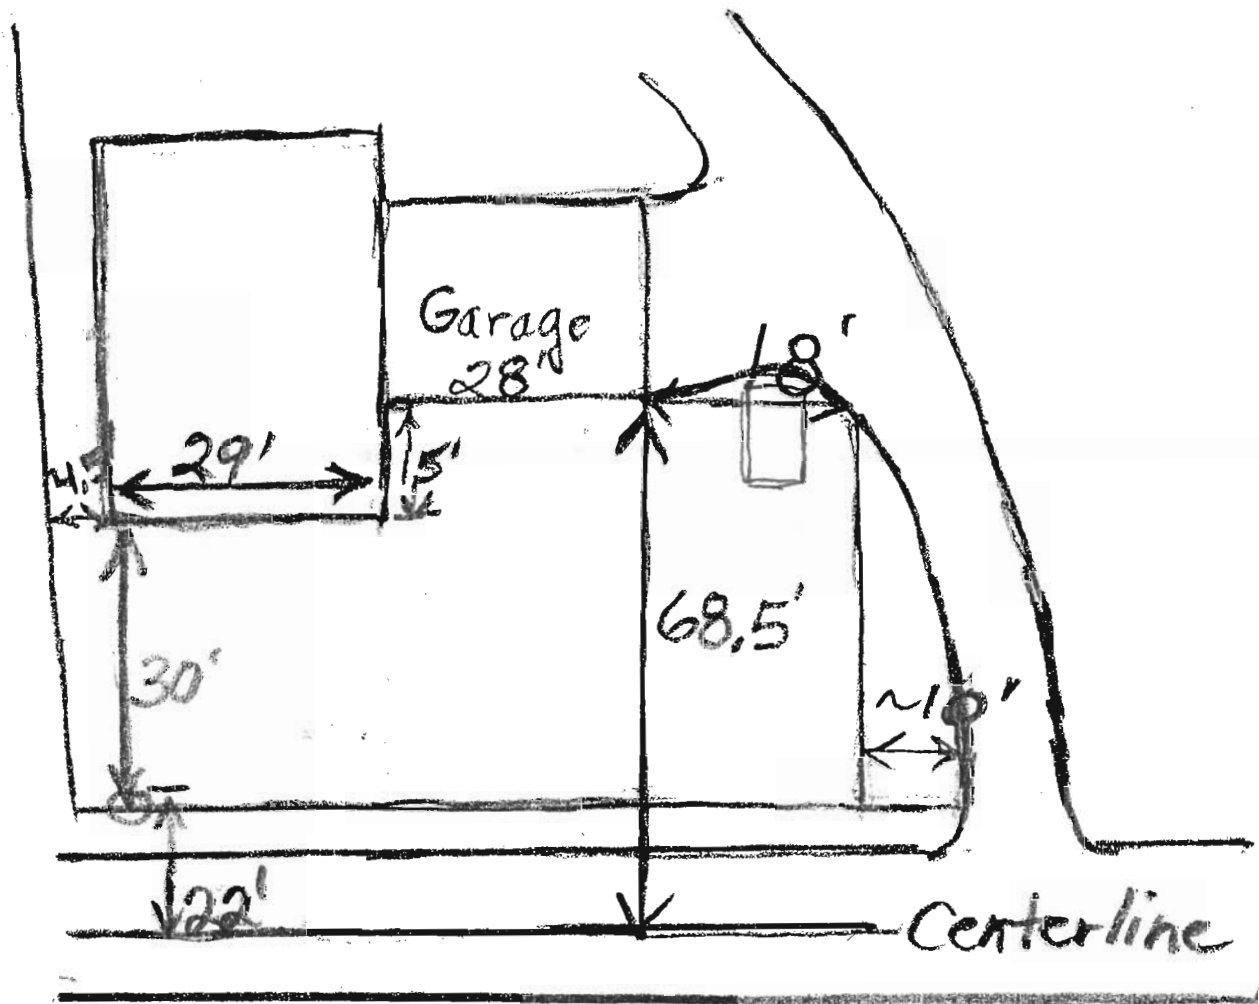

↑  
Route 99

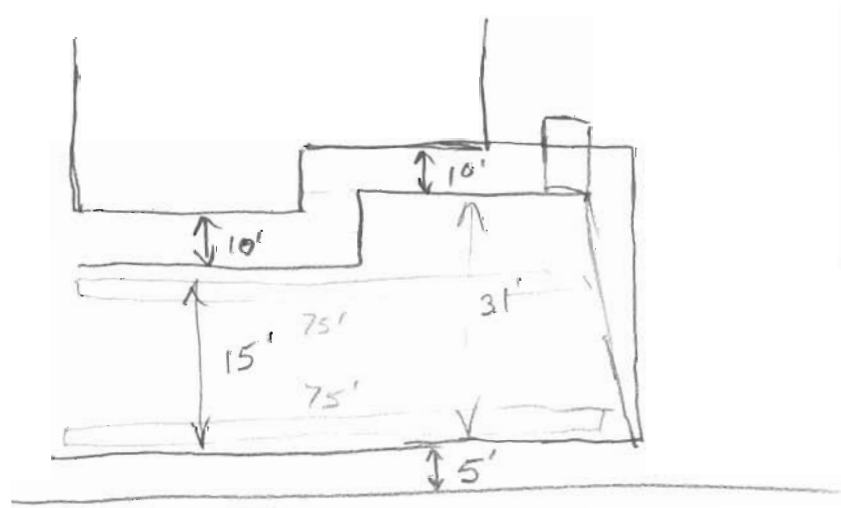

2' 75'  
Inlet 5'  
Bottom - 14' 75'

10' - 14'