

# APPLICATION

A 22876

PRELIMINARY

SEWAGE DISPOSAL TESTING

P \_\_\_\_\_

3/3/76  
9:30 A.M.

STATE OF MARYLAND - DEPARTMENT OF HEALTH AND MENTAL HYGIENE

HOWARD COUNTY HEALTH DEPARTMENT  
ENVIRONMENTAL HEALTH SERVICES  
P. O. BOX 476, ELLICOTT CITY, MARYLAND 21043  
TELEPHONE: 465-3000, EXT. 356

DISTRICT 3rd

DATE 2/27/76

TO: THE COUNTY HEALTH OFFICER  
ELLICOTT CITY, MARYLAND

I, HEREBY, APPLY FOR THE NECESSARY TEST IN ORDER TO CONSTRUCT (OR RECONSTRUCT) A SEWAGE DISPOSAL SYSTEM.

PROPERTY OWNER Charles J. Rositzky

ADDRESS 6313 Frederick Road, Balto., Md. 21228 PHONE 788-9583

PROPERTY LOCATION: \_\_\_\_\_

SUBDIVISION \_\_\_\_\_ LOT NO. Lot 1 *New 6/11/76 (copy of plat)*

ROAD AND DESCRIPTION Route 99 - 1/2 mile past Marriottsville Road on the right hand side of road

SIZE OF LOT ? 2.33 acres TYPE BLDG. 3 or 4 bedrooms  
NUMBER OF BEDROOMS \_\_\_\_\_

IF NOT SINGLE RESIDENCE DESCRIBE \_\_\_\_\_

THE SYSTEM INSTALLED UNDER THIS APPLICATION IS ACCEPTABLE ONLY UNTIL PUBLIC FACILITIES BECOME AVAILABLE.

BLDG. PERMIT SIGNED AND RETURNED 11/10/80  
# 44976 S.F.D

SIGNATURE OF APPLICANT /s/ Charles J. Rositzky


APPROVED BY William H. Zapp FOR Modified tile field DATE 6/1/76  
(KIND OF SYSTEM)

REJECTED BY \_\_\_\_\_ FOR \_\_\_\_\_ DATE \_\_\_\_\_  
(KIND OF SYSTEM)

HOLD PENDING FURTHER TESTS 1W2 DATE 3/4/76

REASONS FOR REJECTION OR HOLDING final plat is certified false. Discrepancy on lot lines and hole locations. Ck final plat very closely 10

## THIS IS NOT A PERMIT

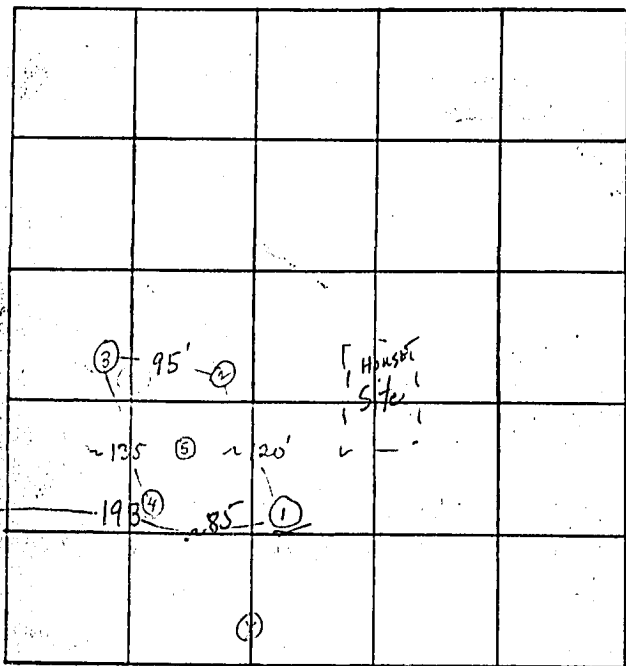

DATE	TEST NO.	DEPTH	PRE-WET		TEST - 1" DROP		TIME	
			START	STOP	START	STOP		
3/3/76	①	3	11:47		Pulled plug - little movement			
	1-A	8	11:53	11:56	11:56	12:00	4	
	1-B	4 1/2	12:15	12:17	12:17	12:19	2	
	2	4 1/4	12:33	12:34	12:34	12:37	3	
	2-A	8	12:34	12:40	12:40	12:50	10	
	3	3	12:41	12:45	12:45	10:56	11	
	3-A	7 1/2	12:42	12:44	12:44	12:46	2	
	4	3	12:57	1:02	1:02	1:15	13	
	4-A	8	12:57	12:58	12:58	1:05	7	
	5	11	Time? 2 additional tests to adequate soil					

REMARKS 45 - only hole in sandstone type rock to adequate soil

TYPE OF SOIL Sandy loam

TESTED BY W/WZ

ALSO PRESENT: Baith & Co., owner.

125 #/BR  
 2nd test  
 5' depth