

11-28-62

PERMIT

*approved
11/28/62
[Signature]*

P. 05720
A. 05686

SEWAGE DISPOSAL SYSTEM

MARYLAND STATE DEPARTMENT OF HEALTH

HOWARD COUNTY

ELLICOTT CITY

DISTRICT 4
DATE 2/9/62

Howard Perlett IS PERMITTED TO INSTALL ALTER

ADDRESS _____ PHONE _____

A SEWAGE DISPOSAL SYSTEM LOCATED AT Dewall Rd - 1 mile from Mullinix Rd

SUBDIVISION _____ ROAD _____ LOT _____

PROPERTY OWNER Milton Jaycox

ADDRESS _____

SPECIFICATIONS

DRAIN FIELD _____ DEPTH _____ FEET. BOTTOM AREA _____ SQ. FT.
SEEPAGE PITS _____ ABSORBENT SIDE-WALL AREA 10'x10' deep below inlet pipe SQ. FT.
SEPTIC TANK CAPACITY 750 GALLONS

FOR GARBAGE GRINDER, INCREASE DISPOSAL AREA 22% & TANK CAPACITY 50%.

OTHER

Place the dry well in the area that passed percolation which is about 121 feet behind middle of house


PLANS APPROVED BY D.W. Monaghan DATE 2/27/62

FILL SEPTIC TANK AND DISTRIBUTION BOX WITH WATER BEFORE CALLING FOR AN INSPECTION. COVER NO WORK UNTIL INSPECTED AND APPROVED.

NEITHER THE HOWARD COUNTY COMMISSIONERS NOR THE HEALTH DEPARTMENT IS RESPONSIBLE FOR THE SUCCESSFUL OPERATION OF ANY SYSTEM.

A 05686

4
22
39
119

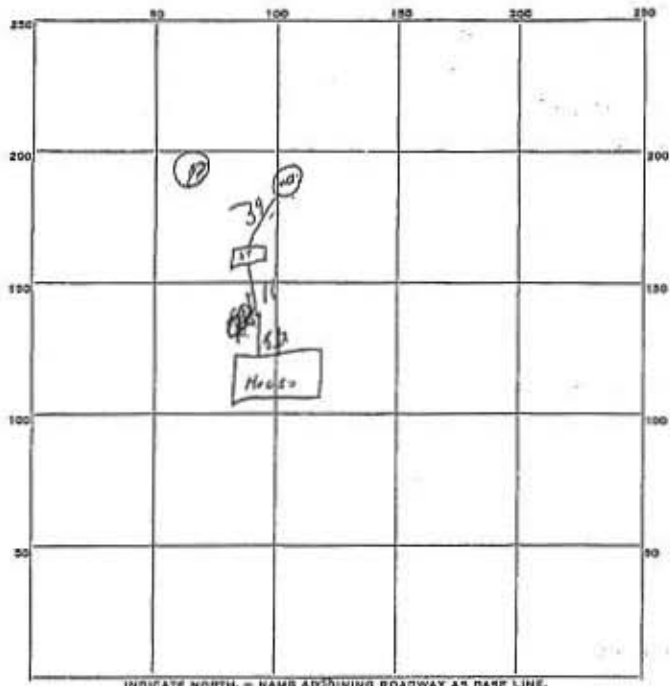

INDICATE NORTH - NAME ADJOINING ROADWAY AS BASE LINE.
Jurnal Road

PERMIT CARD ok

SEPTIC TANK, LEVEL ok CLEANOUTS OK

DISTRIBUTION BOX, LEVEL _____

TILE FIELD, DEPTH _____ FT. TRENCH WIDTH _____ FT.

GRAVEL DEPTH _____ IN. TOTAL LENGTH _____ FT.

NUMBER OF TRENCHES _____ TOTAL BOTTOM AREA _____

SEEPAGE PITS, INSIDE DIAMETER 10 FT. DEPTH BELOW INLET 7 1/4 FT.

ABSORBENT AREA 305 SQ. FT.

REMARKS _____

DATE SYSTEM APPROVED 11/35/62 INSPECTOR Bill Monaghan