

PERMIT

SEWAGE DISPOSAL SYSTEM

MARYLAND STATE DEPARTMENT OF HEALTH

HOWARD COUNTY

ELLICOTT CITY

DISTRICT 5

DATE 11/18/66

app- 11-22-66
DW P 12335

A 10336

11/22/66
Reading
H. M. J. J. J.

Check Speed 14A

INDEXED

Walter Seek

IS PERMITTED TO INSTALL ALTER

ADDRESS 501 Hermeleigh Rd., Silver Spring, Md. PHONE 593-6533

A SEWAGE DISPOSAL-SYSTEM LOCATED AT _____

SUBDIVISION Green Hill Manor ROAD Mink Hollow Rd. LOT 15, Blk. A

PROPERTY OWNER V. L. Vinella

ADDRESS _____

SPECIFICATIONS - 4 bedrooms

DRAIN FIELD _____ DEPTH _____ FEET, BOTTOM AREA _____ SQ. FT.

SEEPAGE PITS _____ ABSORBENT SIDE-WALL AREA _____ SQ. FT.

SEPTIC TANK CAPACITY 1,000 GALLONS

FOR GARBAGE GRINDER, INCREASE DISPOSAL AREA 22% & TANK CAPACITY 50%.


OTHER Dry well 13 ft. in dia. by 12 ft. deep below the inlet located 66 ft. from the left side property line and 48 ft. from the front property line as seen when facing the lot from Mink Hollow Road. Locate inlet 3 ft. below original grade.

MAXIMUM DEPTH PERMITTED 15' below original grade.

PLANS APPROVED BY J. Hennigan DATE 3/16/66

FILL SEPTIC TANK AND DISTRIBUTION BOX WITH WATER BEFORE CALLING FOR AN INSPECTION. COVER NO WORK UNTIL INSPECTED AND APPROVED.

NEITHER THE HOWARD COUNTY COMMISSIONERS NOR THE HEALTH DEPARTMENT IS RESPONSIBLE FOR THE SUCCESSFUL OPERATION OF ANY SYSTEM.

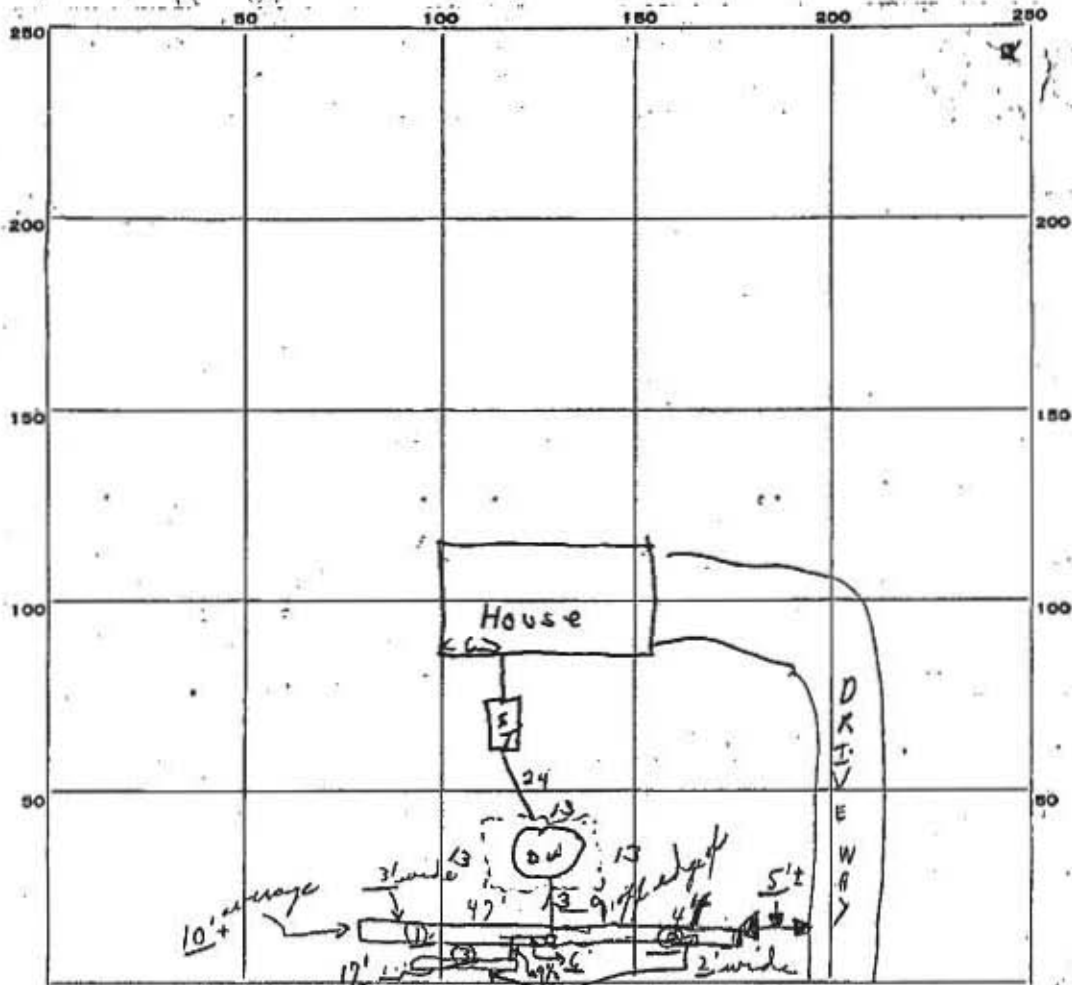

INDICATE NORTH - NAME ADJOINING ROADWAY AS BASE LINE.

Mink Hollow Road

PERMIT CARD OK

SEPTIC TANK, LEVEL OK CLEANOUTS OK

DISTRIBUTION BOX, LEVEL Using old. dry well as Dist Box 9/28/93

TILE FIELD, DEPTH _____ FT. TRENCH WIDTH _____ FT.

GRAVEL DEPTH _____ IN. TOTAL LENGTH _____ FT.

NUMBER OF TRENCHES _____ TOTAL BOTTOM AREA _____

SEEPAGE PITS, INSIDE DIAMETER 13 ft square DEPTH BELOW INLET 10 FT.

ABSORBENT AREA 1520 SQ. FT.

REMARKS _____

DATE SYSTEM APPROVED 11/22/66 INSPECTOR Bill Monaghan