

APPLICATION

A 10336

SEWAGE DISPOSAL TESTING

P _____

MARYLAND STATE DEPARTMENT OF HEALTH

HOWARD COUNTY

ELLICOTT CITY

3 bedrooms

DISTRICT 5

75 gal. septic tank

DATE 6/15/65

Existing well 11 ft. in dia. by 10 ft. deep below the inlet located 66 ft. from the left side of property line and 48 ft. from the front property line as shown on plan facing the lot front Mink Hollow road. Inlet 15 ft. below original grade.

TO: THE COUNTY HEALTH OFFICER,
ELLICOTT CITY, MARYLAND

4 bedrooms

100 gal. septic tank

Existing well 13 ft. in dia. by 12 ft. deep below inlet. Inlet at same location as above.

I, HEREBY, APPLY FOR THE NECESSARY TESTS IN ORDER TO CONSTRUCT (OR RECONSTRUCT) A SEWAGE DISPOSAL SYSTEM.

PROPERTY OWNER V. L. Vinella

ADDRESS 12631 Circle Dr., Glen Hills, Rockville, Maryland PHONE 301-762-3007

PROPERTY LOCATION:

SUBDIVISION Green Hill Manor LOT NO. 15, Blk. A

ROAD AND DESCRIPTION Mink Hollow Rd.

OCCUPANT _____ PHONE _____

PERSON TO CONSTRUCT SYSTEM _____

ADDRESS _____ PHONE _____

SIZE OF LOT: 41,100 sq. ft. TYPE BLDG. 3 or 4
NUMBER OF BEDROOMS

IF NOT SINGLE RESIDENCE DESCRIBE _____

SIGNATURE OF APPLICANT /s/ V. L. Vinella

APPROVED BY J. Hennigan FOR Dry Well DATE 3-16-66
(KIND OF SYSTEM)

REJECTED BY _____ FOR _____ DATE _____
(KIND OF SYSTEM)


HOLD PENDING FURTHER TESTS _____ DATE _____

REASONS FOR REJECTION OR HOLDING _____

THIS IS NOT A PERMIT

DECO

155'

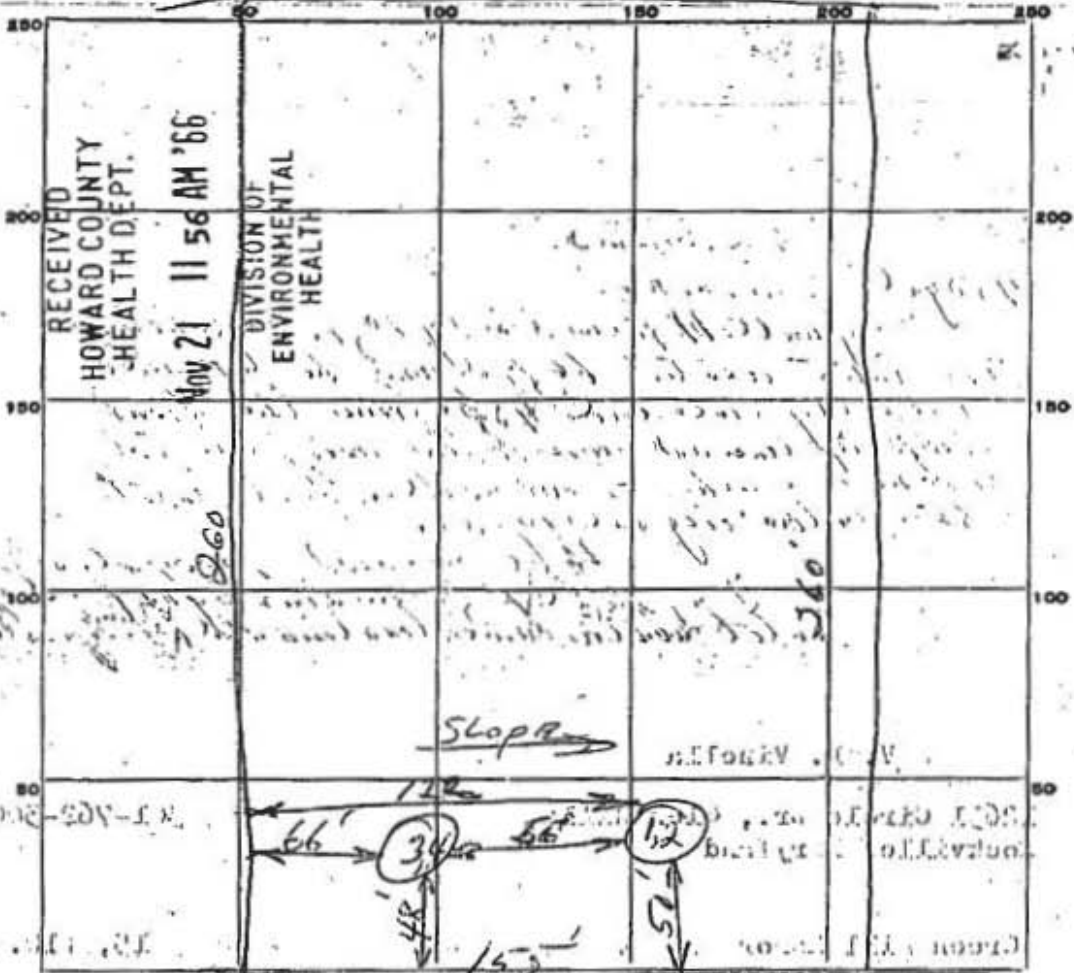

INDICATE NORTH - NAME ADJOINING ROADWAY AS BASE LINE.

MINK HOLLOW ROAD

DATE	TEST NO.	DEPTH	PRE-WET		TEST - 1" DROP		TIME
			START	STOP	START	STOP	
7/1/65	1) Same	4'	2:44	2:45	2:45	2:46	1 Min
	2) Pit	9'	2:45	2:46	2:46	2:47	1 Min
	3) Same	4'	2:48	2:49	2:49	2:50	1 Min
	4) Pit	9'	2:49	2:50	2:50	2:51	1 Min

Av. Perc
Tenn

SOIL AUGER FINDING

TESTED BY

REMARKS

Use hole (3.4) for dry well.

V. L. Vinella

Freemon, Robert

From: Garnish JC <JC.Garnish@irs.gov>
Sent: Wednesday, November 16, 2016 12:55 PM
To: Freemon, Robert
Subject: RE: 6718 Mink Hollow Rd.

Perfect, Thanks.

← Last Correspondence
w/ him

J.C. Garnish
Director, Data Exploration and Testing
77K Street, Room 4138
Phone: (202) 803-9208
BYOD: (410) 812-3332

From: Freemon, Robert [<mailto:rfreemon@howardcountymd.gov>]
Sent: Wednesday, November 16, 2016 12:15 PM
To: Garnish JC
Subject: RE: 6718 Mink Hollow Rd.

Hey John,

Typically with large additions like this we like to establish a Sewage Disposal Area for future septic repairs if there is not one currently designated via a Perc Cert. However if you are stating there is no plumbing or conditioned living space being constructed in this detached garage you could ask for a waiver to the Perc Cert requirement. In order to apply for this waiver the Health Dept. needs floor plans of the proposed garage showing no living space or plumbing and a letter addressed to Mike Davis (Deputy Director) with your signature at the bottom. This letter will be used to explain why you are asking for the waiver. Reasons may include: Proposed Garage will not have conditioned living space or plumbing constructed within it; Septic System is currently not failing; The Proposed Garage is within the 100'ft well arch (FYI Space that cannot be used for Septic). You can either email both the floor plans and letter to me or you can drop them off at our office. If you have any more questions let me know. Thanks.

Robert Freemon
Howard County Health Department
8930 Stanford Blvd. Columbia, MD 21045
Well and Septic Program
Phone: 410-313-6357
Email: rfreemon@howardcountymd.gov
<https://www.howardcountymd.gov/Departments/Health/Environmental-Health/Well-and-Septic>

From: Garnish JC [<mailto:JC.Garnish@irs.gov>]
Sent: Monday, November 14, 2016 5:15 PM
To: Freemon, Robert
Subject: RE: 6718 Mink Hollow Rd.

However, it is not an addition. It is a separate structure not attached to the house.

J.C. Garnish
Payment Card Project Director,
Office of Compliance Analytics
Phone/VMS: (202) 317-3768
BYOD: (410) 812-3332

From: Freemon, Robert
Sent: Monday, November 14, 2016 12:29:36 PM
To: Garnish JC
Subject: RE: 6718 Mink Hollow Rd.

Hey John,

In the Howard County Regulations Sec. 3.805 (Page,3) Perc Certs are required if a proposed addition is over 250sqft and is a garage. This building permit is for a proposed garage that is over 250sqft. According to our records there is no Perc Cert for this lot.

Robert Freemon
Howard County Health Department
8930 Stanford Blvd. Columbia, MD 21045
Well and Septic Program
Phone: 410-313-6357
Email: rfreemon@howardcountymd.gov
<https://www.howardcountymd.gov/Departments/Health/Environmental-Health/Well-and-Septic>

From: Garnish JC [<mailto:JC.Garnish@irs.gov>]
Sent: Wednesday, November 09, 2016 5:09 PM
To: Freemon, Robert
Subject: RE: 6718 Mink Hollow Rd.

Robert,

I am a little confused. You need a perc plan for a detached garage with no plumbing?

Thanks,

J.C. Garnish
Director, Data Exploration and Testing
Main IR 2322
Phone: (202) 317-3768
BYOD: (410) 812-3332

From: Freemon, Robert [<mailto:rfreemon@howardcountymd.gov>]
Sent: Wednesday, November 09, 2016 4:03 PM
To: Garnish JC
Subject: 6718 Mink Hollow Rd.

Hi John,

I have reviewed the building permit B16004604 and have attached my comments. If you have any questions please email them to me.

Robert Freemon
Howard County Health Department



Bureau of Environmental Health

8930 Stanford Boulevard, Columbia, MD 21045

Main: 410-313-2640 | Fax: 410-313-2648

TDD 410-313-2323 | Toll Free 1-866-313-6300

www.hchealth.org

Facebook: www.facebook.com/hocohealth

Twitter: [HowardCoHealthDep](https://twitter.com/HowardCoHealthDep)

Maura J. Rossman, M.D., Health Officer

MEMORANDUM

TO: John C. Garnish
6718 Mink Hollow Rd.
Highland, MD 20777

FROM: Robert Freemon *RF*
Well & Septic Program

RE: 6718 Mink Hollow Rd.
Highland, MD 20777
"Before BP Approval"

DATE: 11/9/16

I have reviewed the Building Permit B16004604 and before I can approve this permit the following requirements must be met.

- Floor plans of the existing house and the proposed addition must to be sent to the Health Dept.
- A Percolation Certification Plan must be approved by the Health Dept. The Perc Cert plan designates a Sewage Disposal Area (SDA) for the initial system and two replacements. The fee for this is \$506 for the Perc Test Application, Testing and Plan review. See the attached fact sheet regarding this process.
- The floor plans along with the Percolation Certification will be used to determine if the existing septic system is adequate for the proposed addition. If the system is determined to be inadequate, an upgrade will be required which would include a Best Available Technology Unit (BAT Unit). If needed, a BAT plan must be submitted and approved and the upgrade must be installed prior to Health approval of the building permit. See the attached fact sheet regarding the BAT plan.
- A Revised Site Plan must be drawn to scale showing all well and septic system components. This includes the well, well lines, septic lines, septic tank, trenches and sewage disposal area (SDA). This Revised Site Plan must be submitted to the Dept. of Inspections, Licenses, and Permits.