

APPLICATION

FOR PERCOLATION TESTING AND SITE EVALUATION

TEST DATE(S) _____ TEST TIME _____

AP 528887
DATE 4/9/03

AGENCY REVIEW: _____

DO NOT WRITE ABOVE THIS LINE

I HEREBY APPLY FOR THE NECESSARY TESTING/EVALUATION PRIOR TO ISSUANCE OF SEWAGE DISPOSAL SYSTEM PERMIT(S) TO:

CHECK AS NEEDED:

- CONSTRUCT NEW SEPTIC SYSTEM(S)
- REPAIR/ADD TO AN EXISTING SEPTIC SYSTEM
- REPLACE AN EXISTING SEPTIC SYSTEM

CHECK AS NEEDED:

- NEW STRUCTURE(S)
- ADDITION TO AN EXISTING STRUCTURE
- REPLACE AN EXISTING STRUCTURE

CHECK ONE:

- CREATE NEW LOT(S)
- BUILD ON AN EXISTING LOT IN A SUBDIVISION
- BUILD ON AN EXISTING PARCEL OF RECORD

IS THE PROPERTY WITHIN 2500' OF ANY RESERVOIR?

- YES
- NO

THE TYPE OF STRUCTURE IS:

- RESIDENTIAL WITH unknown PROPOSED BEDROOMS IN THE COMPLETED STRUCTURE (NOTE **UNKNOWN** IF APPROPRIATE)
- COMMERCIAL (PROVIDE DETAIL OF NUMBERS AND TYPES OF EMPLOYEES/ CUSTOMERS ON ACCOMPANYING PLAN)
- INSTITUTIONAL/GOVERNMENT (PROVIDE DETAIL OF NUMBERS AND TYPES OF EMPLOYEES/USERS ON ACCOMPANYING PLAN)

PROPERTY OWNER(S) Albert and Virginia Spokes

DAYTIME PHONE _____ CELL _____ FAX _____

MAILING ADDRESS 5610 Chamblis Drive Clarksville MD 21029
STREET CITY/TOWN STATE ZIP

APPLICANT Josh Bixler (Benchmark)

DAYTIME PHONE 443-631-5900 CELL _____ FAX 443-546-4921

MAILING ADDRESS P.O. Box 351 Clarksville MD 21029
STREET CITY/TOWN STATE ZIP

APPLICANT'S ROLE: DEVELOPER BUYER REALTOR CONSULTANT

PROPERTY LOCATION
SUBDIVISION/PROPERTY NAME Glen Mary Est. LOT NO. 6

PROPERTY ADDRESS 5610 Chamblis Drive
STREET TOWN/POST OFFICE


TAX MAP PAGE(S) 34 GRID 5 PARCEL(S) 15 PROPOSED LOT SIZE 99.11 ac

AS APPLICANT, I UNDERSTAND THE FOLLOWING: THE SYSTEM INSTALLED SUBSEQUENT TO THIS APPLICATION IS ACCEPTABLE ONLY UNTIL PUBLIC SEWERAGE IS AVAILABLE. THIS APPLICATION IS COMPLETE WHEN ALL APPLICABLE FEES AND A SUITABLE SITE PLAN HAVE BEEN RECEIVED. I ACCEPT THE RESPONSIBILITY FOR COMPLIANCE WITH ALL M.O.S.H.A. AND "MISS UTILITY" REQUIREMENTS. APPROVAL IS BASED UPON SATISFACTORY REVIEW OF A PERC CERTIFICATION PLAN. TEST RESULTS WILL BE MAILED TO APPLICANT.

SIGNATURE OF APPLICANT

Amend septic easement for 1st Residence

5610 Chabliss

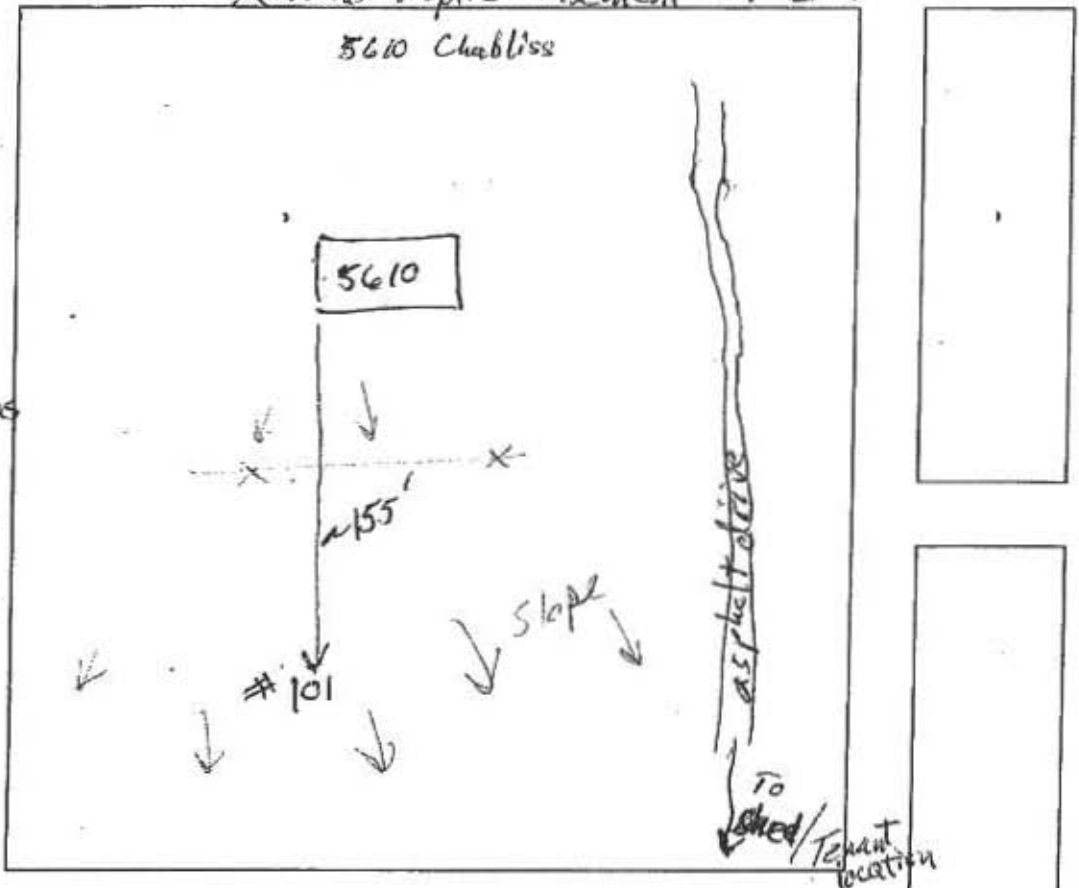

AP _____

(101)

0.5' dk brns / common mica

3' red-brn scl

4.5' red-brns / f3d grey scl inclusions / common mica

8' red-brns / micaceous

10' brn chls / micaceous

11.5' brn fls / micaceous / moist / R

DATE	TEST #	DEPTH	START	BREAK 1" DROP	STOP 2" DROP	TIME OF 2ND INCH	P/F/H
4/16/08	101	11.5'	Visual		4.5' to 7.5' est. perc.	2-10 minutes	P

REMARKS add to SDA.

SANITARIAN RR BACKHOE Todd OTHERS Israel

TEST HOLES USED IN SDA _____ AVG. PERC TIME _____ SQ. FT/BR _____

TRENCH WIDTH _____ INLET DEPTH 4' MAX. BOT DEPTH 7.5' EFFECTIVE S/W 3' max.

APPLICATION

SEWAGE DISPOSAL TESTING

STATE OF MARYLAND - DEPARTMENT OF HEALTH AND MENTAL HYGIENE

HOWARD COUNTY HEALTH DEPARTMENT
ENVIRONMENTAL HEALTH SERVICES

P. O. BOX 476 ELLICOTT CITY, MARYLAND 21043
TELEPHONE: 992-2330

A 32532

P _____

DISTRICT 5th

DATE 3-2-83

TO: THE COUNTY HEALTH OFFICER
ELLICOTT CITY, MARYLAND

I, HEREBY, APPLY FOR THE NECESSARY TEST IN ORDER TO CONSTRUCT (OR RECONSTRUCT) A SEWAGE DISPOSAL SYSTEM.

PROPERTY OWNER E. D. ADAMS, Jr. - & LOUISE H. ADAMS *Albert Spoken
7930 Carter Road
Lynchville, Md*
ADDRESS 5795 TEN DARS RD, CLARKSVILLE PHONE 531-5458549-1561

PROPERTY LOCATION:

SUBDIVISION 120 AC. FARM LOT NO. Site 2
5610
ROAD AND DESCRIPTION CHAMBLISS DRIVE + BROADWATER LANE
SITE 2 - BEHIND TENANT HOUSE

SIZE OF LOT _____ TYPE BLDG. 3-4 B.RS
(NUMBER OF BEDROOMS)

THE SYSTEM INSTALLED UNDER THIS APPLICATION IS ACCEPTABLE ONLY UNTIL PUBLIC FACILITIES BECOME AVAILABLE. I FULLY UNDERSTAND THE FEE CONNECTED WITH THE FILING OF THIS PERC TEST APPLICATION IS NON-REFUNDABLE UNDER ANY CIRCUMSTANCES. I ALSO AGREE TO COMPLY WITH ALL M.O.S.H.A. REQUIREMENTS IN TESTING THIS LOT.

Louis H. Adams
(SIGNATURE OF APPLICANT)

APPROVED BY _____ FOR _____ DATE _____

REJECTED BY _____ FOR _____ DATE _____

HOLD PENDING FURTHER TESTS C. Williams DATE 3-18-83


REASONS FOR REJECTION OR HOLDING NEED CERTIFIED HOLES

see A30843 for tenant house

THIS IS NOT A PERMIT

BLDG. PERMIT SIGNED
AND RETURNED 7/22/83
Serial # 54756 SF10

SOIL PROFILE

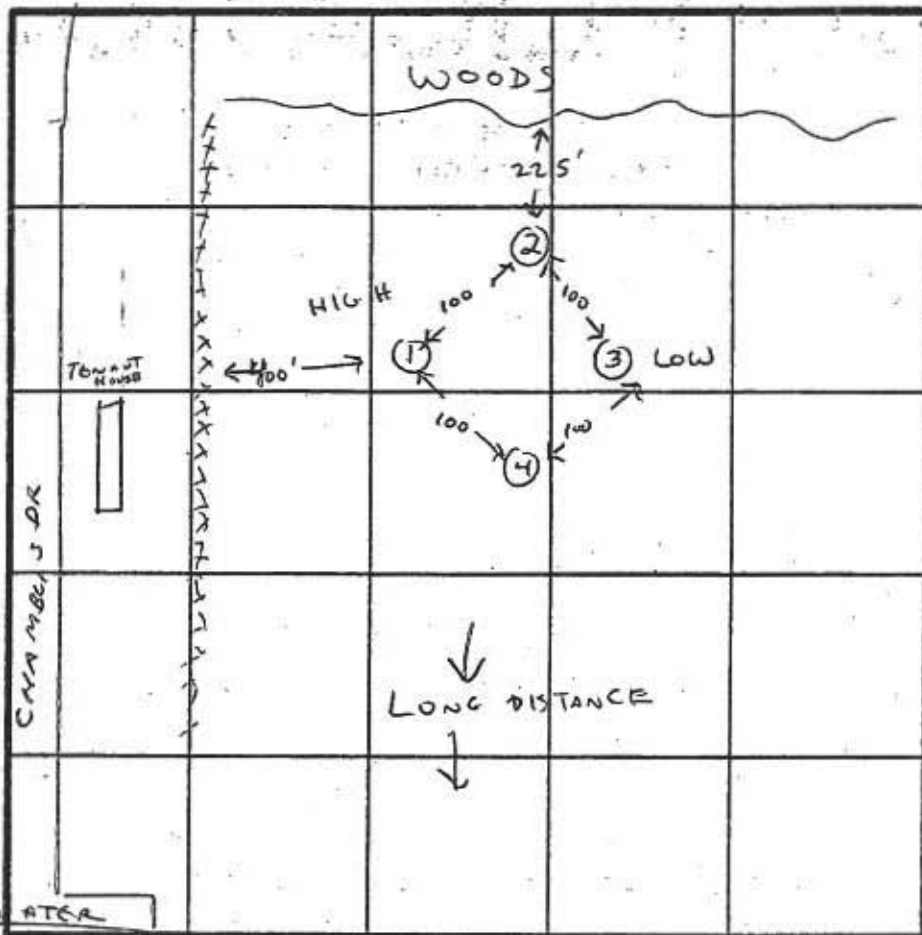

INDICATE NORTH - NAME ADJOINING ROADWAY AS BASE LINE.

ROUTE 32

DATE	TEST NO.	DEPTH	PRE-WET		TEST - 1" DROP		TIME
			START	STOP	START	STOP	
3-17-83	1	4	1:33	1:50	1:50	2:16	20 MIN
		8	1:33	1:37	1:37	1:42	5 MIN
		12	CLAY TO 4' THEN MICA + CLAY MIX				
3-17-83	2	4	1:24	1:25	1:25	1:28	3 MIN
		8	1:23	1:26	1:26	1:30	4 MIN
		12	CLAY TO 4' THEN MICA + CLAY MIX				
3-17-83	3	4	1:13	1:21	1:21	1:26	15 MIN
		8	1:13	1:17	1:17	1:21	4 MIN
		12	CLAY TO 4' THEN MICA + CLAY MIX				
3-17-83	4	4	1:11	1:15	1:15	1:27	12 MIN
		8	1:10	1:13	1:13	1:17	4 MIN
		12	CLAY TO 4' THEN MICA + CLAY MIX				

REMARKS _____


TYPE OF SOIL _____

TESTED BY C. Williams

ALSO PRESENT

HELMAN & JR SIRC
ALBERT SPOKES

This is Health Dept.
only copy of Perc Cert

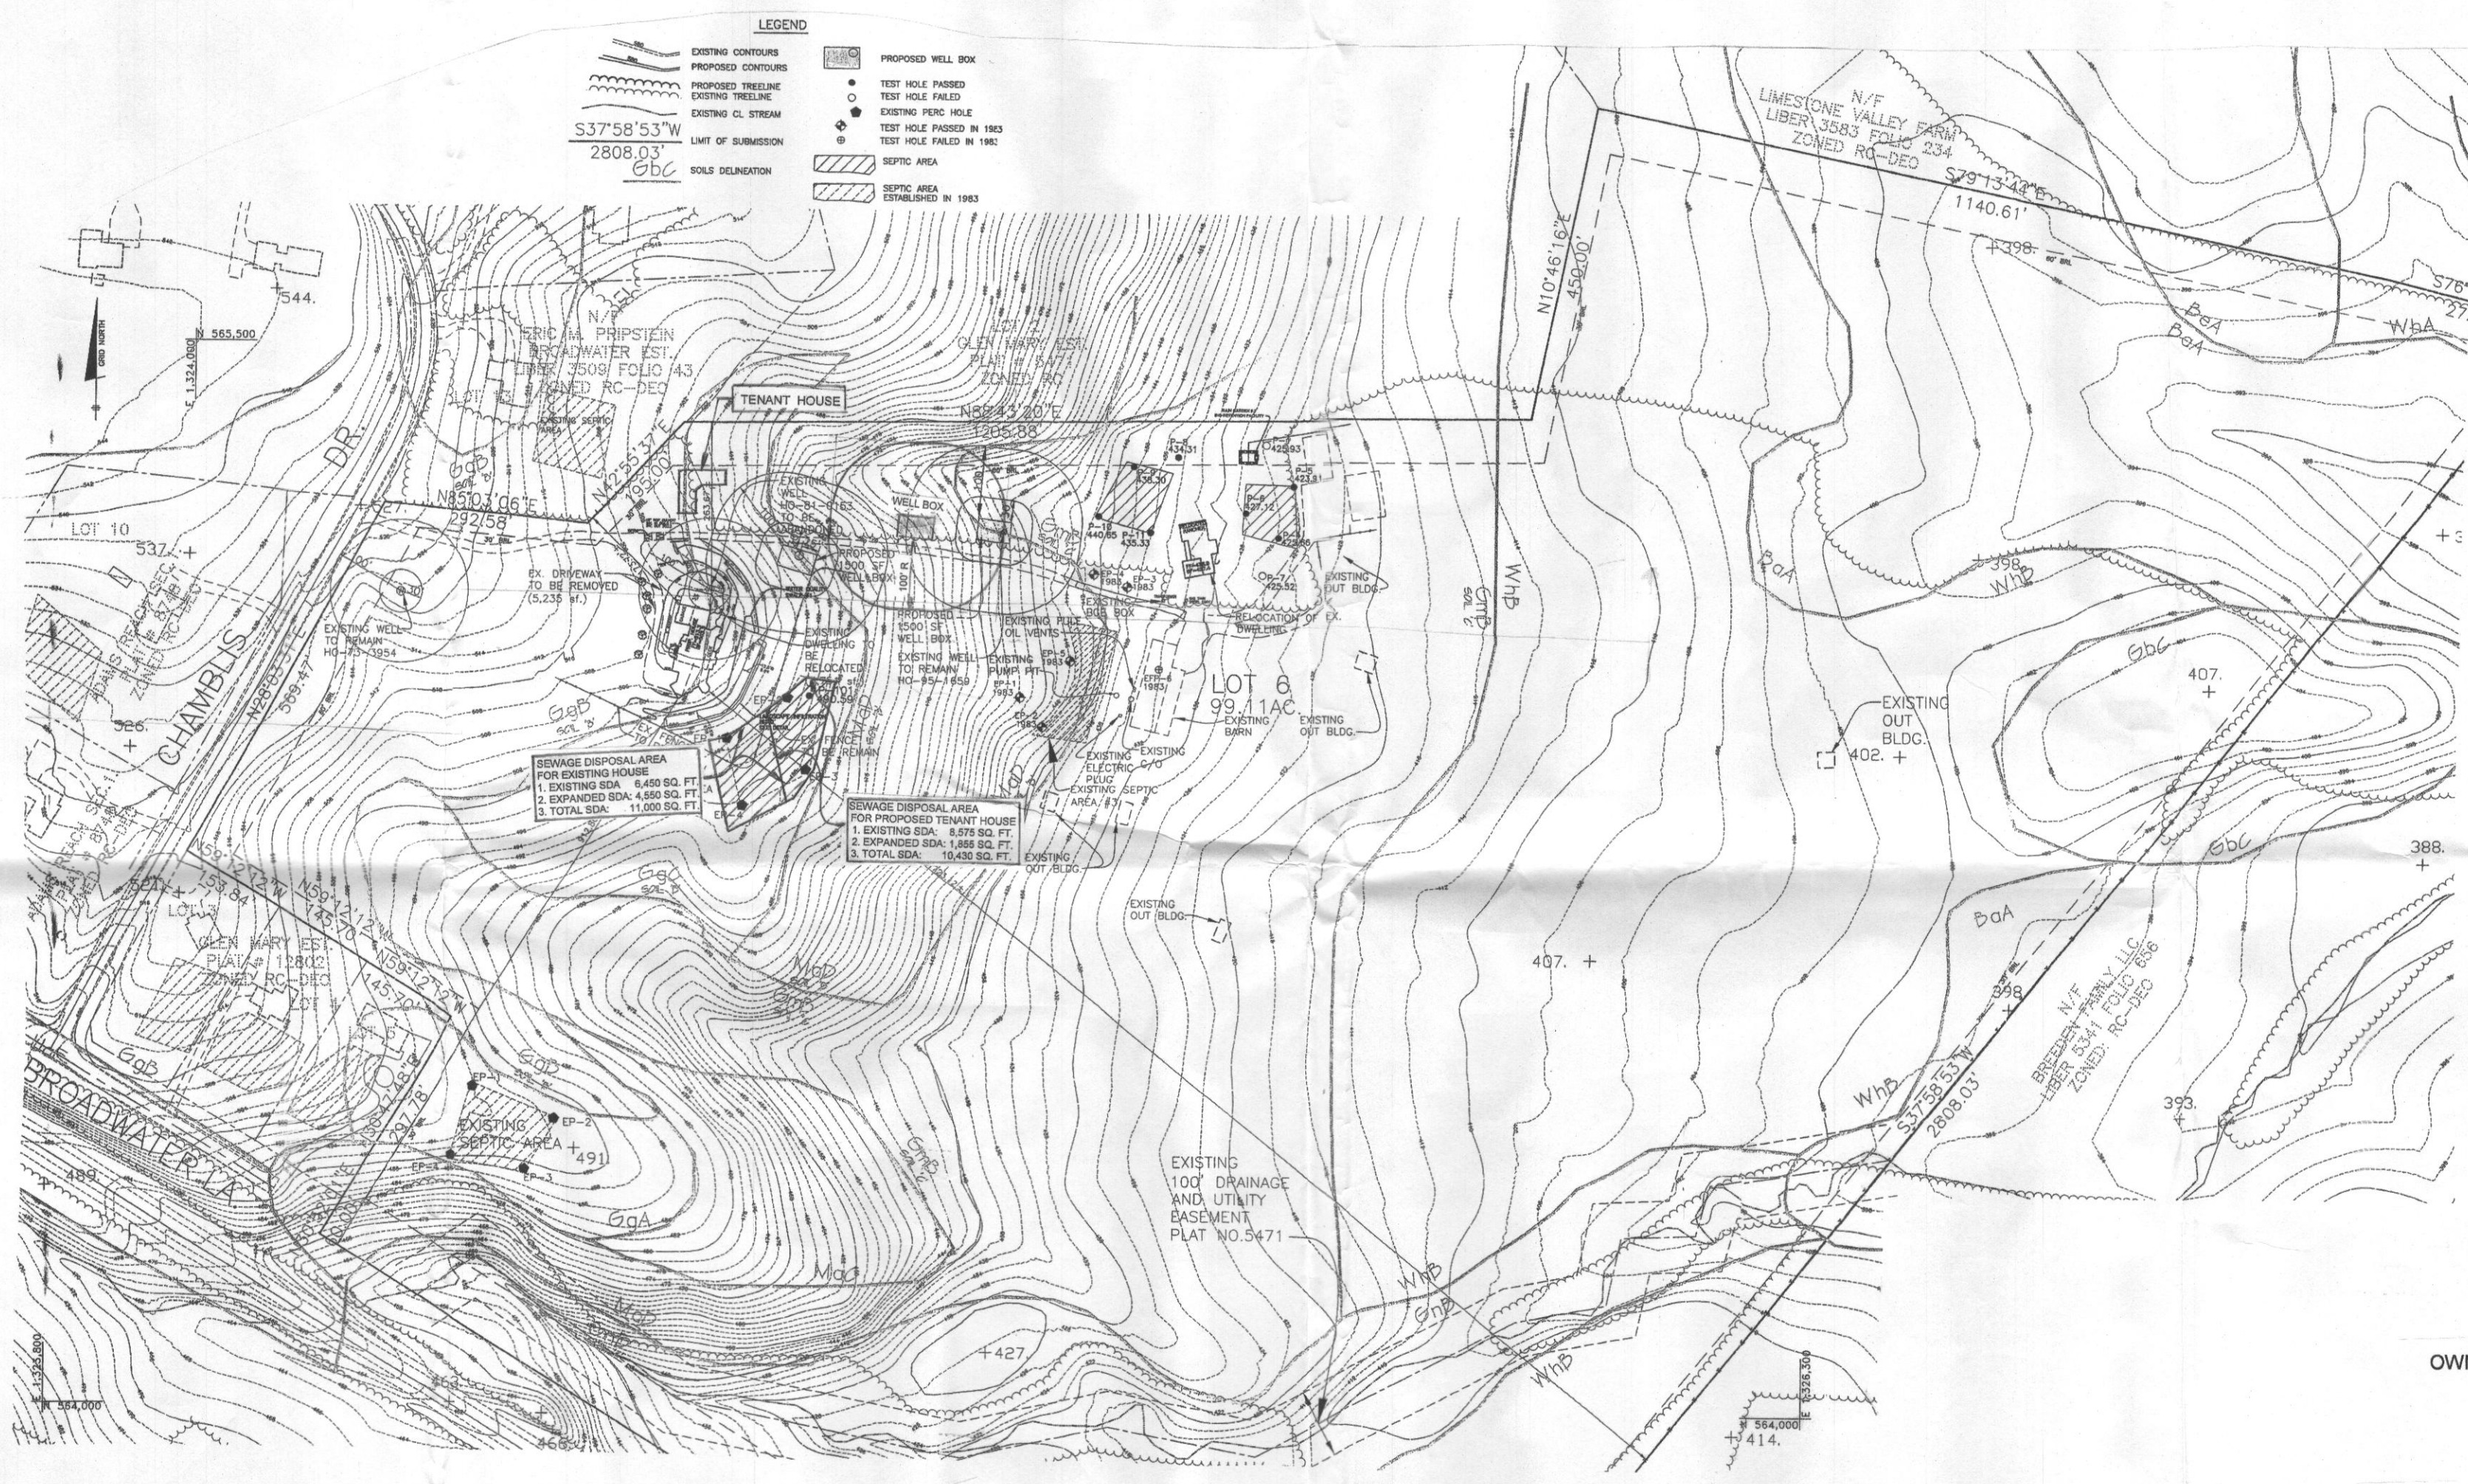

OVERALL PLAN
SCALE: 1" = 200'

NOTE: THE PLAN SHOWN HAS BEEN OBTAINED FROM THE HOWARD COUNTY HEALTH DEPARTMENTS PUBLIC RECORDS AND ENTITLED AS "REVISED PERCOLATION CERTIFICATION PLAN" SIGNED MAY 24, 2010.

OWNER: GEORGE L. DOETSCH
5610 CHAMBLIS DRIVE
CLARKSVILLE, MD 21029
410.309.1200

BUILDER: MUELLER HOMES INC.
7520 MAIN STREET
SUITE 201
SYKESVILLE, MD 21784
410.549.4444

REVISED PERCOLATION CERTIFICATION PLAN
GLEN MARY ESTATES
LOT 6
TENANT HOUSE
(B 16002797)
TAX MAP 34 GRID 5 PARCEL 15
TAX ACCOUNT #05-341140
5TH ELECTION DISTRICT HOWARD COUNTY, MD
DATE: 8/2016 SCALE: AS SHOWN
SHEET 2 OF 2

APPROVED FOR PRIVATE WATER AND SEWERAGE
HOWARD COUNTY HEALTH DEPARTMENT

Michael J. Clark 9/19/16
HOWARD COUNTY HEALTH OFFICER DATE

PERCOLATION CERTIFICATION
I CERTIFY THAT THE INFORMATION SHOWN HEREON IS BASED ON FIELD WORK PERFORMED BY ME OR UNDER MY DIRECT SUPERVISION AND IS CORRECT TO THE BEST OF MY KNOWLEDGE AND BELIEF.

Bruce D. Burton 9/19/16
BRUCE D. BURTON PE DATE
MD. REG. NO. 19184



I HEREBY CERTIFY THAT THESE DOCUMENTS WERE PREPARED OR APPROVED BY ME, AND THAT I AM A DULY LICENSED PROFESSIONAL ENGINEER UNDER THE LAWS OF THE STATE OF MARYLAND, LICENSE NO. 19184, EXPIRATION DATE: 6/30/17.

Bruce D. Burton 9/19/16
BRUCE D. BURTON DATE

LDE Inc.
Engineers • Surveyors • Planners
Historic Carriage House • 7520 Main Street • Suite 203 • Sykesville, Maryland • 21784
(410)795-6391 • (410)795-6392 • FAX(410)795-9540 • www.Landsurveyormd.com