

APPLICATION

PERCOLATION TESTING

PREVIOUS COMMENT - ADDITIONAL INFO NEEDED, A 56580
EXISTING WELL WAS DRILLED P _____
TO SERVE ANOTHER LOT, CLOSER
TO SEPTIC AREA THAN SHOWN ON DISTRICT _____

HOWARD COUNTY HEALTH DEPARTMENT
BUREAU OF ENVIRONMENTAL HEALTH
3525-H ELLICOTT MILLS DRIVE/ELLICOTT CITY, MARYLAND 21043
TELEPHONE: 313-2640

TEST PLAN, APPLICANT INDICATES DATE 4-25-96
THE WELL IS NO LONGER NEEDED
TO SERVE THIS PURPOSE.

TO: THE COUNTY HEALTH OFFICER
ELLICOTT CITY, MARYLAND

APPLICANT ADVISED TO FIELD LOCATE WELL AND PROVIDE
WRITTEN EXPLANATION THAT WELL IS NO LONGER NEEDED TO
SERVE OTHER PROPERTY. 4/29/96 (CW)

I HEREBY APPLY FOR THE NECESSARY TEST PRIOR TO APPLICATION FOR PERMIT TO CONSTRUCT (OR RECONSTRUCT) A SEWAGE DISPOSAL SYSTEM.

PROPERTY OWNER DONALD R. REOWER JR

ADDRESS 10805 HICKORY RIDGE RD PHONE 740-2100
COLUMBIA MD 21044

AGENT OR PROSPECTIVE BUYER _____
ADDRESS _____ PHONE _____

PROPERTY LOCATION:

SUBDIVISION BEAUFORT PARK BLOCK B LOT NO. LOT 3 (Retest)

ROAD AND DESCRIPTION NORTH SIDE OF RESERVOIR ROAD

TAX MAP 45 PARCEL # 46 G, 12

SIZE OF LOT ONE ACRE TYPE BLDG. SFD
(SINGLE FAMILY DWELLING OR COMMERCIAL)

THE SYSTEM INSTALLED UNDER THIS APPLICATION IS ACCEPTABLE ONLY UNTIL PUBLIC FACILITIES BECOME AVAILABLE. I FULLY UNDERSTAND THE
FEE CONNECTED WITH THE FILING OF THIS PERC TEST APPLICATION IS NON-REFUNDABLE UNDER ANY CIRCUMSTANCES. I ALSO AGREE TO
COMPLY WITH ALL M.O.S.H.A. REQUIREMENTS IN TESTING THIS LOT. Robert Ketchum AGENT
(SIGNATURE OF APPLICANT)

APPROVED BY _____ FOR _____ DATE _____

DISAPPROVED BY _____ FOR _____ DATE _____

HOLD PENDING FURTHER TESTS _____

REASONS FOR REJECTION OR HOLDING _____

PERCOLATION TEST PLAT/PRELIMINARY PLAT - TITLE OR I.D. # _____ DATE _____

SITE DEVELOPMENT PLAN/FINAL PLAT - TITLE OR I.D. # _____ DATE _____

THIS IS NOT A PERMIT

A56580

COUNTY #

SOIL PROFILE


A

0'
bright orange red silclm
5.0
lgt orange brown silsalm
100% very decayed Saprolite

SOIL PROFILE

0'

Empty soil profile box.

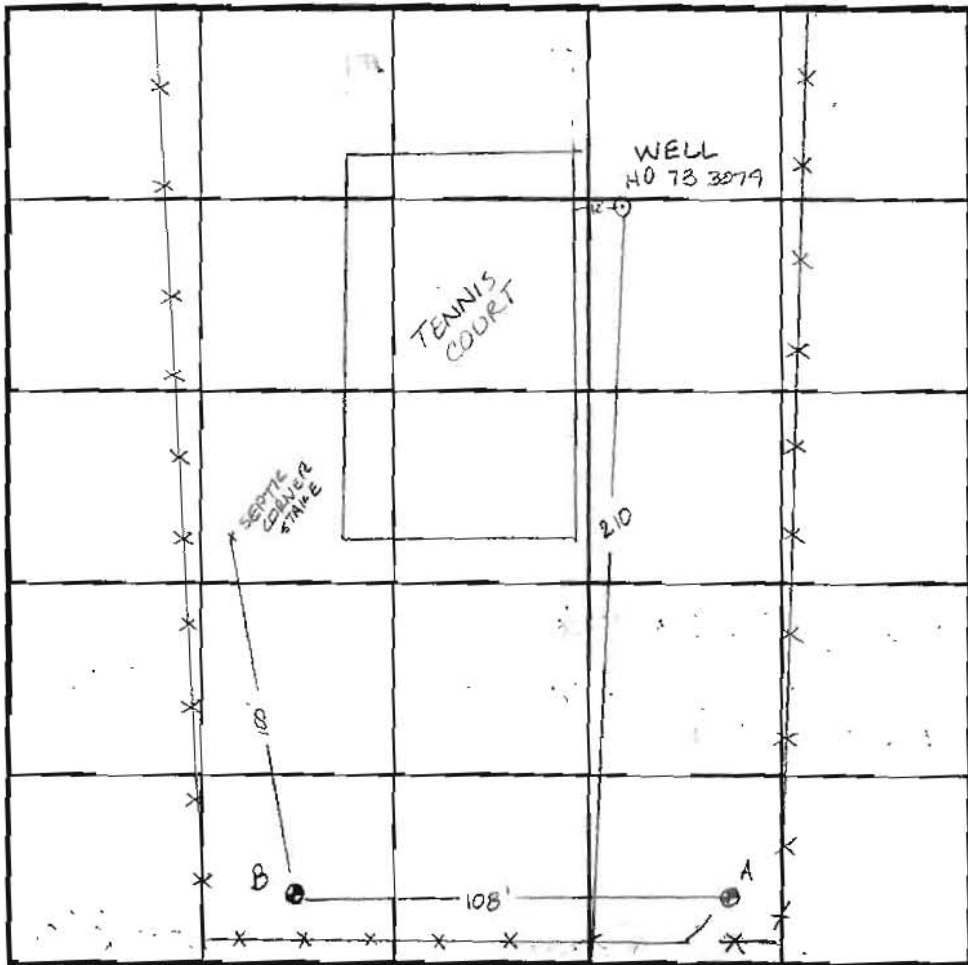

INDICATE NORTH - NAME ADJOINING ROADWAY AS BASE LINE.

1/4 of Reservoir Road

B
lgt orange silclm
4.5
lgt yellow red silsalm
6.0
dark red brown silm
100% Saprolite
12.0

DATE	TEST NO.	DEPTH	PRE-WET		TEST - 1" DROP		TIME
			START	STOP	START	STOP	
6-20-96	A	5.0 / 10.5	2:00	2:02	2:02	2:07	5min
	B	4.5 / 12.0	2:07	2:11	2:11	2:15	4min


REMARKS Actual well

TYPE OF SOIL

TESTED BY Amy McMillen ALSO PRESENT Jared

TRENCH DESIGN DATA: AVERAGE PERCOLATION TIME 4min TRENCH WIDTH 3.0

INLET DEPTH 4.0 MAXIMUM BOTTOM DEPTH 6.0 SQ. FT/BEDROOM 180 ft²

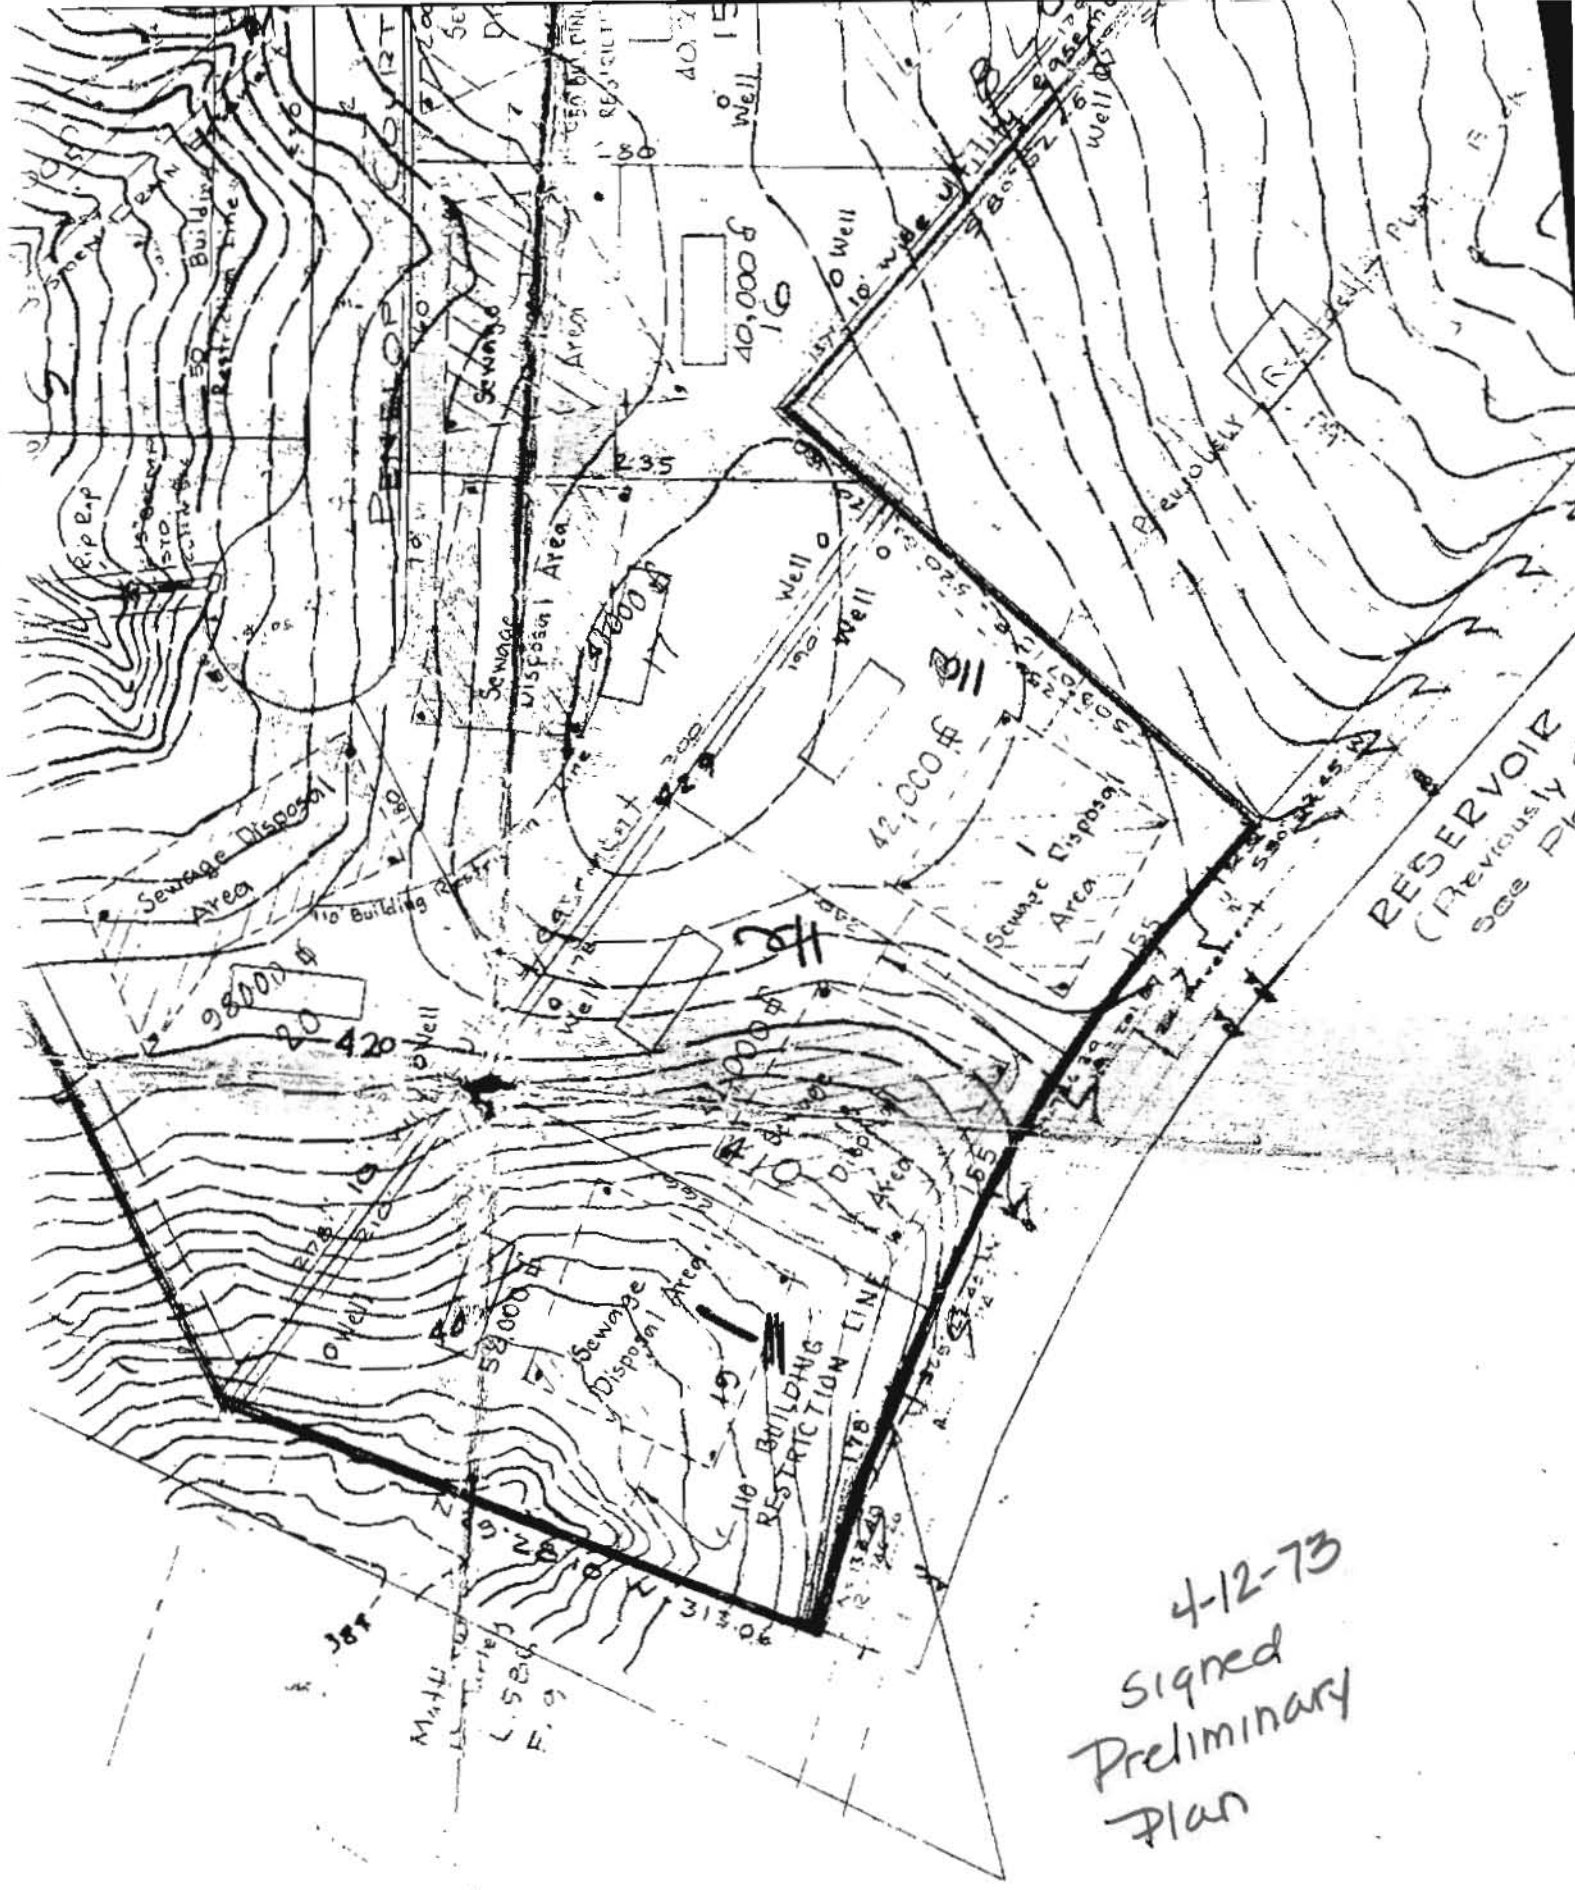

RESERVOIR
(Previously
see Pk

4-12-73
Signed
Preliminary
Plan