

HOWARD COUNTY
PERMIT APPLICATION

PERMIT NUMBER
B08001265

Building Address 12050 Old Frederick Rd.
Marriottsville MD 21104
Suite/Apt. #: _____ SDP/WP/Petition #: _____
Census Tract _____ Subdivision _____
Section _____ Area _____ Lot _____
Tax Map _____ Parcel _____ Grid _____
Zoning _____ Map Coordinates _____ Lot size _____

Property Owner's Name Hebner
Address 12050 Old Frederick Rd.
City Marriottsville State MD Zip Code 21104
Phone 410 489 9908 Phone _____
Applicant's Name & Mailing Address, (if other than stated hereon): _____
Phone _____ Fax _____

Existing Use _____
Proposed Use Living Room Extension
Estimated Construction Cost \$ 20,000.00
Description of Work 15' x 12' Living Room Extension

Contractor Company Highpoint Home Improvement Inc.
Contact Person Josh Remmel
Address 900 Henryton Rd.
City Marriottsville State MD Zip Code 21104
License No. 123972
Phone 410 489 7226 Fax _____

Occupant or Tenant John & Sally Hebner
Contact Name _____
Address 12050 Old Frederick Rd.
City Marriottsville State MD Zip Code 21104
Phone 410 489 9908 Fax _____

Engineer or Architect Company _____
Contact Person _____
Address _____
City _____ State _____ Zip Code _____
Phone _____ Fax _____

BUILDING DESCRIPTION - COMMERCIAL

BUILDING DESCRIPTION - RESIDENTIAL

Building Characteristics	Utilities
Height: _____	Water Supply: _____ Public _____ Private _____
No. of stories: _____	Sewage Disposal: _____ Public _____ Private _____
Gross area, sq. ft. per floor: _____	Electric Yes <input type="checkbox"/> No <input type="checkbox"/>
Use group: _____	Gas Yes <input type="checkbox"/> No <input type="checkbox"/>
Construction type: _____ Reinforced Concrete _____ Structural Steel _____ Masonry _____ Wood Frame _____ State Certified Modular _____	Heating System: _____ Electric <input type="checkbox"/> Oil <input type="checkbox"/> Natural Gas <input type="checkbox"/> Propane Gas <input type="checkbox"/>
	Sprinkler system: N/A <input type="checkbox"/> Full _____ Partial _____ Other Suppression _____ # of Heads _____

Building Characteristics	Utilities
SF Dwelling <input type="checkbox"/> SF Townhouse <input type="checkbox"/> Depth _____ Width _____	Water Supply: _____ Public <input checked="" type="checkbox"/> Private _____
1st floor: _____	Sewage Disposal: _____ Public _____ Private <input checked="" type="checkbox"/>
2nd floor: _____	Electric Yes <input checked="" type="checkbox"/> No <input type="checkbox"/>
Basement: _____	Gas Yes <input type="checkbox"/> No <input checked="" type="checkbox"/>
Finished Basement <input type="checkbox"/> Unfinished Basement <input type="checkbox"/>	Heating System: _____ Electric <input type="checkbox"/> Oil <input checked="" type="checkbox"/> Natural Gas <input type="checkbox"/> Propane Gas <input type="checkbox"/>
Crawl space <input checked="" type="checkbox"/> Slab on Grade <input type="checkbox"/>	Sprinkler system: N/A <input type="checkbox"/> NFPA #13D _____ NFPA #13R _____ Other: _____
No. of Bedrooms <u>4</u>	
Height: _____	
Multi-family dwellings: _____	
No. of efficiency units: _____	
No. of 1 BR units: _____	
No. of 2 BR units: _____	
No. of 3 BR units: _____	
Other Structure: _____	
Dimensions: _____	
Footings: _____	
Roof Height: _____	
State Certified Modular _____	
Manufactured Home _____	

THE UNDERSIGNED HEREBY CERTIFIES AND AGREES AS FOLLOWS: (1) THAT HE/SHE IS AUTHORIZED TO MAKE THIS APPLICATION; (2) THAT THE INFORMATION IS CORRECT; (3) THAT HE/SHE WILL COMPLY WITH ALL REGULATIONS OF HOWARD COUNTY WHICH ARE APPLICABLE THERETO; (4) THAT HE/SHE WILL PERFORM NO WORK ON THE ABOVE REFERENCED PROPERTY NOT SPECIFICALLY DESCRIBED IN THIS APPLICATION; (5) THAT HE/SHE GRANTS COUNTY OFFICIALS THE RIGHT TO ENTER ONTO THIS PROPERTY FOR THE PURPOSE OF INSPECTING THE WORK PERMITTED AND POSTING NOTICES.


JSR
Applicant's Signature
President/Highpoint Home Imp.
Title/Company

Joshua S. Remmel
Print Name
4/23/08
Date

Checks payable to: **DIRECTOR OF FINANCE OF HOWARD COUNTY**
** PLEASE WRITE NEATLY AND LEGIBLY. **
FOR OFFICE USE ONLY.


AGENCY	DATE	SIGNATURE APPROVAL	DPZ SETBACK INFORMATION	PROPERTY ID#
Land Development, DPZ			Front: _____	Filing fee \$ _____
State Highways			Rear: _____	Permit fee \$ _____
Building Official			Side: _____	Excise tax \$ _____
Dev. Engineering, DPZ			Side St.: _____	Add'l per. fee \$ _____
Health <u>4/23/08</u>		<u>JSR</u>	All minimum setbacks met?	TOTAL FEES \$ _____
Fire Protection			YES <input type="checkbox"/> NO <input type="checkbox"/>	Sub-total paid \$ _____
Is Sediment Control approval required prior to issuance?			Is Entrance Permit required?	Balance due \$ _____
YES <input type="checkbox"/> NO <input type="checkbox"/>			YES <input type="checkbox"/> NO <input type="checkbox"/>	Check # _____
CONTINGENCY CONSTRUCTION START: <input type="checkbox"/>			Historic District?	Validation # _____
ONE STOP SHOP: <input type="checkbox"/>			YES <input type="checkbox"/> NO <input type="checkbox"/>	
Distribution of Copies- White: Building Official			Lot Coverage for NewTown Zone _____	
Green: LDD, DPZ			SDP/Red-line approval date _____	Accepted by _____
Yellow: DED, DPZ				
Pink: Health				
Gold: SHA				

COORDINATE SCHEDULE			CURVE DATA					
NO.	NORTH	EAST	No.	A	Radius'	Length	Tangent	Chord Bearing & Distance
1	10097.903	3117.466	7-11	15°-00'-00"	429.00	379.15	157.64	S89°57'11"W 372.06'
2	10363.467	4998.991						
3	10808.763	5054.194						
4	11230.357	5256.180						
5	11535.418	5406.727						
6	11228.881	5757.206						
7	10075.150	5406.449						
8	9999.760	5460.742						
9	10368.654	5201.61						
10	11058.708	5168.567						
11	10080.898	5465.892						
12	10002.115	5106.212						
13	10073.025	5114.891						
14	10945.043	5447.852						
15	1007.987	5157.692						
16	10021.919	5179.257						

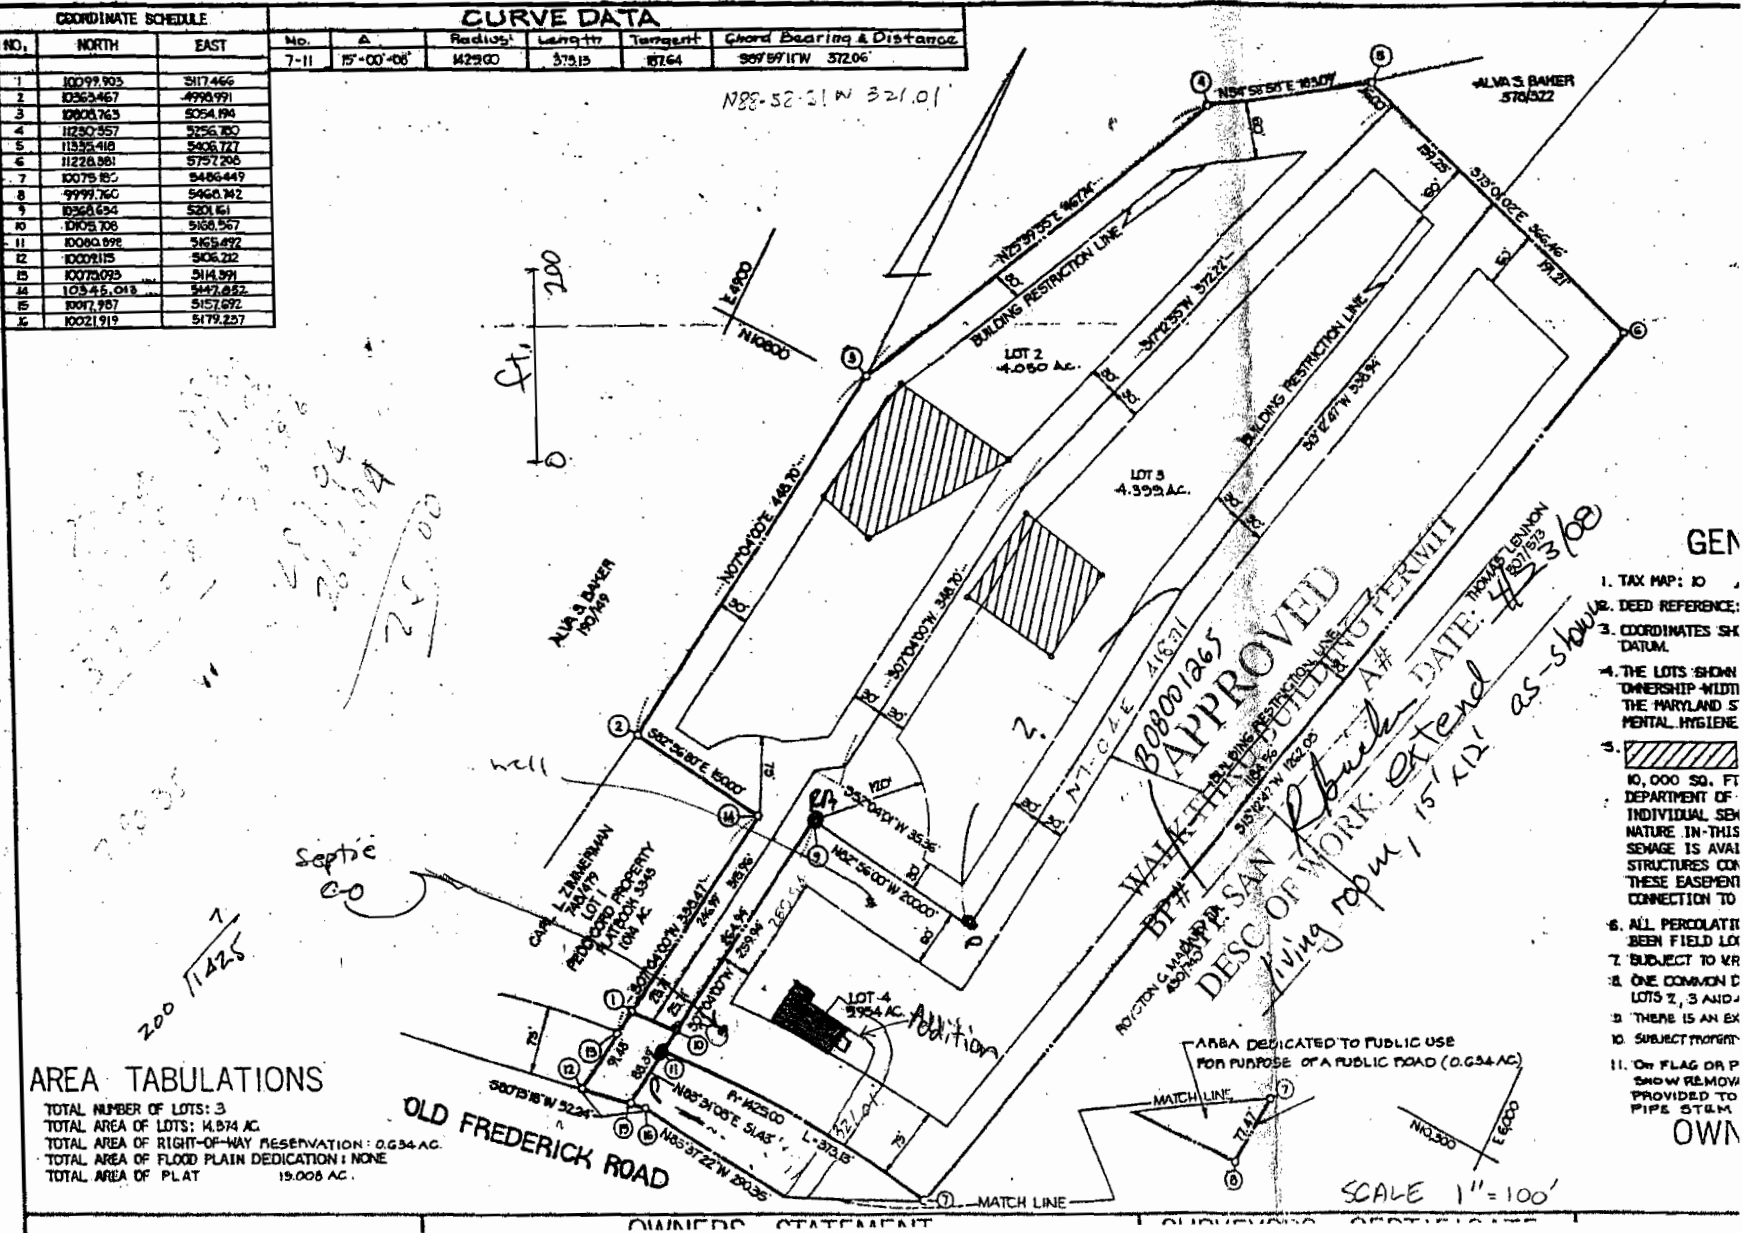

AREA TABULATIONS

TOTAL NUMBER OF LOTS: 3
 TOTAL AREA OF LOTS: 14.874 AC.
 TOTAL AREA OF RIGHT-OF-WAY RESERVATION: 0.634 AC.
 TOTAL AREA OF FLOOD PLAIN DEDICATION: NONE
 TOTAL AREA OF PLAT: 19.008 AC.

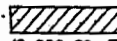- GEN**
- TAX MAP: 10
 - DEED REFERENCE:
 - COORDINATES SH DATUM.
 - THE LOTS SHOWN OWNERSHIP WITHIN THE MARYLAND 5 MENTAL HYGIENE
 - 

10,000 SQ. FT DEPARTMENT OF INDIVIDUAL SEN NATURE IN THIS SEWAGE IS AVAL STRUCTURES ON THESE EASEMENT CONNECTION TO
 - ALL PERCOLATI BEEN FIELD LOI
 - SUBJECT TO KR
 - ONE COMMON D LOTS 2, 3 AND-
 - THERE IS AN EX
 - SUBJECT PROPRIET
 - On FLAG OR P SHOW REMOVI PROVIDED TO PIPE STRM

OWN