

APPLICATION

A 25332

SEWAGE DISPOSAL TESTING

P _____

STATE OF MARYLAND - DEPARTMENT OF HEALTH AND MENTAL HYGIENE

HOWARD COUNTY HEALTH DEPARTMENT
ENVIRONMENTAL HEALTH SERVICES

DISTRICT ✓ 4

P. O. BOX 476, ELLICOTT CITY, MARYLAND 21043
TELEPHONE: 465-5000, EXT. 356

DATE ✓ 3/1/77

5/4/77
9:30 a.m.

TO: THE COUNTY HEALTH OFFICER
ELLICOTT CITY, MARYLAND

I, HEREBY, APPLY FOR THE NECESSARY TEST IN ORDER TO CONSTRUCT (OR RECONSTRUCT) A SEWAGE DISPOSAL SYSTEM.

PROPERTY OWNER ✓ BENJAMIN F. CLEMENTS & DONNIE B.

ADDRESS ✓ P.O. BOX 355 MOUNT AIRY MD 21771 PHONE ✓ 829.2257

PROPERTY LOCATION:

SUBDIVISION ✓ LOT NO. ✓ 1

ROAD AND DESCRIPTION direction ✓ MOUNT AVE - MD ROUTE 27 - 1500' SOUTH OF PENN SHOP ROAD

SIZE OF LOT ✓ ~~2.27~~ 2.27 ACRES TYPE BLDG. ✓ RES - 3 BR
NUMBER OF BEDROOMS

IF NOT SINGLE RESIDENCE DESCRIBE _____

THE SYSTEM INSTALLED UNDER THIS APPLICATION IS ACCEPTABLE ONLY UNTIL PUBLIC FACILITIES BECOME AVAILABLE.

SIGNATURE OF APPLICANT ✓ Donnie B Clements / D/B

APPROVED BY _____ FOR _____ DATE _____
(KIND OF SYSTEM)

REJECTED BY _____ FOR _____ DATE _____
(KIND OF SYSTEM)


HOLD PENDING FURTHER TESTS WW3 DATE 5/25/77

REASONS FOR REJECTION OR HOLDING see attached note, next sheet.

THIS IS NOT A PERMIT

① 0
 ③ 3
 ④ 4
 clay
 loose shaly
 mixed w soil
 Solid
 ② 0
 3
 6
 11
 clay
 loose shale
 loam
 layered shale
 w some soil
 Solid

⑤ 0
 4
 6
 9
 clay
 loamy shale
 vert. shale
 w soil

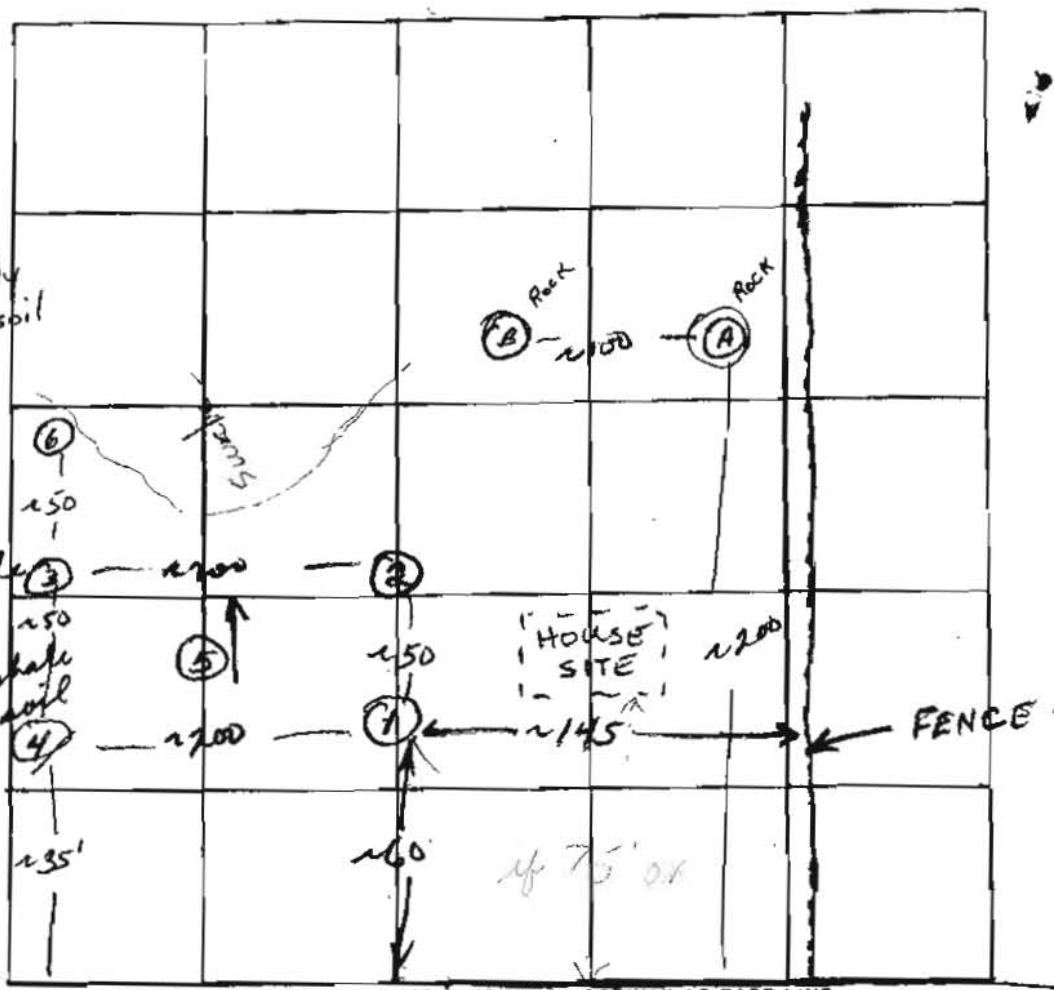


INDICATE NORTH. - NAME ADJOINING ROADWAY AS BASE LINE
RT. 27

DATE	TEST NO.	DEPTH	PRE-WET		TEST - 1" DROP		TIME
			START	STOP	START	STOP	
5/24/77	① A	6'	Solid Rock				
	② B	9'	Solid Rock				
	HIGH	4	11:01	11:02	11:02	11:07	5
	1-A	10 1/2	11:00	11:08	11:03	11:15	12
	2	3 1/2	11:21	11:25	11:25	11:35	10
	2-A	10 1/2	11:17	11:18	11:18	11:21	3
	LOW	3	11:39	11:52	11:52	12:19	26
	3-A	10	11:39	11:40	11:40	11:42	2
	④	3 1/2	11:51	FAILED			
	4-A	9 1/2	11:48	11:56	11:56	12:13	17
	4-B	4 1/2	1:47	1:49	1:49	1:54	5
	5	9	VISUAL; OK				
	6	10'	VISUAL; SIMILAR; GOOD FR.				3 1/2'

REMARKS Drainfield / modified pr. 1-4
 TYPE OF SOIL Loamy shaly
 TESTED BY WWZ ALSO PRESENT: Sink & Co, Clements

5/24/77

Rock hit in rear set of holes as staked. Moved to front of lots to try perc for 2 lots (w/ owner's permission). Front area next to road suitable for drainfield-type system (see perc), but some additional testing needed. Surveyor (or realtor?) showed up on site ~ 12:30 PM; informed Sink and myself of 60' state road R.O.W., probable 100' set-back requirement in addition. If such is the case, the perc we dug at the front of the lots would be VOICES because they would be inaccessible from a substantially lower house site. Rear portions of lots unsuitable for drainfields (rolling, steep, slopes), would have to be DW systems, and rock is encountered there at ~ 7-10'.

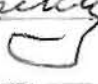Suggest no more testing until we definitely know how far back our house site is. 

WWZ,

APPLICATION

A 25333

SEWAGE DISPOSAL TESTING

P _____

STATE OF MARYLAND - DEPARTMENT OF HEALTH AND MENTAL HYGIENE

HOWARD COUNTY HEALTH DEPARTMENT
ENVIRONMENTAL HEALTH SERVICES
P. O. BOX 476, ELLICOTT CITY, MARYLAND 21043
TELEPHONE: 465-5000, EXT. 356

DISTRICT 4

DATE 3/1/77

5/4/77
9:30 a.m.

TO: THE COUNTY HEALTH OFFICER
ELLICOTT CITY, MARYLAND

I, HEREBY, APPLY FOR THE NECESSARY TEST IN ORDER TO CONSTRUCT (OR RECONSTRUCT) A SEWAGE DISPOSAL SYSTEM.

PROPERTY OWNER BENJAMIN F. CLEMENTE & DOWNIE B.

ADDRESS PO Box 355, Mt. Airy Md. 21771 PHONE 829. 2257

PROPERTY LOCATION:

SUBDIVISION _____ LOT NO. 2

ROAD AND DESCRIPTION Mount Airy - MD Route 27 1500' SOUTH OF
PENN SHOP ROAD

SIZE OF LOT 2.07 ACRES TYPE BLDG. RES 3BR
NUMBER OF BEDROOMS

IF NOT SINGLE RESIDENCE DESCRIBE _____

THE SYSTEM INSTALLED UNDER THIS APPLICATION IS ACCEPTABLE ONLY UNTIL PUBLIC FACILITIES BECOME AVAILABLE.

SIGNATURE OF APPLICANT Donnie B Clemente / DBC

APPROVED BY _____ FOR _____ DATE _____
(KIND OF SYSTEM)


REJECTED BY Frank Skinner FOR any DATE 7/22/77
(KIND OF SYSTEM)

HOLD PENDING FURTHER TESTS _____ DATE _____

REASONS FOR REJECTION OR HOLDING poor soil type; insufficient depth of filterable
soil; house site questionable and below area tested T.S.

THIS IS NOT A PERMIT

All holes except ①

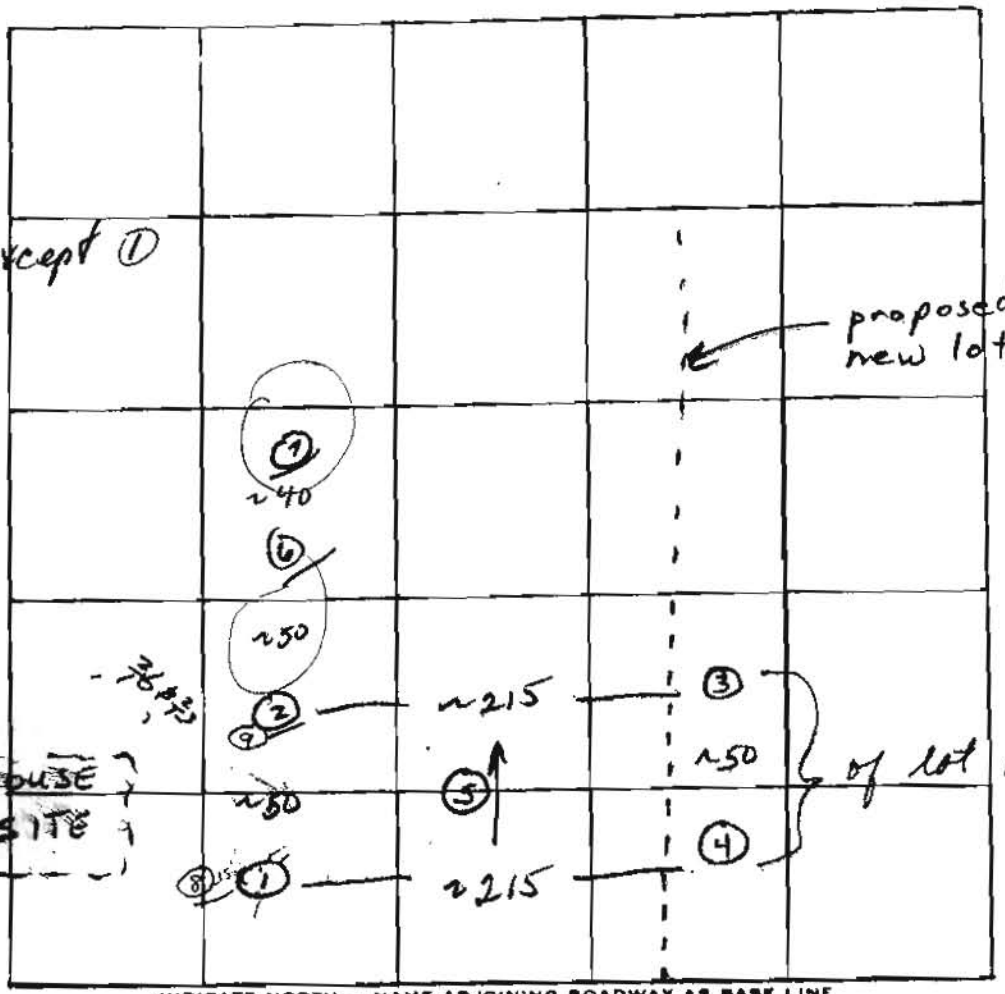

INDICATE NORTH. - NAME ADJOINING ROADWAY AS BASE LINE
RT 27

DATE	TEST NO.	DEPTH	PRE-WET		TEST - 1" DROP		TIME	
			START	STOP	START	STOP		
5/24/77	1	3 3/4'	12:17					
	1-A	10 1/2'	12:11	12:13	12:13	12:19	6	
	②	3 1/2'	12:39	12:56	12:56	2:45	49	
	2-A	9 1/2'	12:28	12:32	12:32	12:40	8	
	3							
	3-A							
	4							
	4-A							
	5	10'	VISUAL; SIMILAR; DRY					
	⑥	4'	Solid Rock					
	⑦	5 1/2'	Solid Rock					
7/2/77	⑧	4'	2:30	pulled up 3:00 1" drop			FAILS	
	8A	10'	Visual	harder in depth				
	9	5 1/2'	2:45	3:00	3:00	3:24	24min	
	8B	5 1/4'	3:12	3:27	3:27	3:48	21min	

FAILED

Doug Burrell also present

REMARKS 3,4 shown were Lot 1 tests; tests for this lot would have been
 TYPE OF SOIL 20' to the side; determined that these 2 holes need not be
 TESTED BY WWZ ALSO PRESENT: Srik + Co re-deg

APPLICATION

A 25334

SEWAGE DISPOSAL TESTING

P _____

STATE OF MARYLAND - DEPARTMENT OF HEALTH AND MENTAL HYGIENE

HOWARD COUNTY HEALTH DEPARTMENT
ENVIRONMENTAL HEALTH SERVICES
P. O. BOX 476, ELLICOTT CITY, MARYLAND 21043
TELEPHONE: 465-5000, EXT. 356

DISTRICT 4

DATE 3/1/77

TO: THE COUNTY HEALTH OFFICER
ELLICOTT CITY, MARYLAND

I, HEREBY, APPLY FOR THE NECESSARY TEST IN ORDER TO CONSTRUCT (OR RECONSTRUCT) A SEWAGE DISPOSAL SYSTEM.

PROPERTY OWNER BENJAMIN F. CLEMENTS + DONNIE B.

ADDRESS P.O. Box 355 Mt-Airy, Md. 21771 PHONE 829-2257

PROPERTY LOCATION:

SUBDIVISION _____ LOT NO. 3

ROAD AND DESCRIPTION MOUNT AIRY - MD ROUTE 27 - 1500' SOUTH OF
PENN SHOP ROAD

SIZE OF LOT 1.89 ACRES TYPE BLDG. RES - 3 BR.
NUMBER OF BEDROOMS

IF NOT SINGLE RESIDENCE DESCRIBE _____

THE SYSTEM INSTALLED UNDER THIS APPLICATION IS ACCEPTABLE ONLY UNTIL PUBLIC FACILITIES BECOME AVAILABLE.

SIGNATURE OF APPLICANT Donnie B Clements / DJB

APPROVED BY _____ FOR _____ DATE _____
(KIND OF SYSTEM)

REJECTED BY _____ FOR _____ DATE _____
(KIND OF SYSTEM)

HOLD PENDING FURTHER TESTS _____ DATE _____

REASONS FOR REJECTION OR HOLDING _____

THIS IS NOT A PERMIT

5/4/77
9:30 a.m.

INDICATE NORTH. - NAME ADJOINING ROADWAY AS BASE LINE.

DATE	TEST NO.	DEPTH	PRE-WET		TEST - 1" DROP		TIME
			START	STOP	START	STOP	

REMARKS _____

TYPE OF SOIL _____

TESTED BY _____ ALSO PRESENT: _____

Visited Site 2:00 pm 5/4/99

observed location of holes

needs. look level on site lot 2

probable water low holes lot 3, and possibly 2.

1999