



Building Permit Application

Howard County Maryland
Department of Inspections, Licenses and Permits
3430 Court House Drive
Permits: 410-313-2455
www.howardcountymd.gov

Date Received: _____

Permit No. _____

Building Address: 14817 Burntwoods Rd
 City: Glenwood State: MD Zip Code: 21738
 Suite/Apt # _____ SOP/WP/BA #: _____
 Census Tract: _____ Subdivision: _____
 Section: _____ Area: _____ Lot: 32
 Tax Map: 0021 Parcel: 0189 Grid: 0004
 Zoning: _____ Map Coordinates: _____ Lot Size: 3.35AC

Existing Use: SEH
 Proposed Use: SEH
 Estimated Construction Cost: \$ 36,000
 Description of Work: Construct enclosure on existing foundation 19'x08'

Occupant/Tenant Name: _____
 Was tenant space previously occupied? Yes No
 Contact Name: _____
 Address: _____
 City: _____ State: _____ Zip Code: _____
 Phone: _____ Fax: _____
 Email: _____

Property Owner's Name: Pamela Bythrew
 Address: 14817 Burntwoods Rd
 City: Glenwood State: MD Zip Code: 21738
 Phone: _____ Fax: _____
 Email: _____

Applicant's Name & Mailing Address (if other than stated herein)
 Applicant's Name: Candace Reed
 Address: 3516 Ashby Ct
 City: Woodbridge State: VA Zip Code: 22192
 Phone: 703-944-0530 Fax: _____
 Email: ctp@pepperline.com

Contractor Company: Great Day Improvements
 Contact Person: _____
 Address: 501 McCormick Dr Ste D-F
 City: Glen Burnie State: MD Zip Code: 21061
 License No.: 132308
 Phone: 410-760-1919 Fax: _____
 Email: _____

Engineer/Architect Company: _____
 Responsible Design Prof.: _____
 Address: _____
 City: _____ State: _____ Zip Code: _____
 Phone: _____ Fax: _____
 Email: _____

Commercial Building Characteristics	Residential Building Characteristics	
Height:	<input type="checkbox"/> SF Dwelling <input type="checkbox"/> SF Townhouse	
No. of stories	Depth	Width
Gross area, sq. ft./floor:	1 st floor:	
	2 nd floor:	
Area of construction (sq. ft.):	Basement:	
	<input type="checkbox"/> Finished Basement	
Use group:	<input type="checkbox"/> Unfinished Basement	
	<input type="checkbox"/> Crawl Space	
	<input type="checkbox"/> Slab on Grade	
Construction type:	No. of Bedrooms:	
<input type="checkbox"/> Reinforced Concrete	<u>Multi-family Dwelling</u>	
<input type="checkbox"/> Structural Steel	No. of efficiency units:	
<input type="checkbox"/> Masonry	No. of 1 BR units:	
<input type="checkbox"/> Wood Frame	No. of 2 BR units:	
<input type="checkbox"/> State Certified Modular	No. of 3 BR units:	
	Other Structure:	
	Dimensions:	
<input checked="" type="checkbox"/> Roadside Tree Project Permit	Footings:	
<input type="checkbox"/> Yes <input type="checkbox"/> No	Roof:	
Roadside Tree Project Permit # _____	<input type="checkbox"/> State Certified Modular	
	<input type="checkbox"/> Manufactured Home	

Utilities	
Electric:	<input checked="" type="checkbox"/> Yes <input type="checkbox"/> No
Gas:	<input checked="" type="checkbox"/> Yes <input type="checkbox"/> No
Water Supply	
<input type="checkbox"/> Public	
<input checked="" type="checkbox"/> Private	
Sewer Disposal	
<input type="checkbox"/> Public	
<input checked="" type="checkbox"/> Private	
Heating System	
<input type="checkbox"/> Electric	<input type="checkbox"/> Oil
<input type="checkbox"/> Natural Gas	<input type="checkbox"/> Propane Gas
<input type="checkbox"/> Other:	
Sprinkler System:	
<input checked="" type="checkbox"/> Yes	<input type="checkbox"/> No
Grading Permit Number: _____	
Building Shell Permit Number: _____	

THE UNDERSIGNED HEREBY CERTIFIES AND AGREES AS FOLLOWS: (1) THAT HE/SHE IS AUTHORIZED TO MAKE THIS APPLICATION; (2) THAT THE INFORMATION IS CORRECT; (3) THAT HE/SHE WILL COMPLY WITH ALL REGULATIONS OF HOWARD COUNTY WHICH ARE APPLICABLE THERETO; (4) THAT HE/SHE WILL PERSONALLY NO WORK ON THE ABOVE REFERENCED PROPERTY NOT SPECIFICALLY DESCRIBED IN THIS APPLICATION; (5) THAT HE/SHE GRANTS COUNTY OFFICIALS THE RIGHT TO ENTER ONTO HIS PROPERTY FOR THE PURPOSE OF INSPECTING THE WORK PERMITTED AND POSTING NOTICES

Candace Reed
 Applicant's Signature
ctp@pepperline.com
 Email Address

 Title/Company

Candace Reed
 Print Name
12/15/17
 Date

Checks Payable to: DIRECTOR OF FINANCE OF HOWARD COUNTY
 PLEASE WRITE NEATLY & LEGIBLY
 -FOR OFFICE USE ONLY-

AGENCY	DATE	SIGNATURE OF APPROVAL
State Highways		
Building Officials		
PSZA (Zoning)		
PSZA (Engineering)		
Health	<u>12/15/17 H. OSWALD</u>	

Is Sediment Control approval required for issuance? Yes No
 CONTINGENCY CONSTRUCTION START

DPZ SETBACK INFORMATION	
Front:	
Rear:	
Side:	
Side St.:	
All minimum setbacks met?	<input type="checkbox"/> Yes <input type="checkbox"/> No
Is Entrance Permit Required?	<input type="checkbox"/> Yes <input type="checkbox"/> No
Historic District?	<input type="checkbox"/> Yes <input type="checkbox"/> No
Lot Coverage for New Town Zone:	
SDP/Red-line approval date:	

Filing Fee	\$
Permit Fee	\$
Tech Fee	\$
Excise Tax	\$
PSFS	\$
Guaranty Fund	\$
Add'l per Fee	\$
Total Fees	\$
Sub-Total Paid	\$
Balance Due	\$
Check	#

Property known as: LOT 32

THIS PLAT CAN NOT BE USED TO ESTABLISH PROPERTY LINES OR CORNERS.

WARFIELD ESTATES
LOTS 31 & 32 RESUB. LOTS 13 & 14
SECTION SEVEN PLAT 4310
4TH ELECTION DISTRICT
HOWARD CO. MD

SCALE 1"=100'

BURNWOODS ROAD

APPROVED


WALK-THRU BUILDING PERMIT

BP# _____ A# _____

APP. SAN A. O'Connell DATE: 12/14/17


DESC. OF WORK: Construct 19' x 8'

sunroom enclosure on existing
foundation.

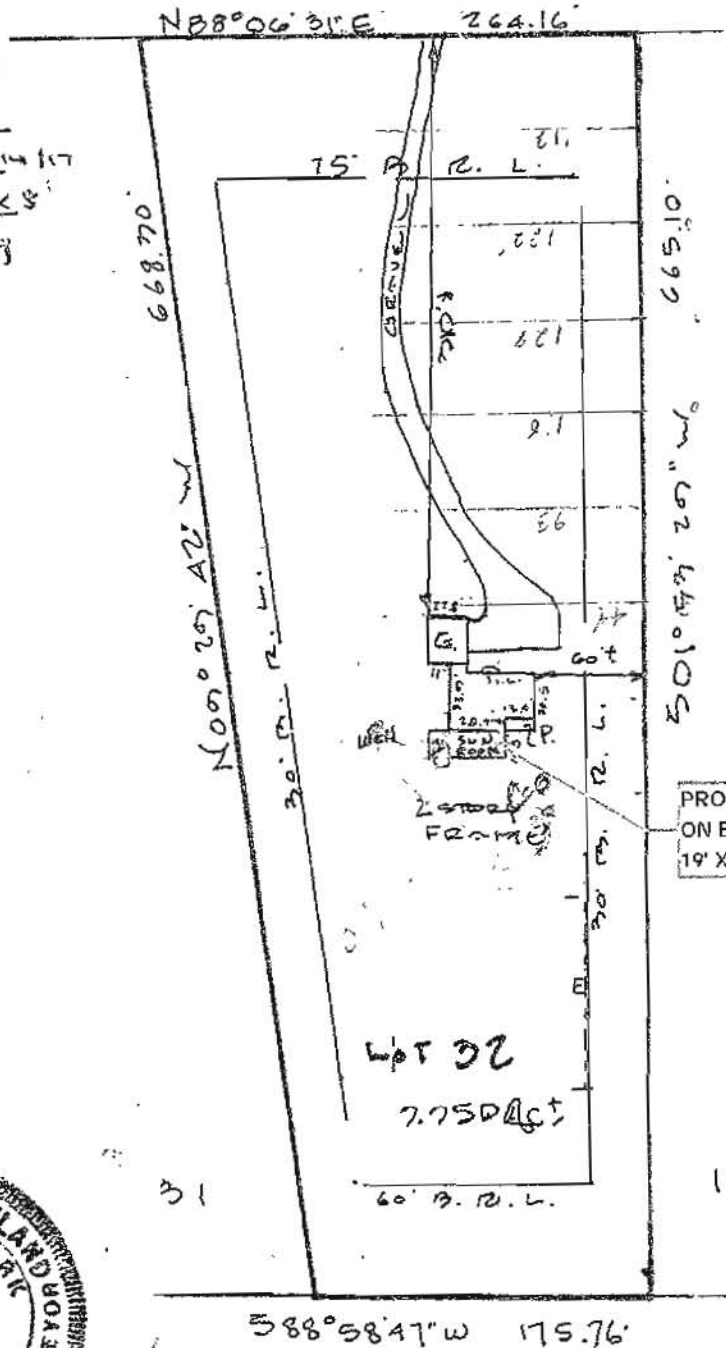

Walter Park

DRAWING TO SCALE IF THIS DIMENSION MEASURES 3"

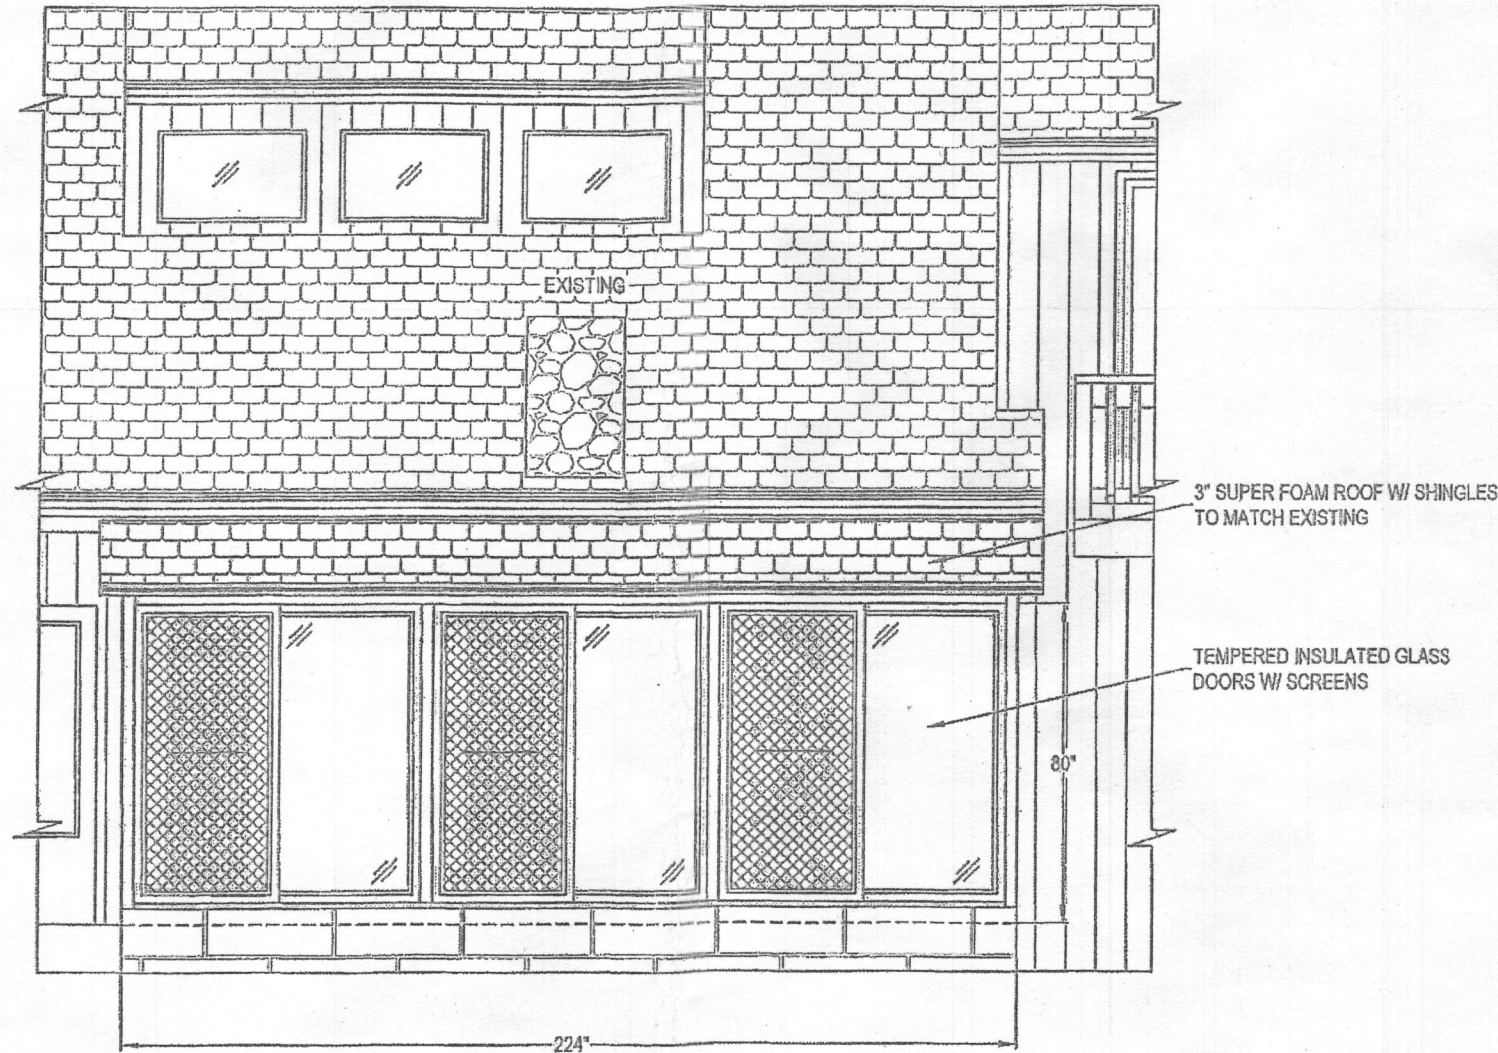

ELEVATION - "B" WALL

MINIMUM DESIGN LOADS: (PER 2015 IRC)

SUNROOM CATEGORY II (PER 2015 IRC R301.2.1.1.1 & AAMA / NPEA / NSA 2100))

SNOW LOADS:

- 1. GROUND SNOW LOAD 30 PSF

ULTIMATE DESIGN WIND SPEED: 115 MPH, 3 SEC. GUSTS

LIVE LOADS:

- 1. ROOF: 20 PSF
- 2. FLOOR: 40 PSF

NOTE: THIS ENCLOSURE IS NOT TO BE CONDITIONED OR USED AS A PERMANENT LIVING AREA.


NOTES:

- 1. ALLVIEW (CA5) ROOM; BRONZE IN COLOR
- 2. CONSTRUCT ENCLOSURE ON EXISTING FOUNDATION
- 3. NO HEAT BY GDI, ELECTRICAL BY GDI
- 4. ROOM CONSIDERED AS NON-CONDITIONED SPACE, EXEMPT FROM ENERGY REQUIREMENTS (PER 2015 IRC SECTION N1102.1, NOTE 2)

PROFESSIONAL CERTIFICATION. I HEREBY CERTIFY THAT THESE DOCUMENTS WERE PREPARED OR APPROVED BY ME, AND THAT I AM A DULY LICENSED PROFESSIONAL ENGINEER UNDER THE LAWS OF THE STATE OF MARYLAND. LICENSED NUMBER 31585, EXPIRATION DATE 7/18/2019

NOTE:

THE P.E. STAMP ON THESE DRAWINGS ADDRESSES THE GDI MANUFACTURED SUNROOM COMPONENTS & THE ANCHORAGE OF THESE COMPONENTS TO THE SURROUNDING STRUCTURE.

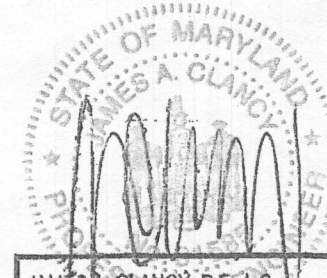

JAMES A. CLANCY, P.E., L.S.
 MD PROFESSIONAL ENGINEER (MD LIC. # 31585)
 24 HARVEST DRIVE
 PITTSBORO, N.J. 08918
 PH. # 856-853-7306




LOCATION
 GDI - BALTIMORE
 501 MCCORMICK DRIVE, SUITES D-F
 GLEN BURNIE, MD 21061
 410-760-1919

PAM BYTHROW
 14817 BURNWOODS ROAD
 GLENWOOD, MD. 21738
 JOB #40168


REV. A	12/18/17		
DATE	12/11/17		
DRAWN	VNG		
SCALE	1/4" = 1'-0"		
SHEET	1 OF 4		

THIS DRAWING IS PROPERTY OF GREAT DAY IMPROVEMENTS, LLC., AND DUPLICATION OF THIS DRAWING WITHOUT OUR EXPRESSED WRITTEN CONSENT IS PROHIBITED. ALL RIGHTS RESERVED.

DRAWING TO SCALE IF THIS DIMENSION MEASURES 3"

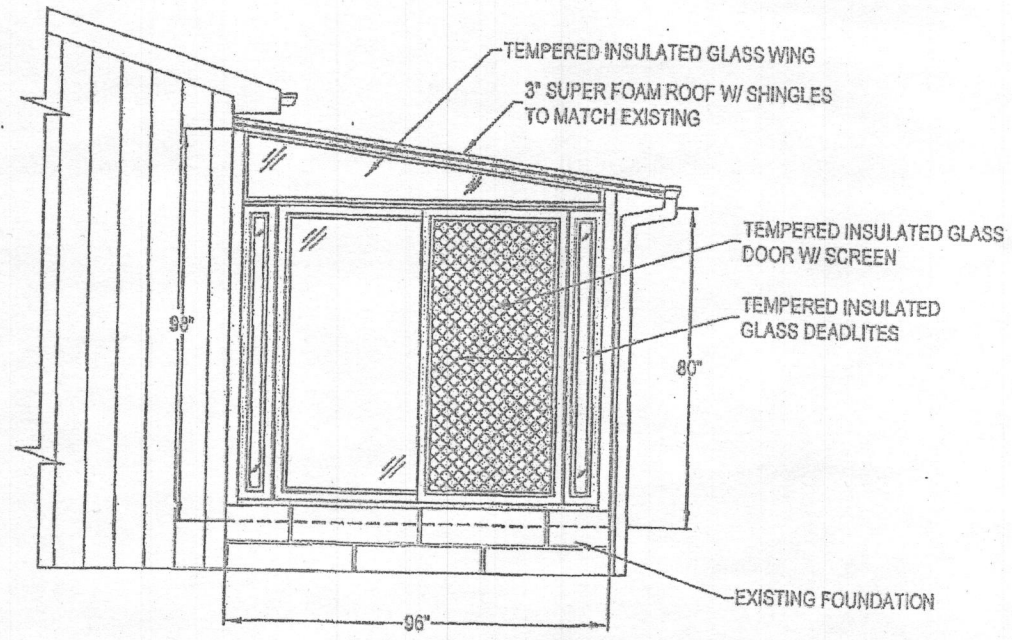


ELEVATION - "A" WALL

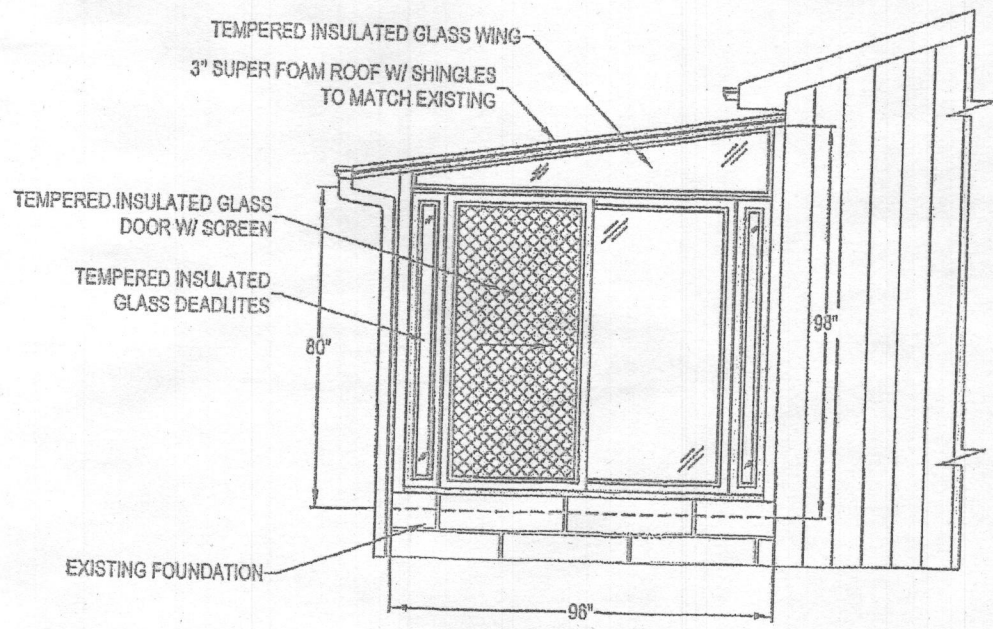

ELEVATION - "C" WALL

LOCATION
 GDI - BALTIMORE
 501 McCORMICK DRIVE, SUITES D-F
 GLEN BURNIE, MD 21061
 410-760-1919

PAM BYTHROW
 14817 BURNTWOODS ROAD
 GLENWOOD, MD. 21738
 JOB #40168

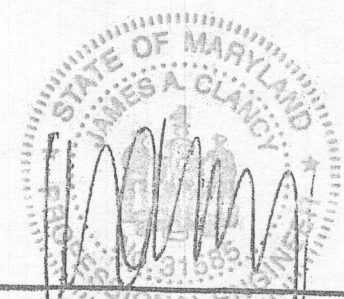

JAMES A. CLANCY, P.E., I.S.
 MD PROFESSIONAL ENGINEER (MD LIC. # 31565)
 24 HARVEST DRIVE
 PITTSBORO, NJ. 08318
 PH. # 856-853-7306

REV. A	12/8/17
DATE	12/1/17
DRAWN	VNG
SCALE	1/4" = 1'-0"
SHEET	2 OF 4

THIS DRAWING IS PROPERTY OF GREAT DAY IMPROVEMENTS, LLC., AND DUPLICATION OF THIS DRAWING WITHOUT OUR EXPRESSED WRITTEN CONSENT IS PROHIBITED. ALL RIGHTS RESERVED.