

**Bureau of Environmental Health**  
 8930 Stanford Boulevard, Columbia, MD 21045  
 Main: 410-313-2640 | Fax: 410-313-2648  
 TDD 410-313-2323 | Toll Free 1-866-313-6300  
[www.hchealth.org](http://www.hchealth.org)  
 Facebook: [www.facebook.com/hocohealth](http://www.facebook.com/hocohealth)

Maura J. Rossman, M.D., Health Officer

RECEIPT DATE: 10/4/17

**ONSITE SEWAGE DISPOSAL SYSTEM**

P 561542

INSTALLATION

APPROVAL DATE: 10/18/17 (SEC)

**PERMIT**

A \_\_\_\_\_

**MINOR REPAIR**

PROPERTY ADDRESS: 2135 Route 97

SUBDIVISION: \_\_\_\_\_

LOT: \_\_\_\_\_ TAX ID: 04-357299

marcdherethconstruction@gmail

CONTRACTOR: Marc D. Hereth

EMAIL: .com

CONTRACTOR ADDRESS: 2551 Florence Road, Woodbine, MD 21797

PHONE: \_\_\_\_\_

PROPERTY OWNER: David and Melissa Covelesky

EMAIL: \_\_\_\_\_

OWNER ADDRESS: 2135 Route 97, Cooksville, MD 21723

PHONE: \_\_\_\_\_

NUMBER OF BEDROOMS: 4 SEPTIC TANK SIZE: 1,500 gal DRAINFIELD SIZE/TYPE: \_\_\_\_\_

LOCATION:	
NOTES:	Set new 1,500-gal, 2 compartment, slotted tank. Install 1x70' trench on contour, 3' wide, 4' inlet, 10' depth. Install observation port at trench end perforated through stone. System sized for 5 BR.

ISSUED BY: Sarah Collins

ISSUE DATE: 10/16/17

EXPIRATION DATE: 10/16/18


NOTE: CONTRACTOR MUST SCHEDULE AN INSPECTION AND GAIN APPROVAL OF ALL COMPONENTS PRIOR TO COVERING

NOTE: AN ELECTRICAL PERMIT IS REQUIRED FOR INSTALLATION OF ANY ELECTRICAL COMPONENTS OF THE SYSTEM

NOTE: MDE RECOMMENDS SEPTIC TANKS, BAT, AND OTHER PRETREATMENT UNITS BE PUMPED AT A FREQUENCY ADEQUATE TO ENSURE THAT SOLIDS ARE NOT DISCHARGED TO THE DISPOSAL AREA

**NEITHER THE HOWARD COUNTY COUNCIL NOR THE HEALTH DEPARTMENT IS RESPONSIBLE FOR THE SUCCESSFUL OPERATION OF ANY SYSTEM. PERMITTEE RESPONSIBLE FOR OBTAINING FINAL APPROVAL ON THIS PERMIT. CALL 410-313-1771 FOR INSPECTION OF SEPTIC SYSTEM.**

NOT TO SCALE

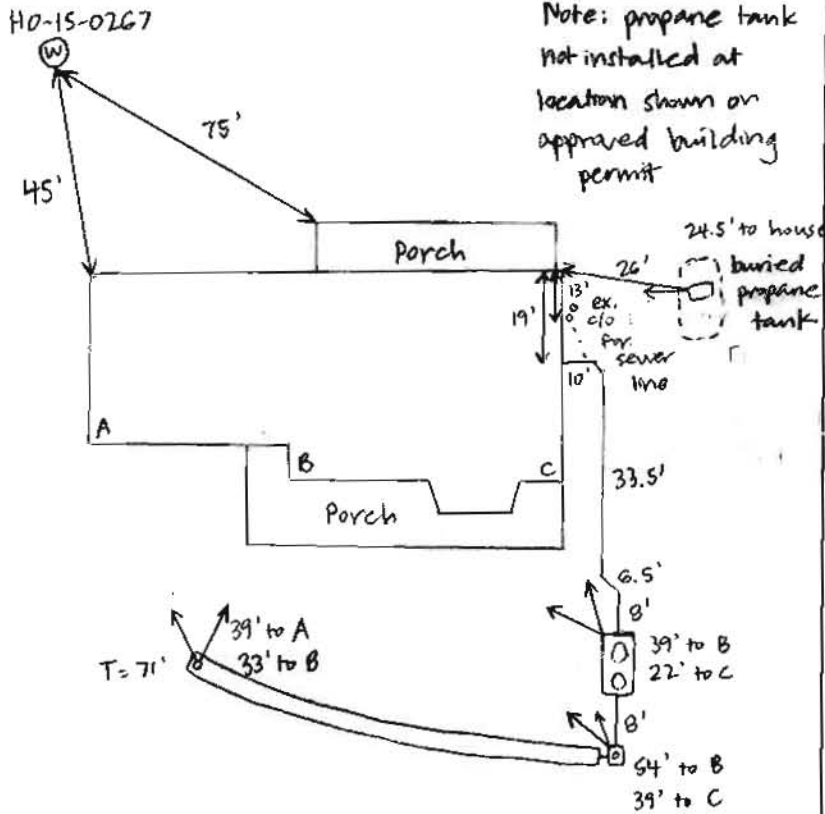

Note: propane tank not installed at location shown on approved building permit

**TRENCH/DRAINFIELD DATA**

WIDTH	INLET	BOTTOM
3'	4'	10'
NUMBER OF TRENCHES		1
TOTAL LENGTH		71'
ABSORPTION AREA		213' + SIDEWALK
DISTRIBUTION BOX LEVEL		YES
DISTRIBUTION BOX BAFFLE		YES
DISTRIBUTION BOX PORT		YES

**SEPTIC TANK DATA**

SEPTIC TANK I LEVEL	YES
MANUFACTURER	BABYLON
CAPACITY	1500 GAL
SEAM LOC	TDP
TANK LID DEPTH	1-1.5'
BAFFLES	YES
BAFFLE FILTER	NO
MANHOLE LOC	FRONT + REAR
6" PORT LOC	NONE
WATERTIGHT TEST	NO
SLOTTED	YES
DATE ON LID	9-5-17

PUMP/SEPTIC TANK LEVEL	
MANUFACTURER	
CAPACITY	GAL
SEAM LOC	
TANK LID DEPTH	
BAFFLES	
BAFFLE FILTER	
MANHOLE LOC	
6" PORT LOC	
WATERTIGHT TEST	
SLOTTED	
DATE ON LID	

ROAD NAME

**PRE-CONSTRUCTION:**

10/16/17 Laid out 1x70' trench on contour in front of the house. Use laser while digging. Trench is >100' from well. (SC)

**INSTALLATION:**

10/17/17 Marc Hereth digging trench 10' bottom, 3' wide. Using laser to check depths. (SC)  
 10/17/17 Trench complete + left open for inspection. 3.5' to stone. (SC)  
 10/18/17 on site while tank was set. No obvious cracks on bottom or sides of tank. (SC)  
 10/18/17 Tank tied in to existing line. Marc will install D-box as shallow as possible to potentially make fall to area south of tank. Line will drop down to trench. Drywell pumped, lid crushed, + filled in with dirt. (SC)

FINAL INSPECTOR

Sarah Collins

DATE OF APPROVAL

10/18/17





# HOWARD COUNTY HEALTH DEPARTMENT

61542

DATE  
10/14/17

Received From

PHONE #

For

CASH

CHECK

NO.

Dollars

\$

Received By